
 



MIDSHIP SECTION
OF
S.S.N^o 199
DIMENSIONS.

th twist Perpendiculars	200 " 0	Length per Rule	198.83
th Moulded	27 " 0	Breadth " "	27.0
in Hold	15 . 6	Depth " "	17.13
ths to Length	7 . 3	Depth to Length	11.6
for Scantling	$13.5 + 17.13 + 27.42 = 58.05 \times 198.83 = 11542 + 1154.2 = 12696.2$		
for Scantling for Raised Deck	$13.5 + 20.13 + 30.59 = 64.22$		


 100 A. Grade.

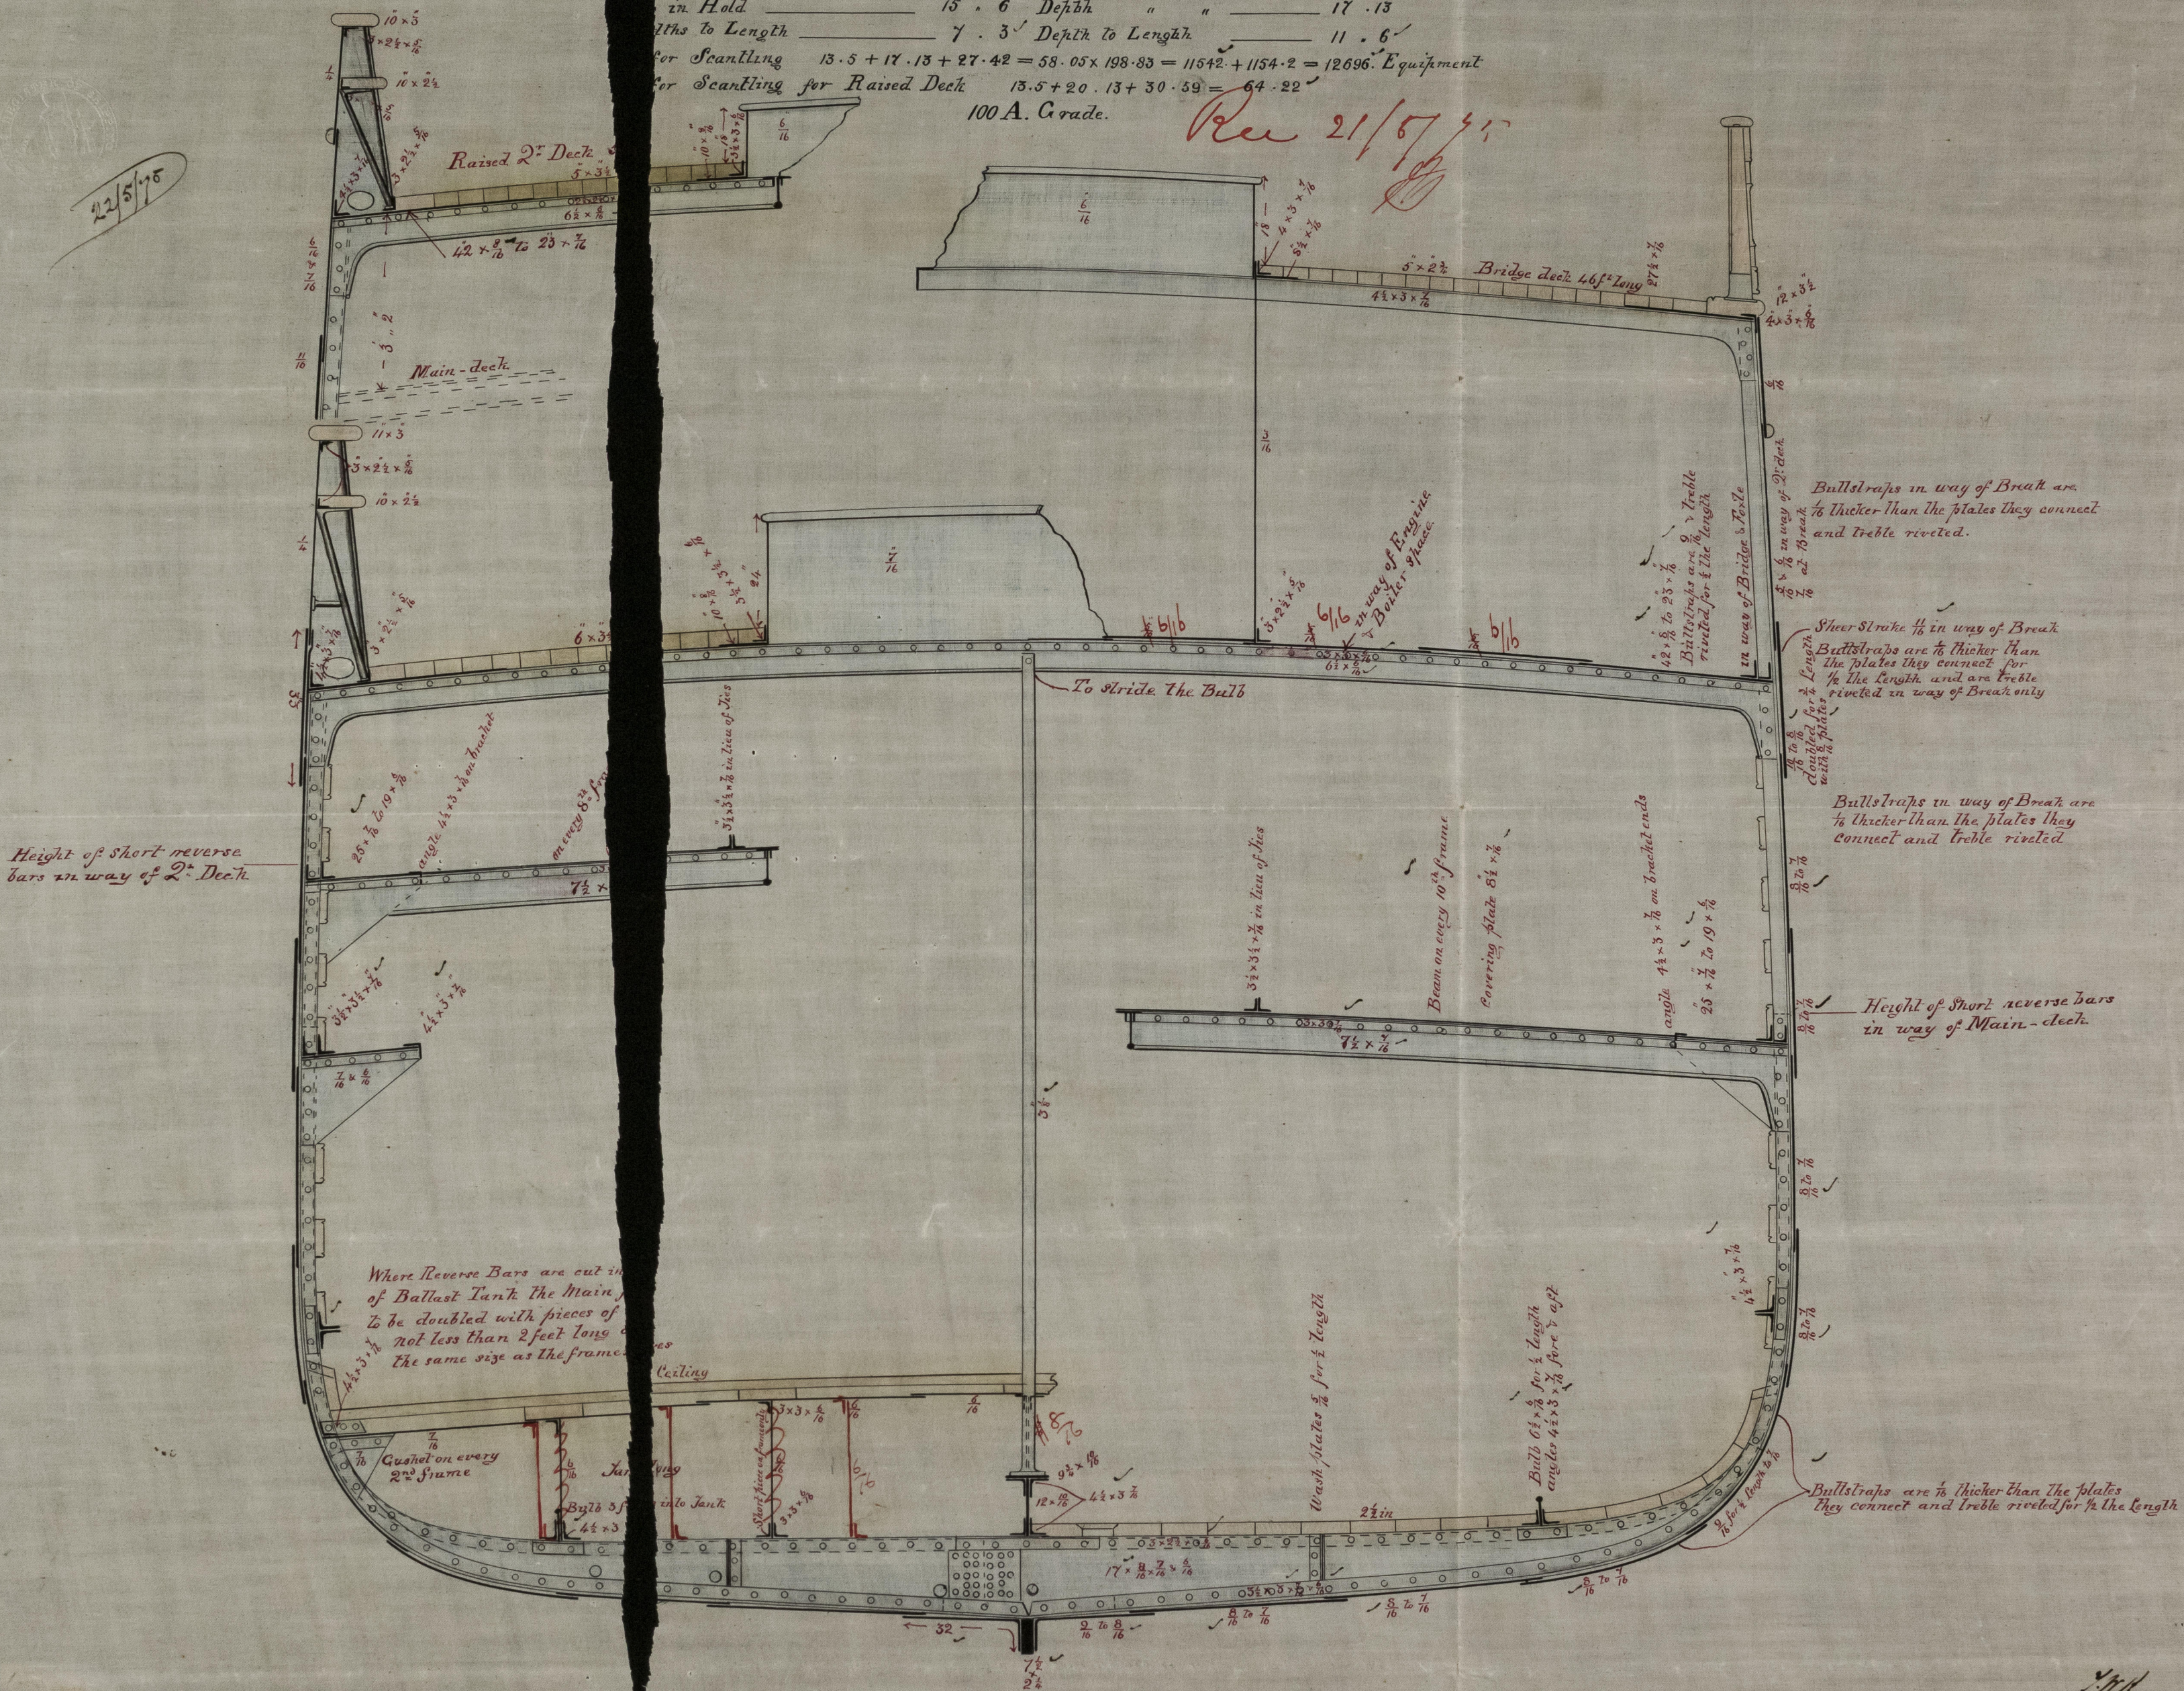

SCALE $\frac{1}{2}$ INCH TO ONE FOOT

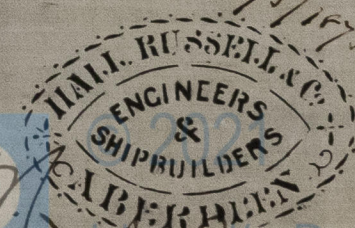

22/50

TRANS/4-0230