

*Wm. John Readhead & Co*  
*Salt Shields.*


~~Clapnet~~  
*Flying Fish - Report No 13165.*  
**PADDLE STEAMER**

*Run 3/8/75*  
*HA*

**NO 118**

SCALE  $\frac{3}{4}$  = ONE FOOT

*2/8/75*

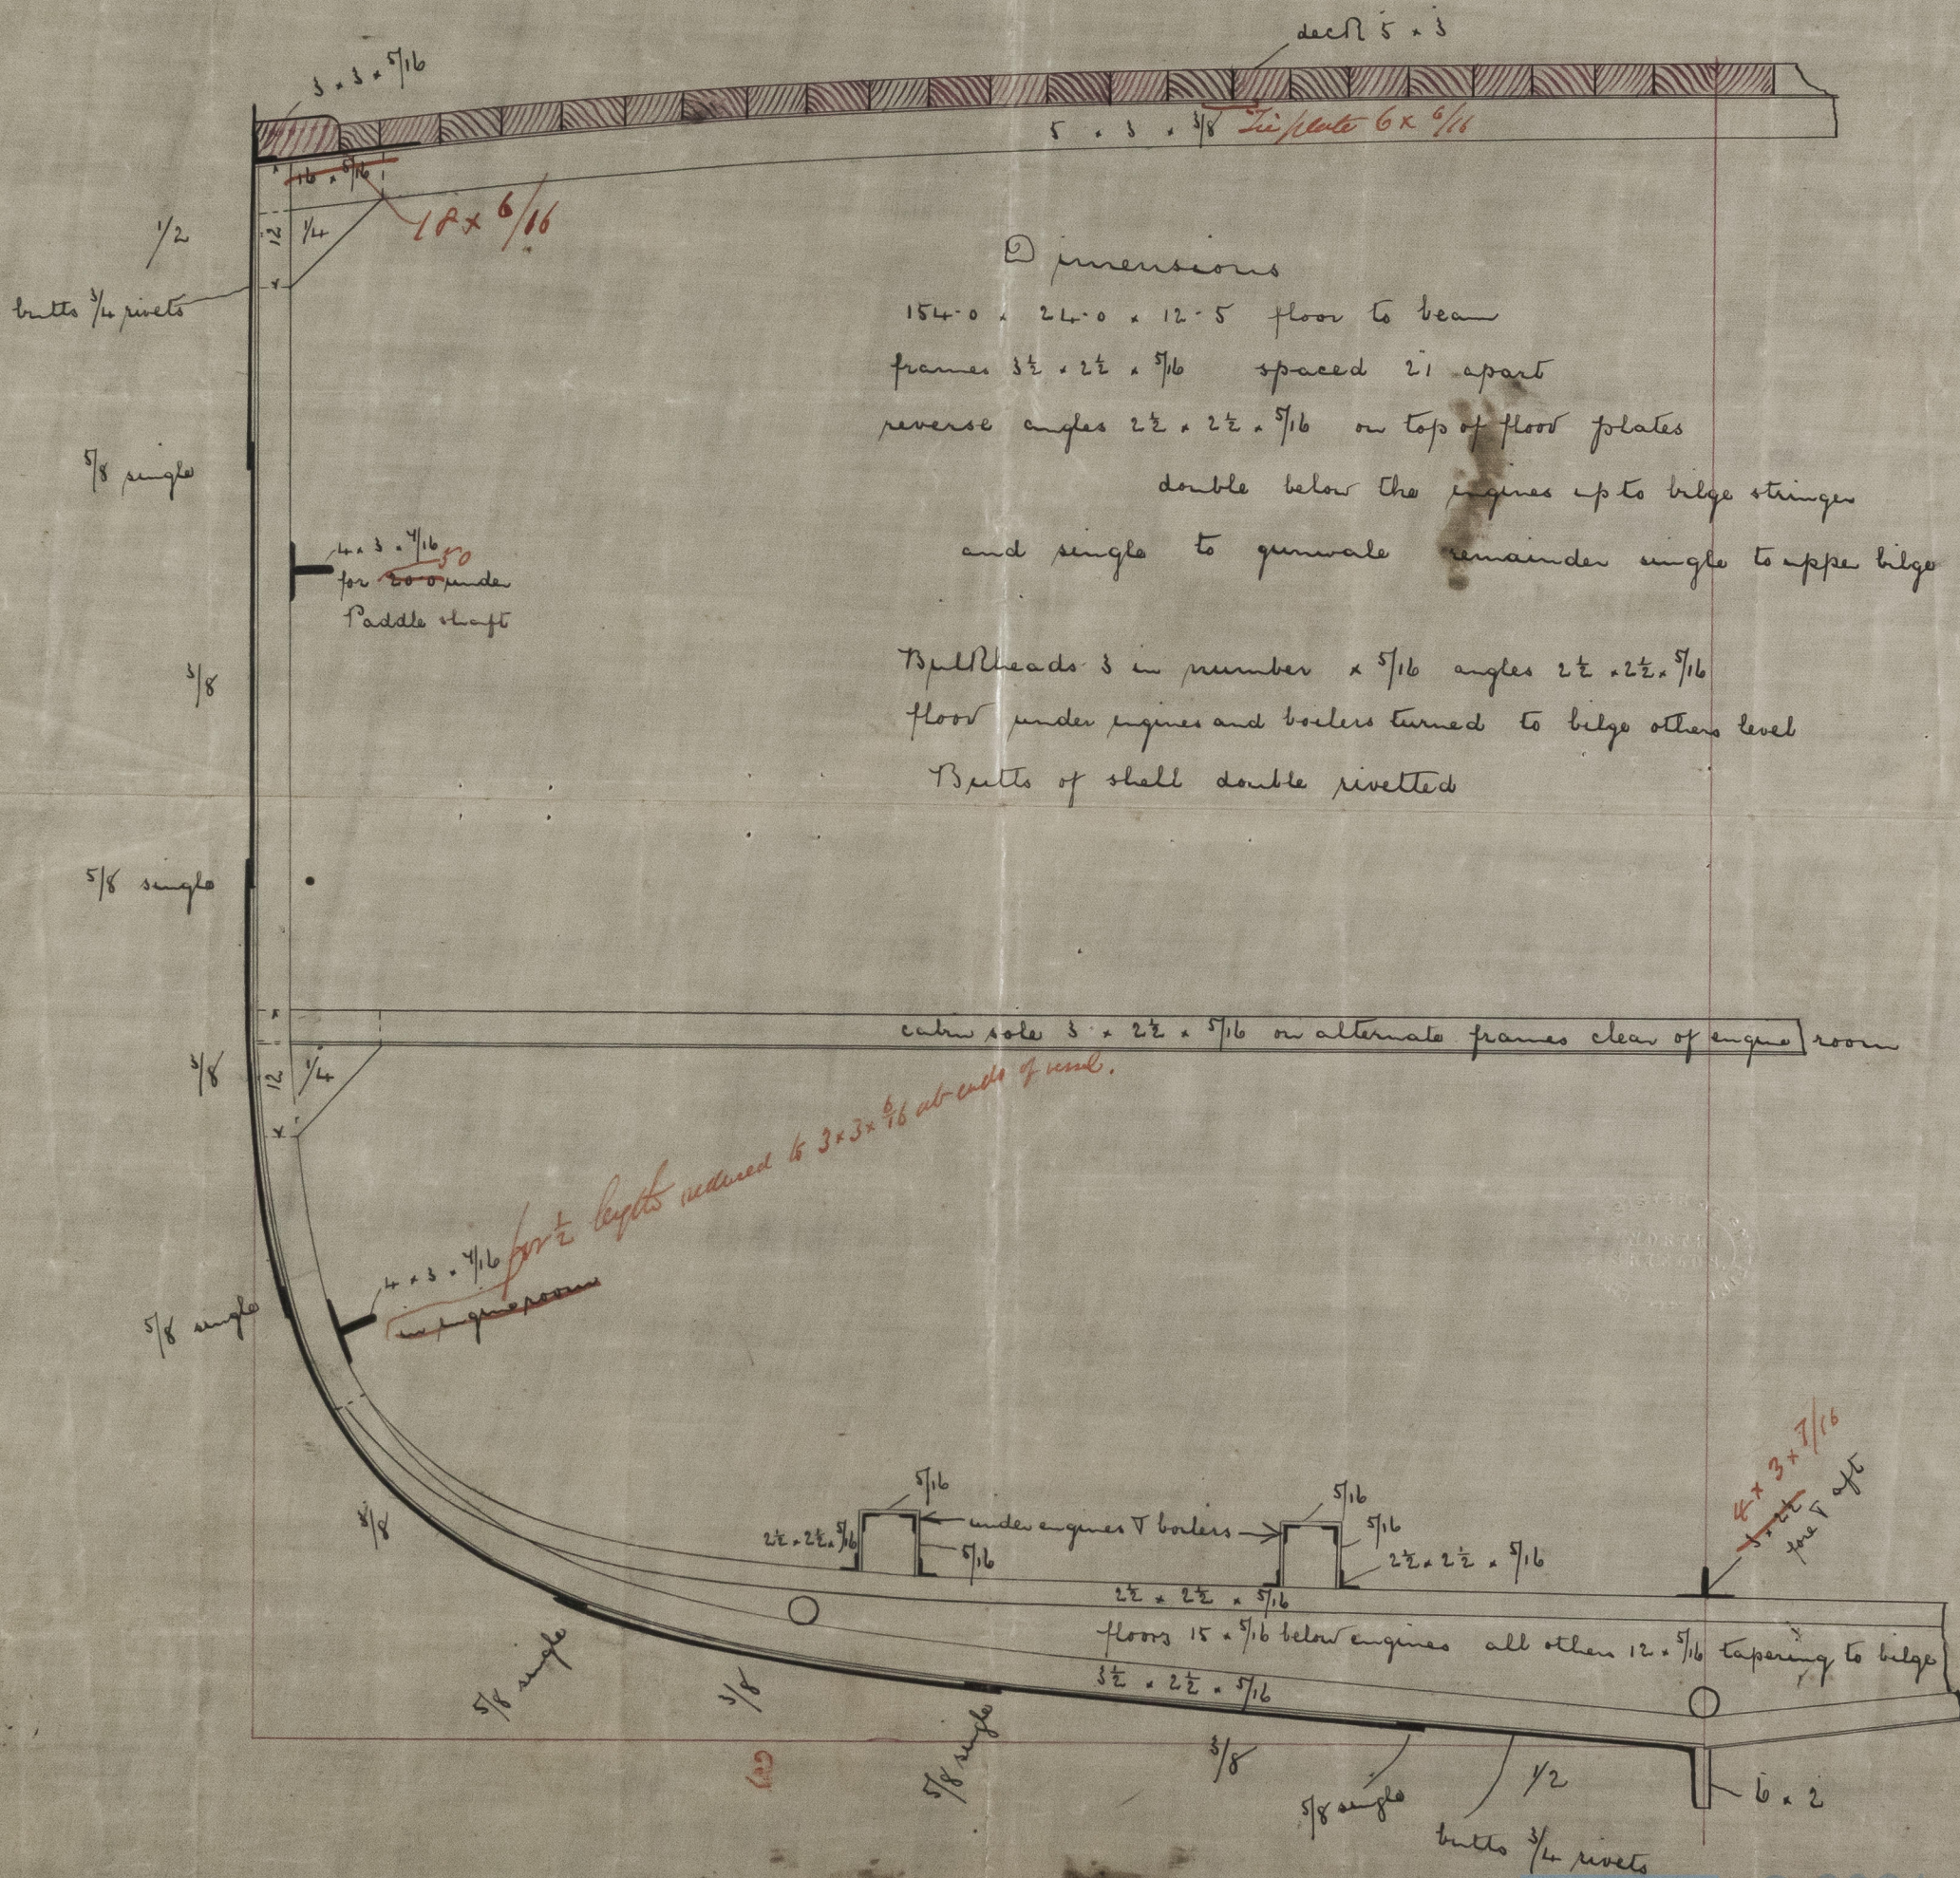

*3/8/75*



© 2021  
 Lloyd's Register  
 Foundation