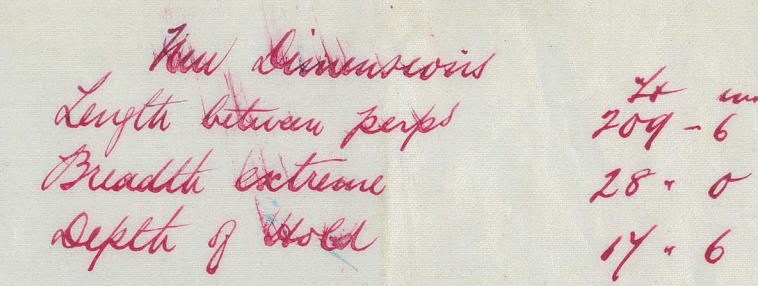

 Page & Deck Plan of 'Barrington' - Sheet No. 10179.
 Scale 1/4" = one foot.
 Recd 25/2/96
 B

10



Rec^d 19-2-76.
R.F.C.

26/2/76