


Rec 11/4/74

Erasmus Wilson

Iron 16247.

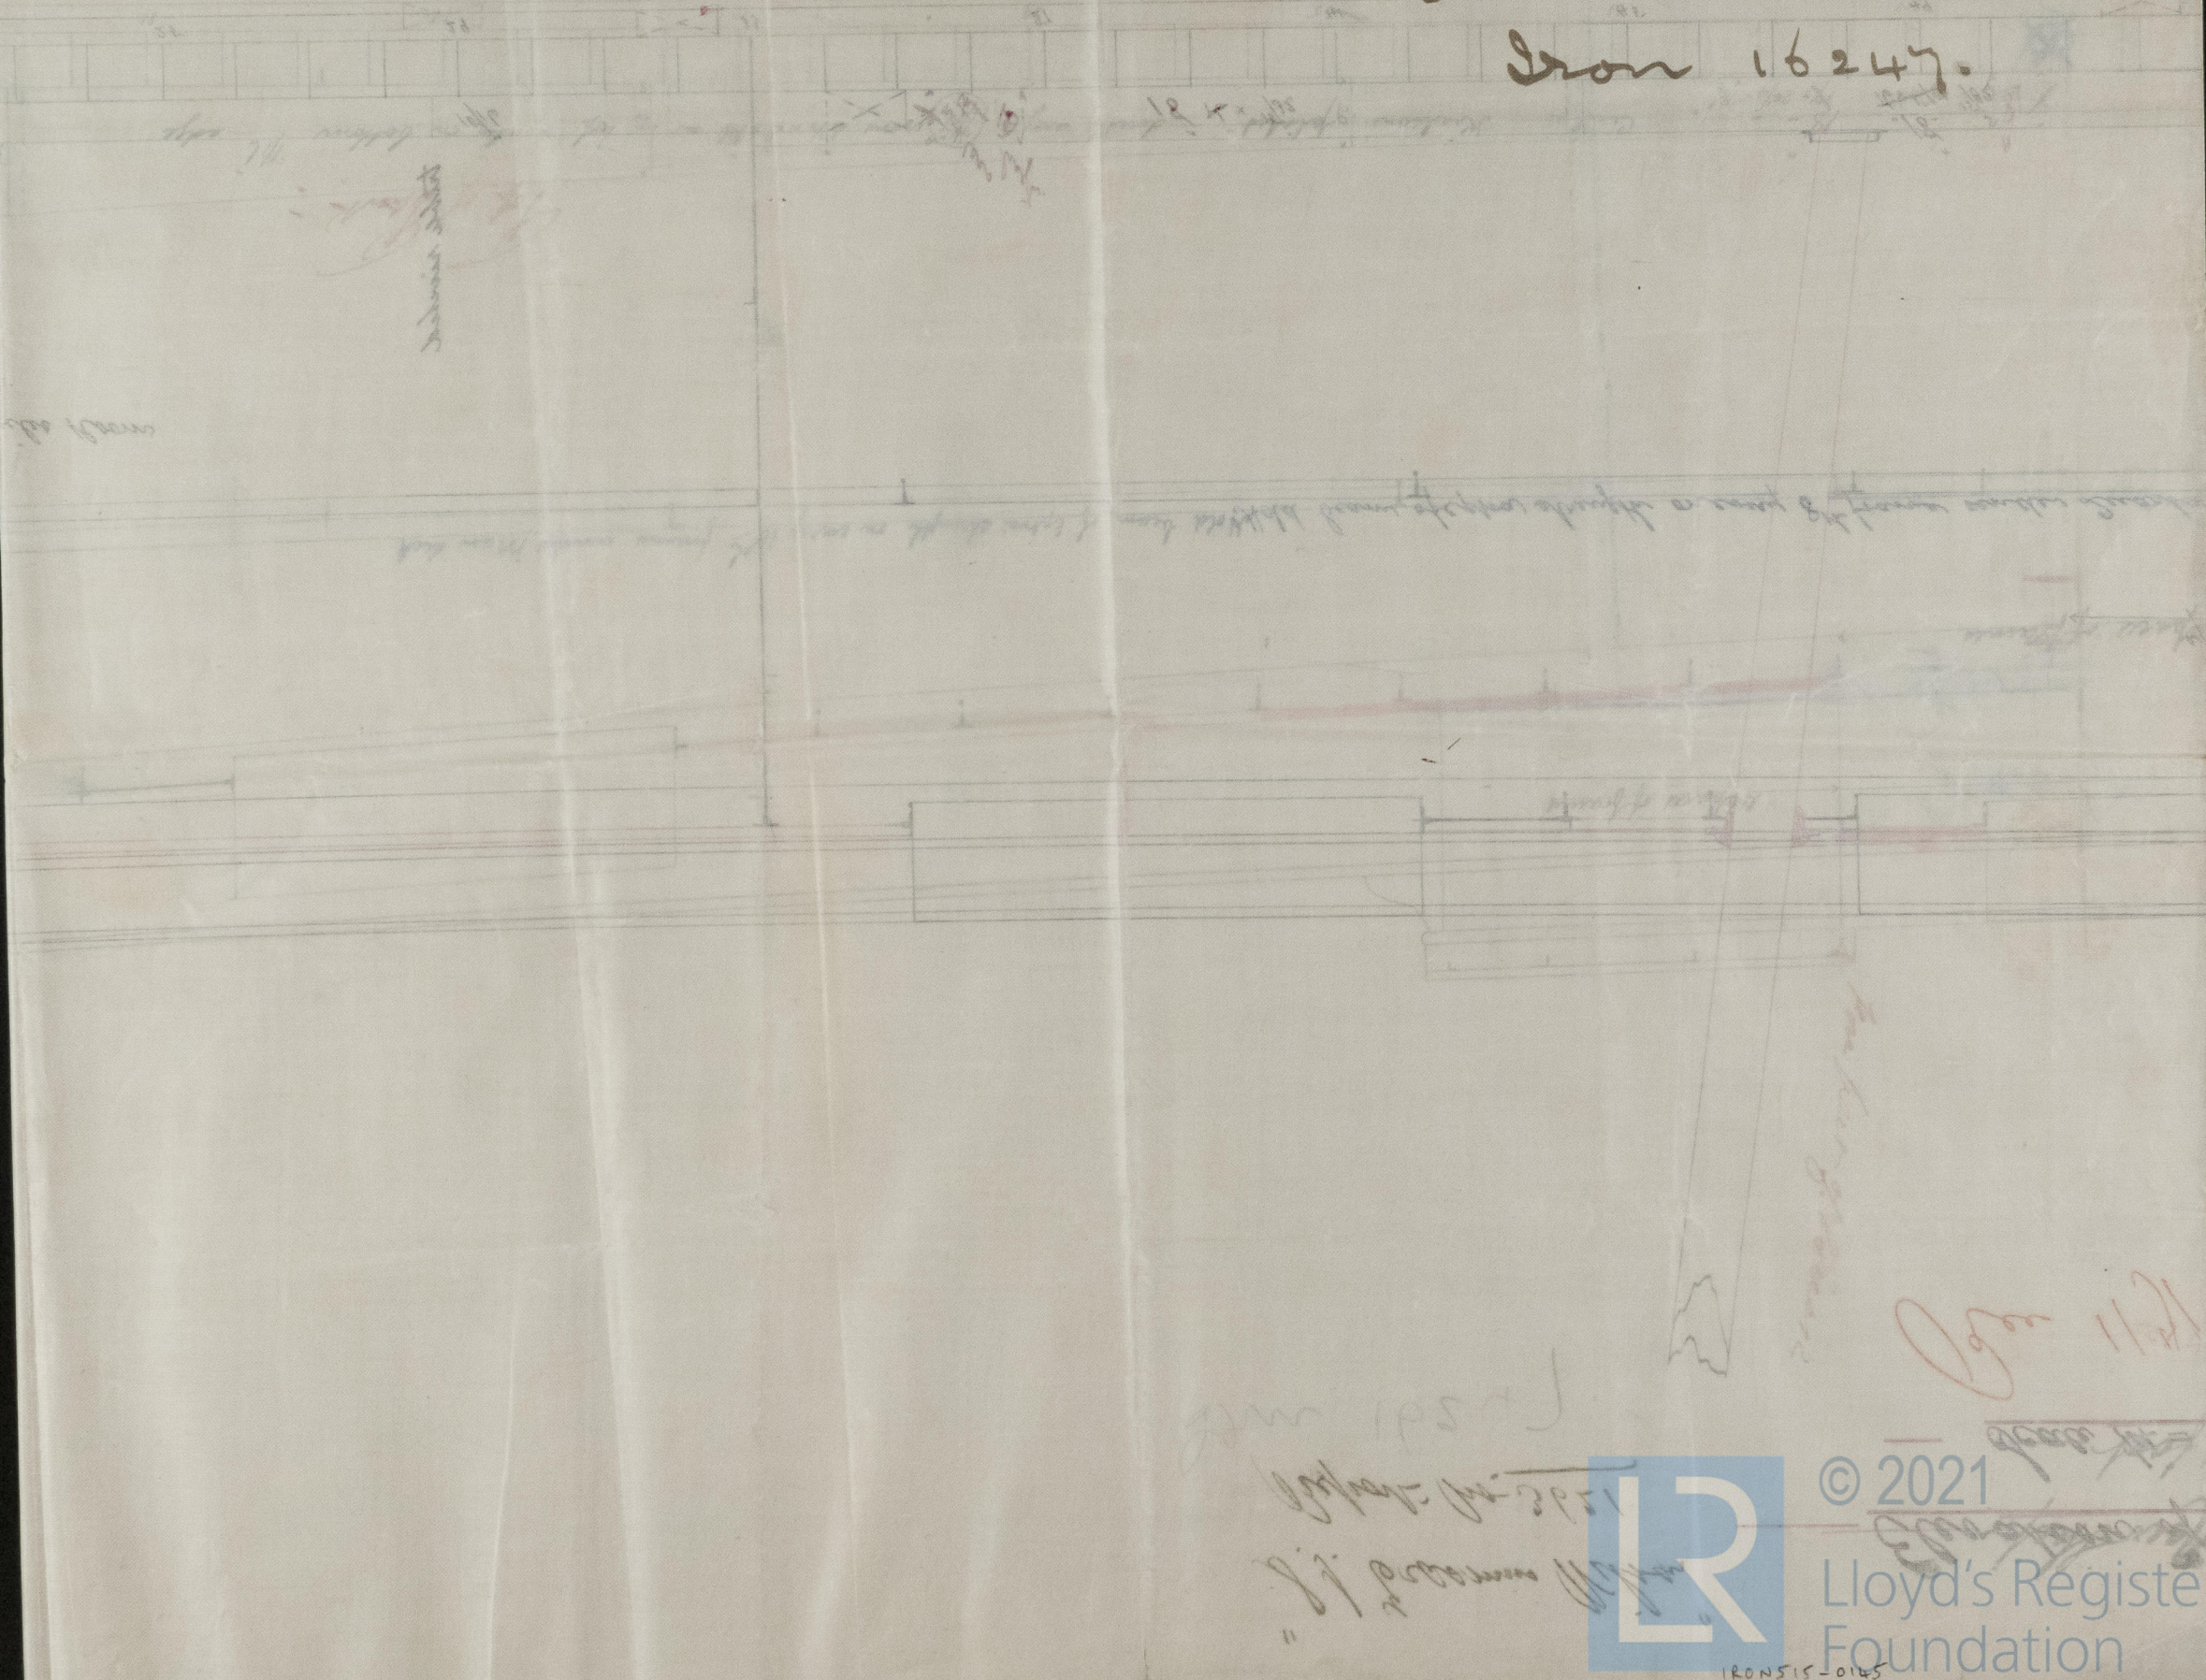

© 2021

Lloyd's Register
Foundation

IRON 515-0145