


Length B.P	200' 0"
Beam extreme	30' 0"
do Moulded	29' 10"
Depth of hold	14' 10"
do Moulded	15' 3"

Scale $\frac{1}{2}$ " = 1 foot.

Section under Main Deck

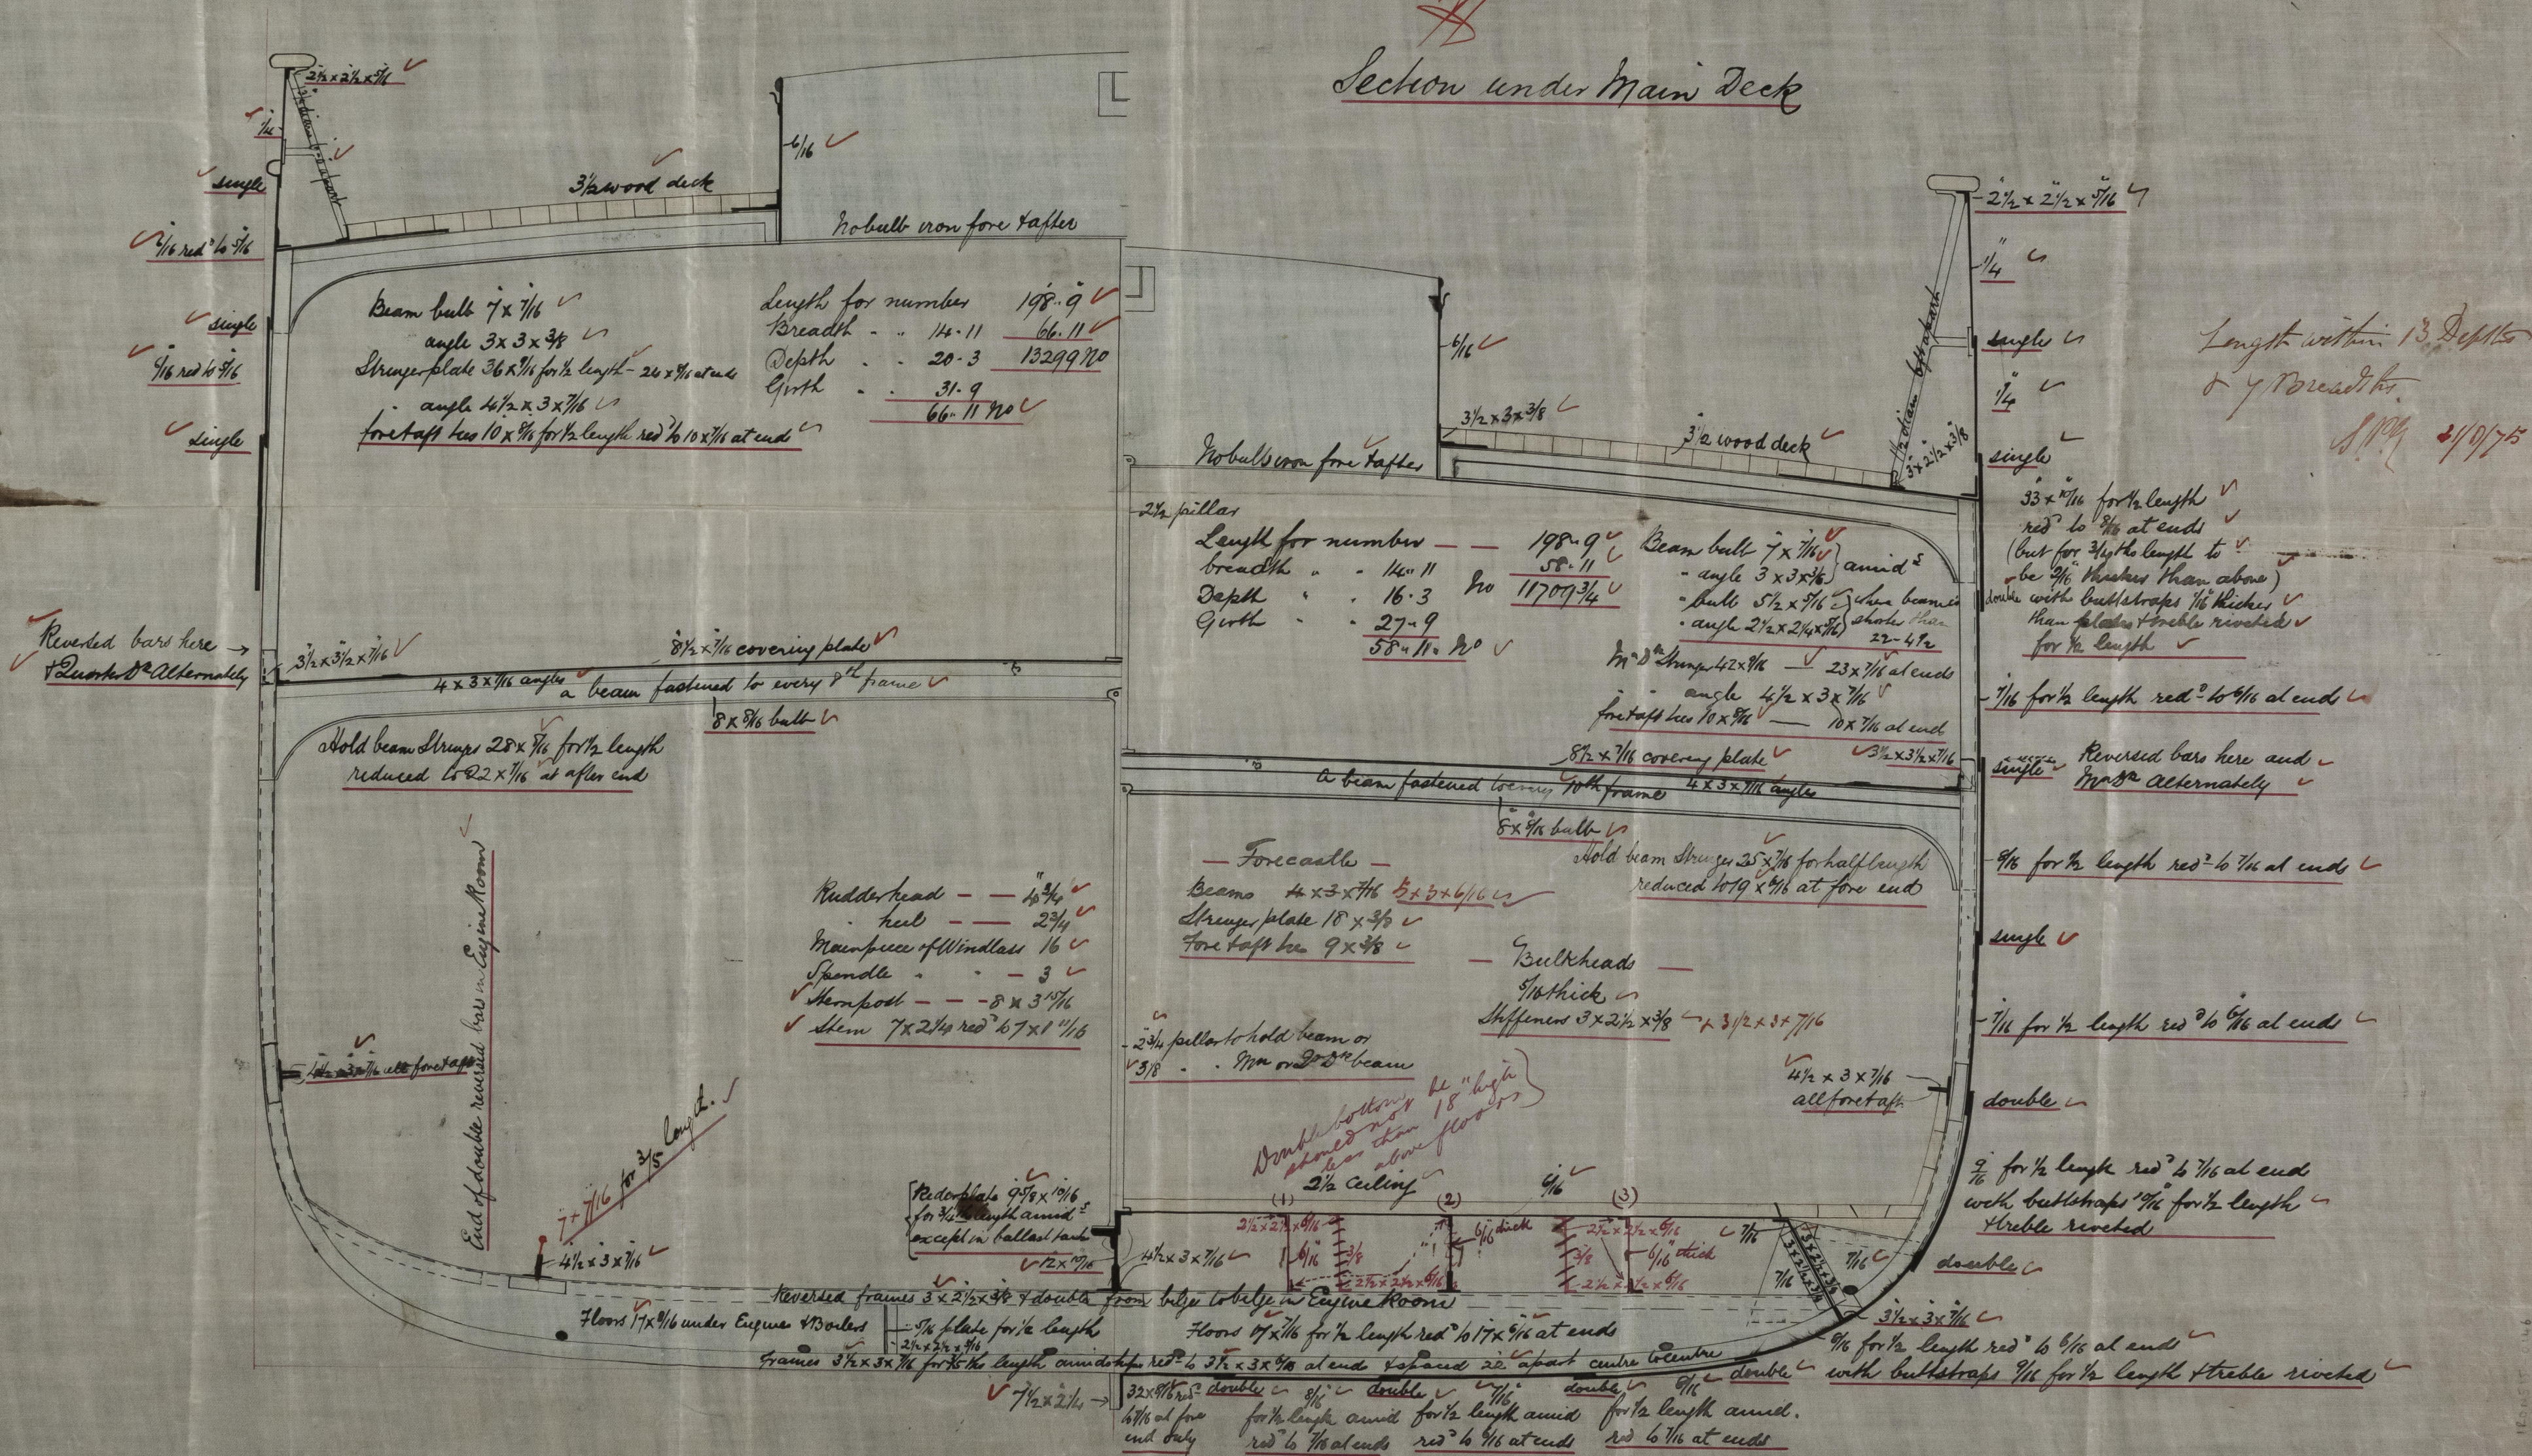

The Longitudinal ^{girders} in Doublebottom
should not be more than 2 feet
apart as shown (corrected) in red
ink at (1) (2), (3), in the drawing. ^{1/16} thick
and the angle irons should be

for Edwin W. H. Lloyd's Register
Foundation
61 Aug 28/98

L. J. Evans
Iron
1624th

180255-0146

Section

globe iron

3/4 wood

© 2021

Lloyd's Register
Foundation