


Sec. Mr. "Peer of the Realm" Report No. 11.395

Sections Thro' Water Ballast Tanks
for


N^o 76 S. S.

1/2" Scale

Rec 20/10/95

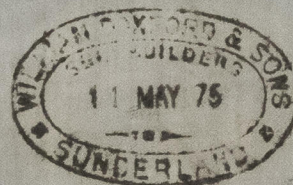

After Tank

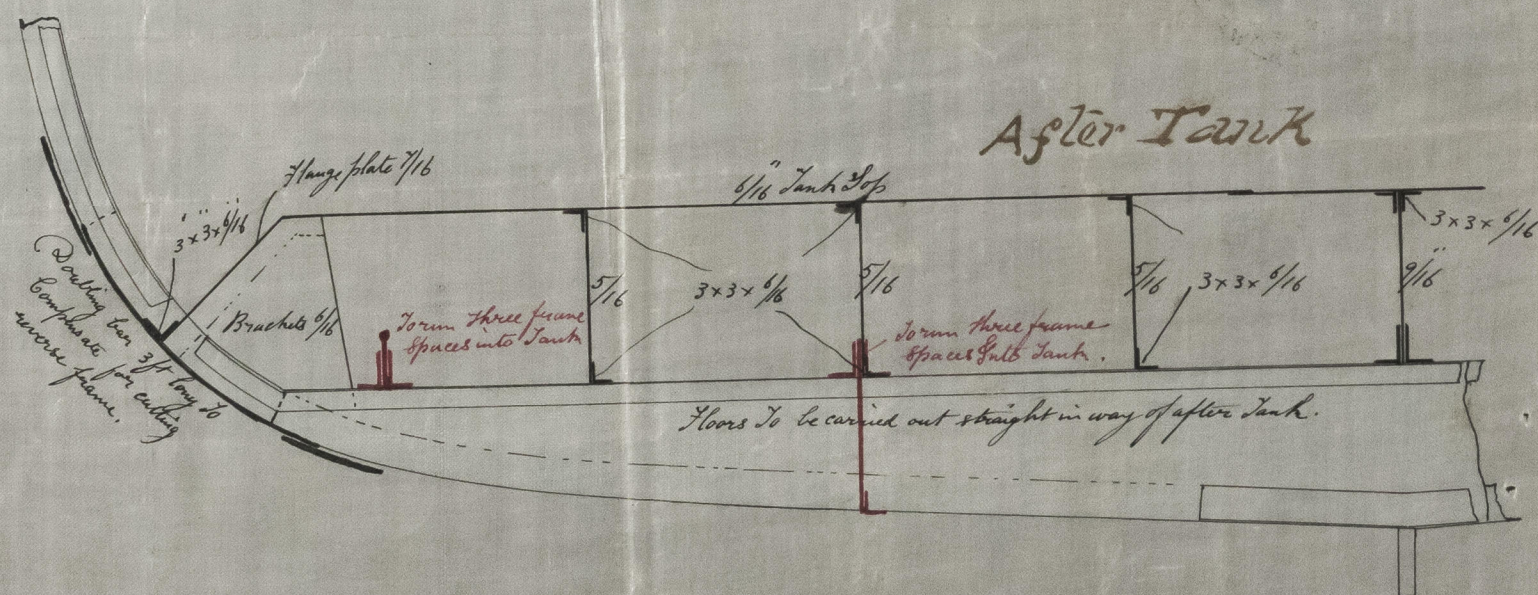

Fore Tank

