

No 6 S.S. Peer of the Realm
Scale 1/2" = 1 Foot



Sections thro' Water Ballast Tanks

Rec 31/5/75

Midship tank



After Tank

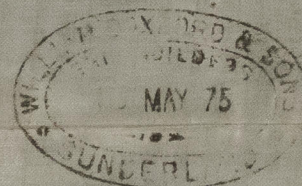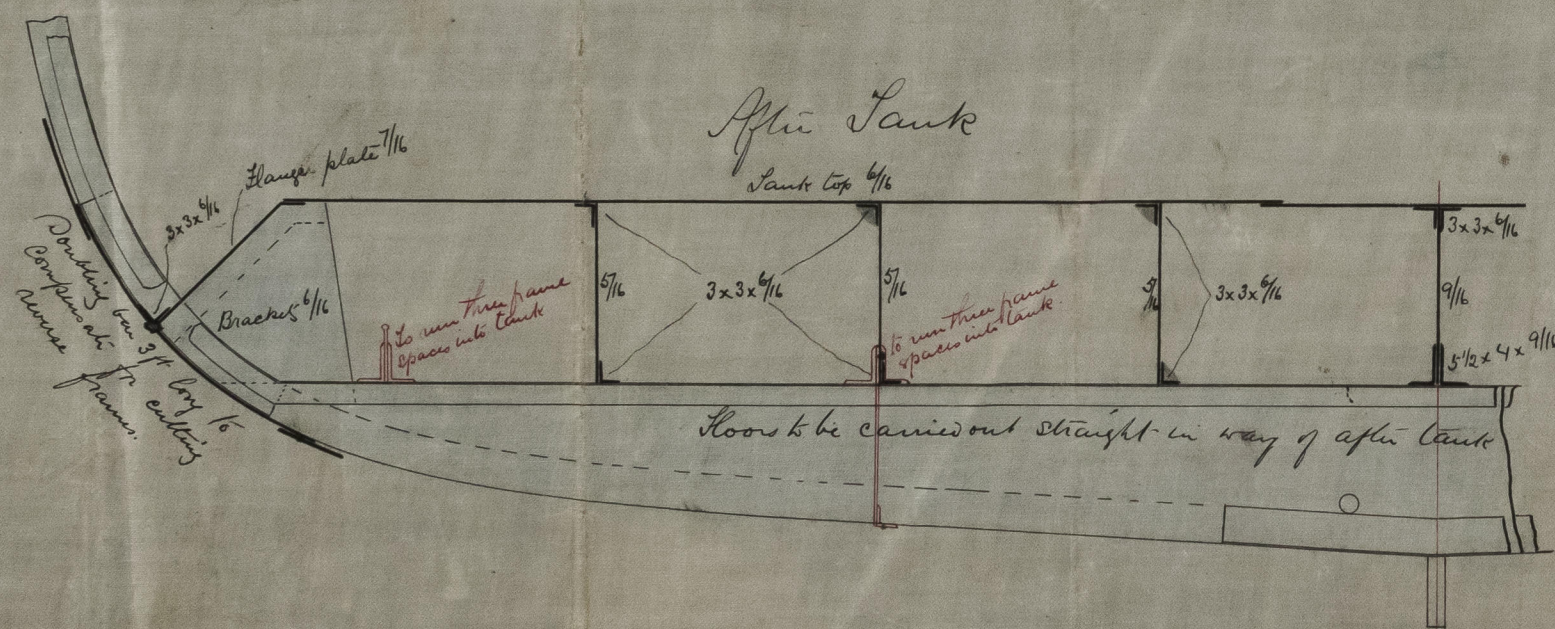

29/5/75
Lloyd's Register
Foundation

"Peer of the Realm"


Peer of the Realm




1802515-0177

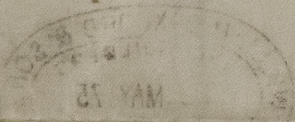

© 2021

Lloyd's Register
Foundation