


22/10/75

S.S. "Secr of the Realm" Report No. 11.395.


No. 7655 Rev 20/10/78

from 16310

Scale $\frac{1}{2}$ " = 1 foot

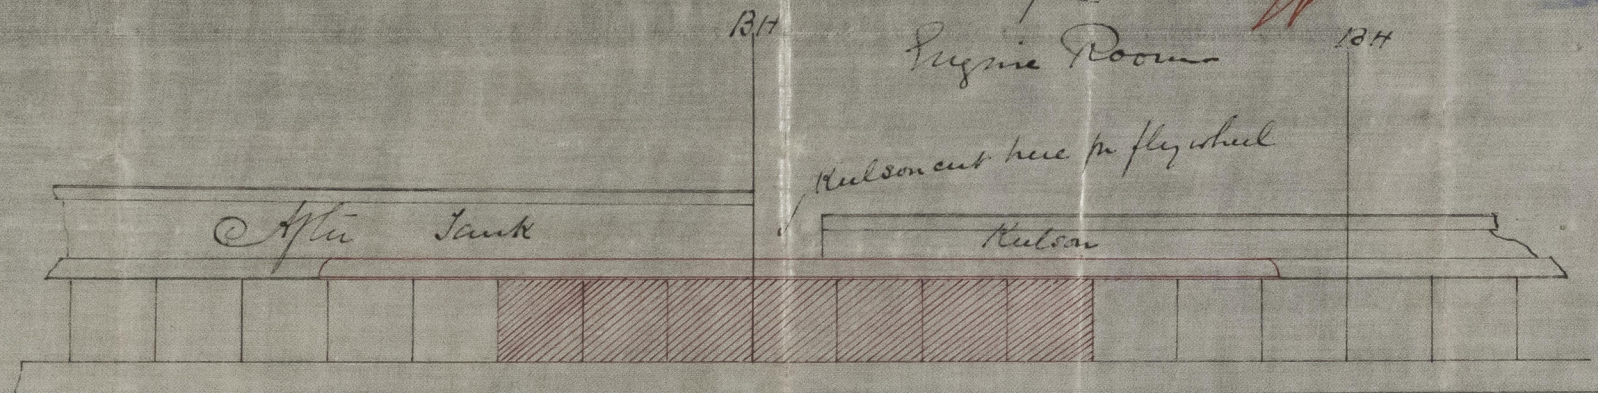

Sketch showing proposed compensation
for cutting main Kelson in way of fly
wheel at after end of Engine Room

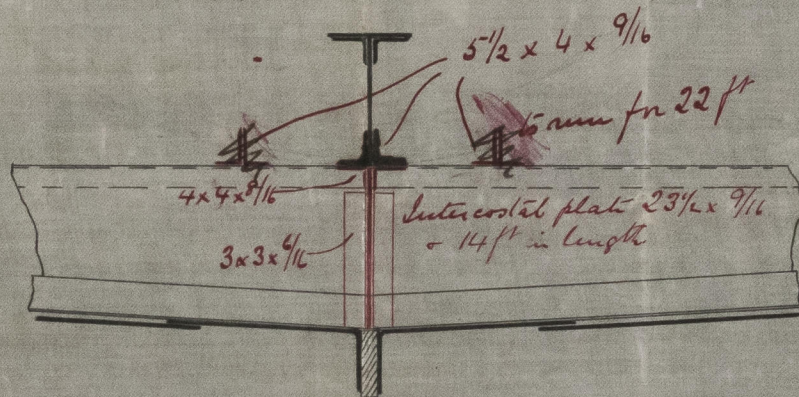

2 JUL 75



© 2021

Lloyd's Register
Foundation

6610-515031