
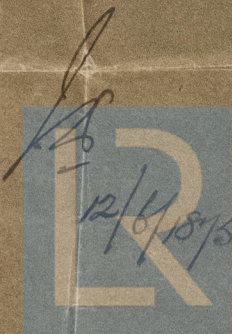


Iron Barque "Carmelo" Report No 11438

— N^o 114 —

— SCALE $\frac{3}{4}$ INCH = 1 FOOT —

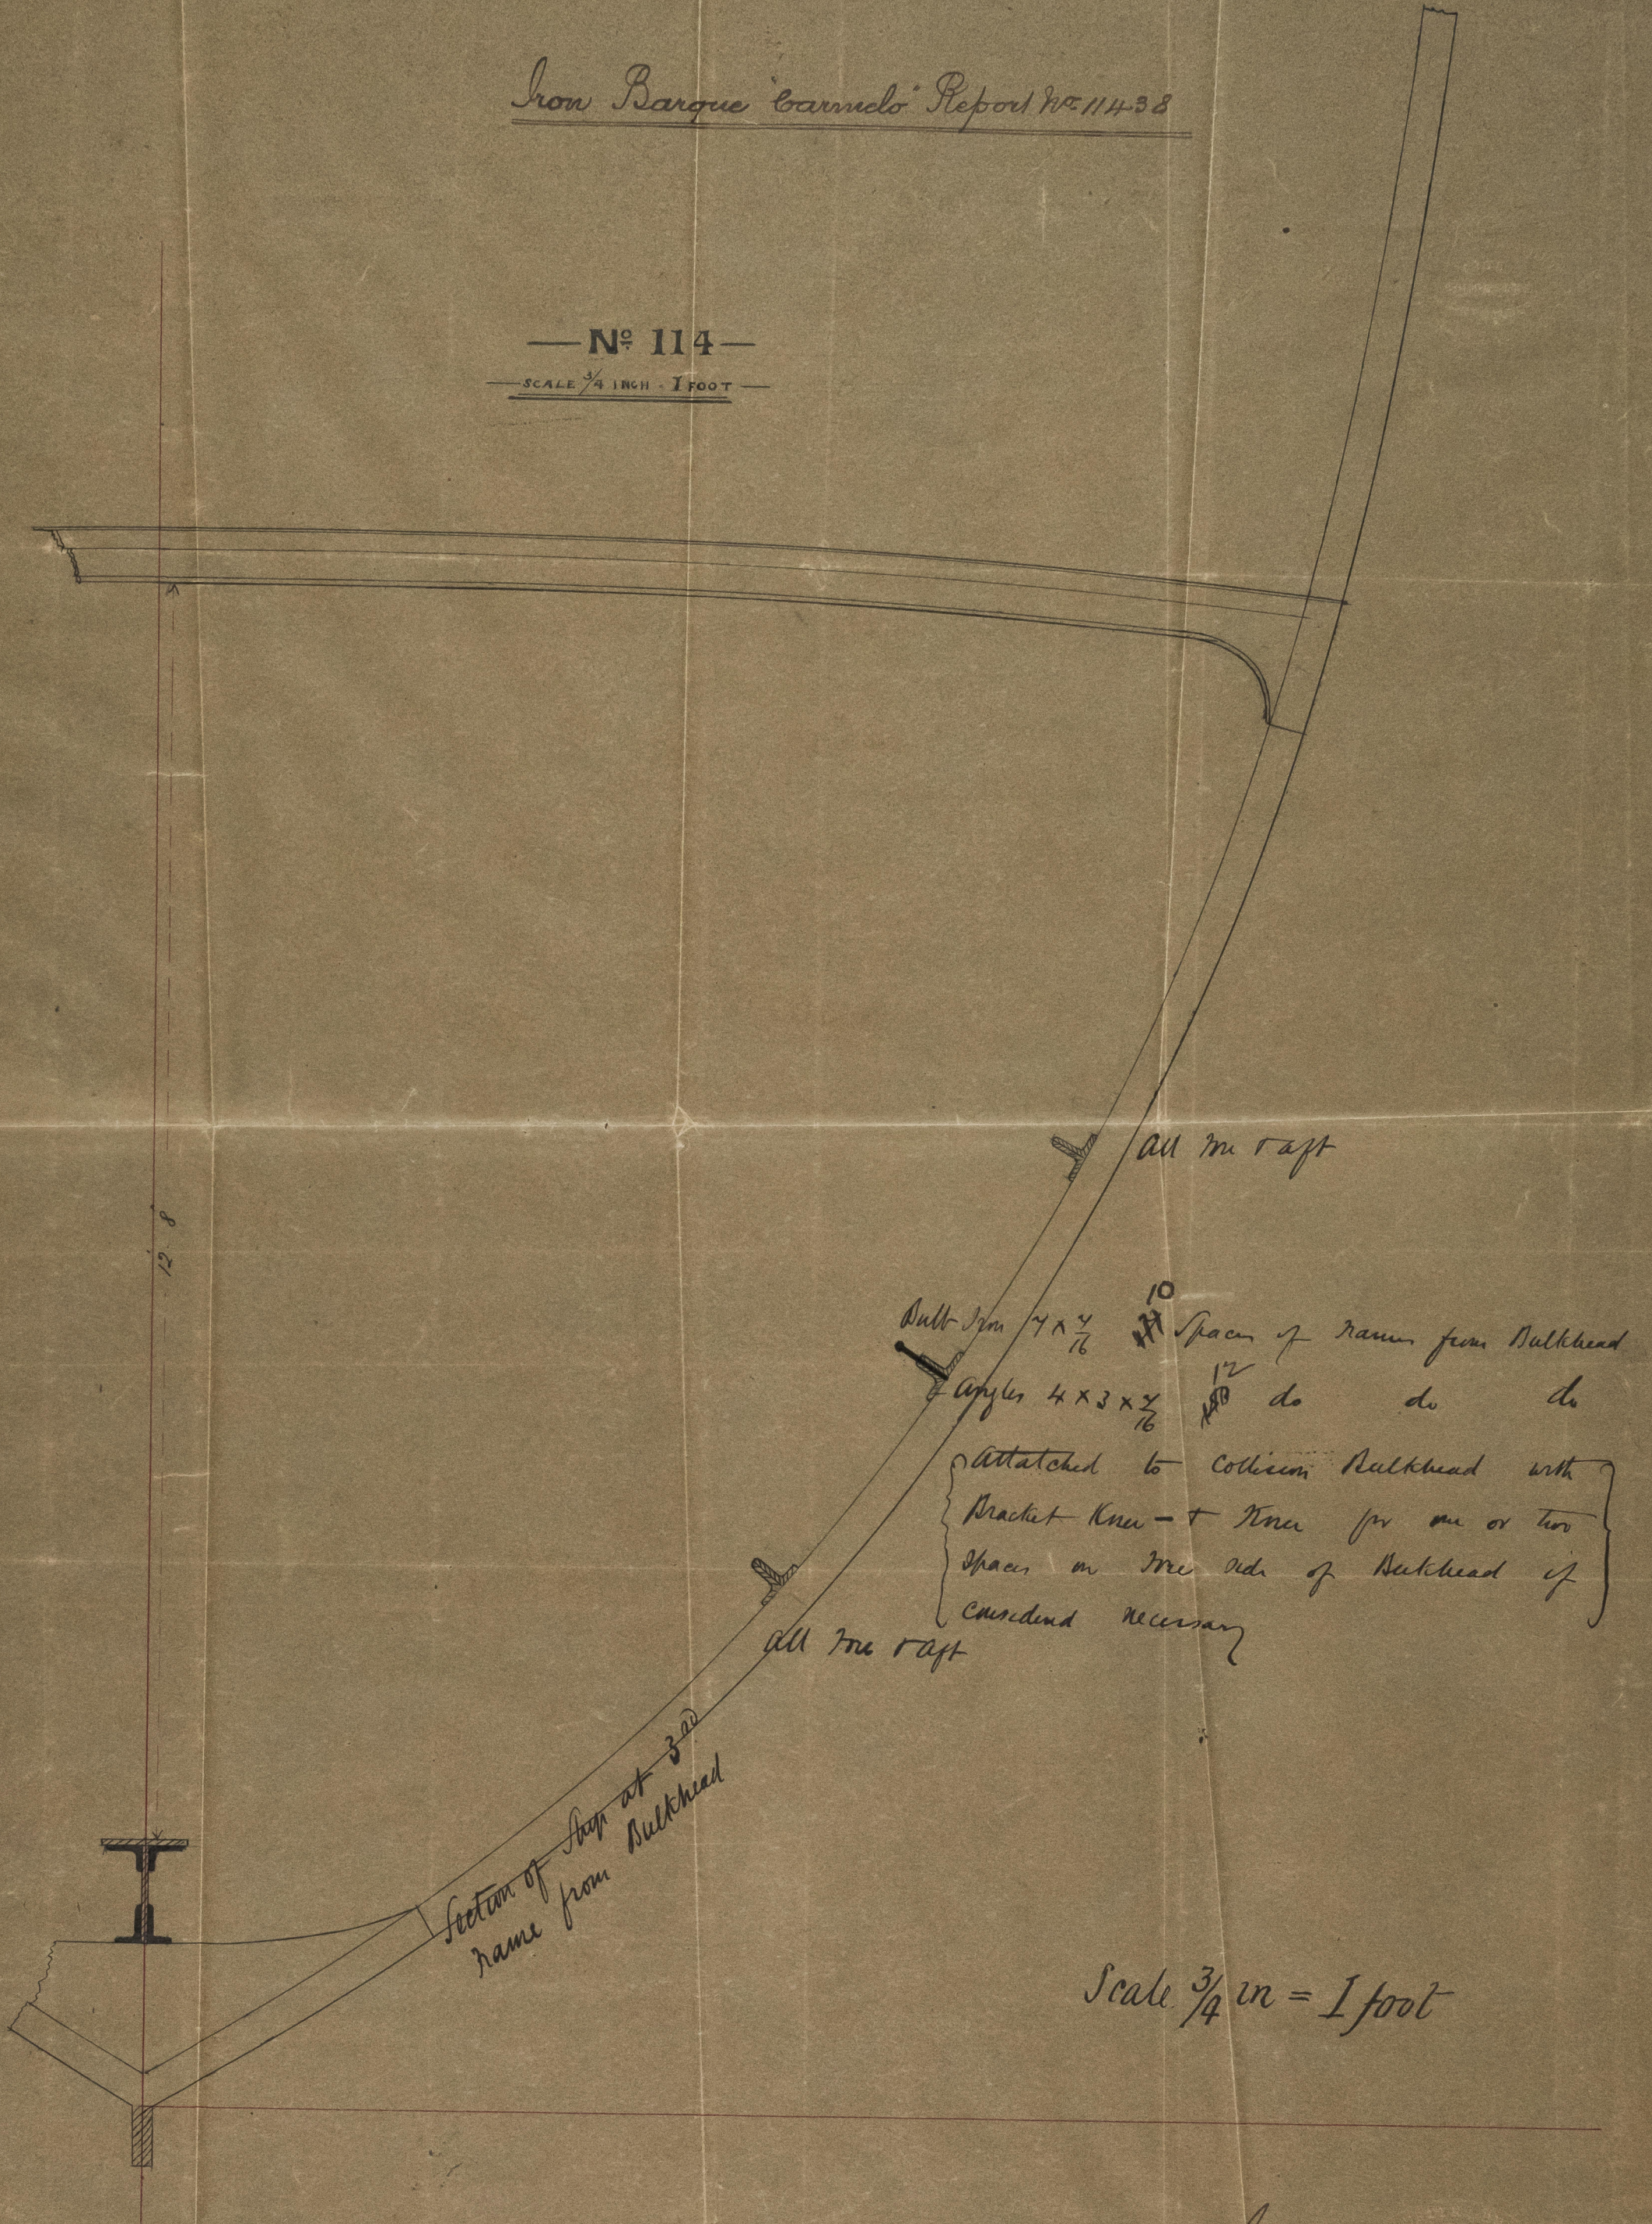

© 2021

Lloyd's Register
Foundation

IRON 516 0010