


# Ship "Periclamus" Glasgow Report No. 1239

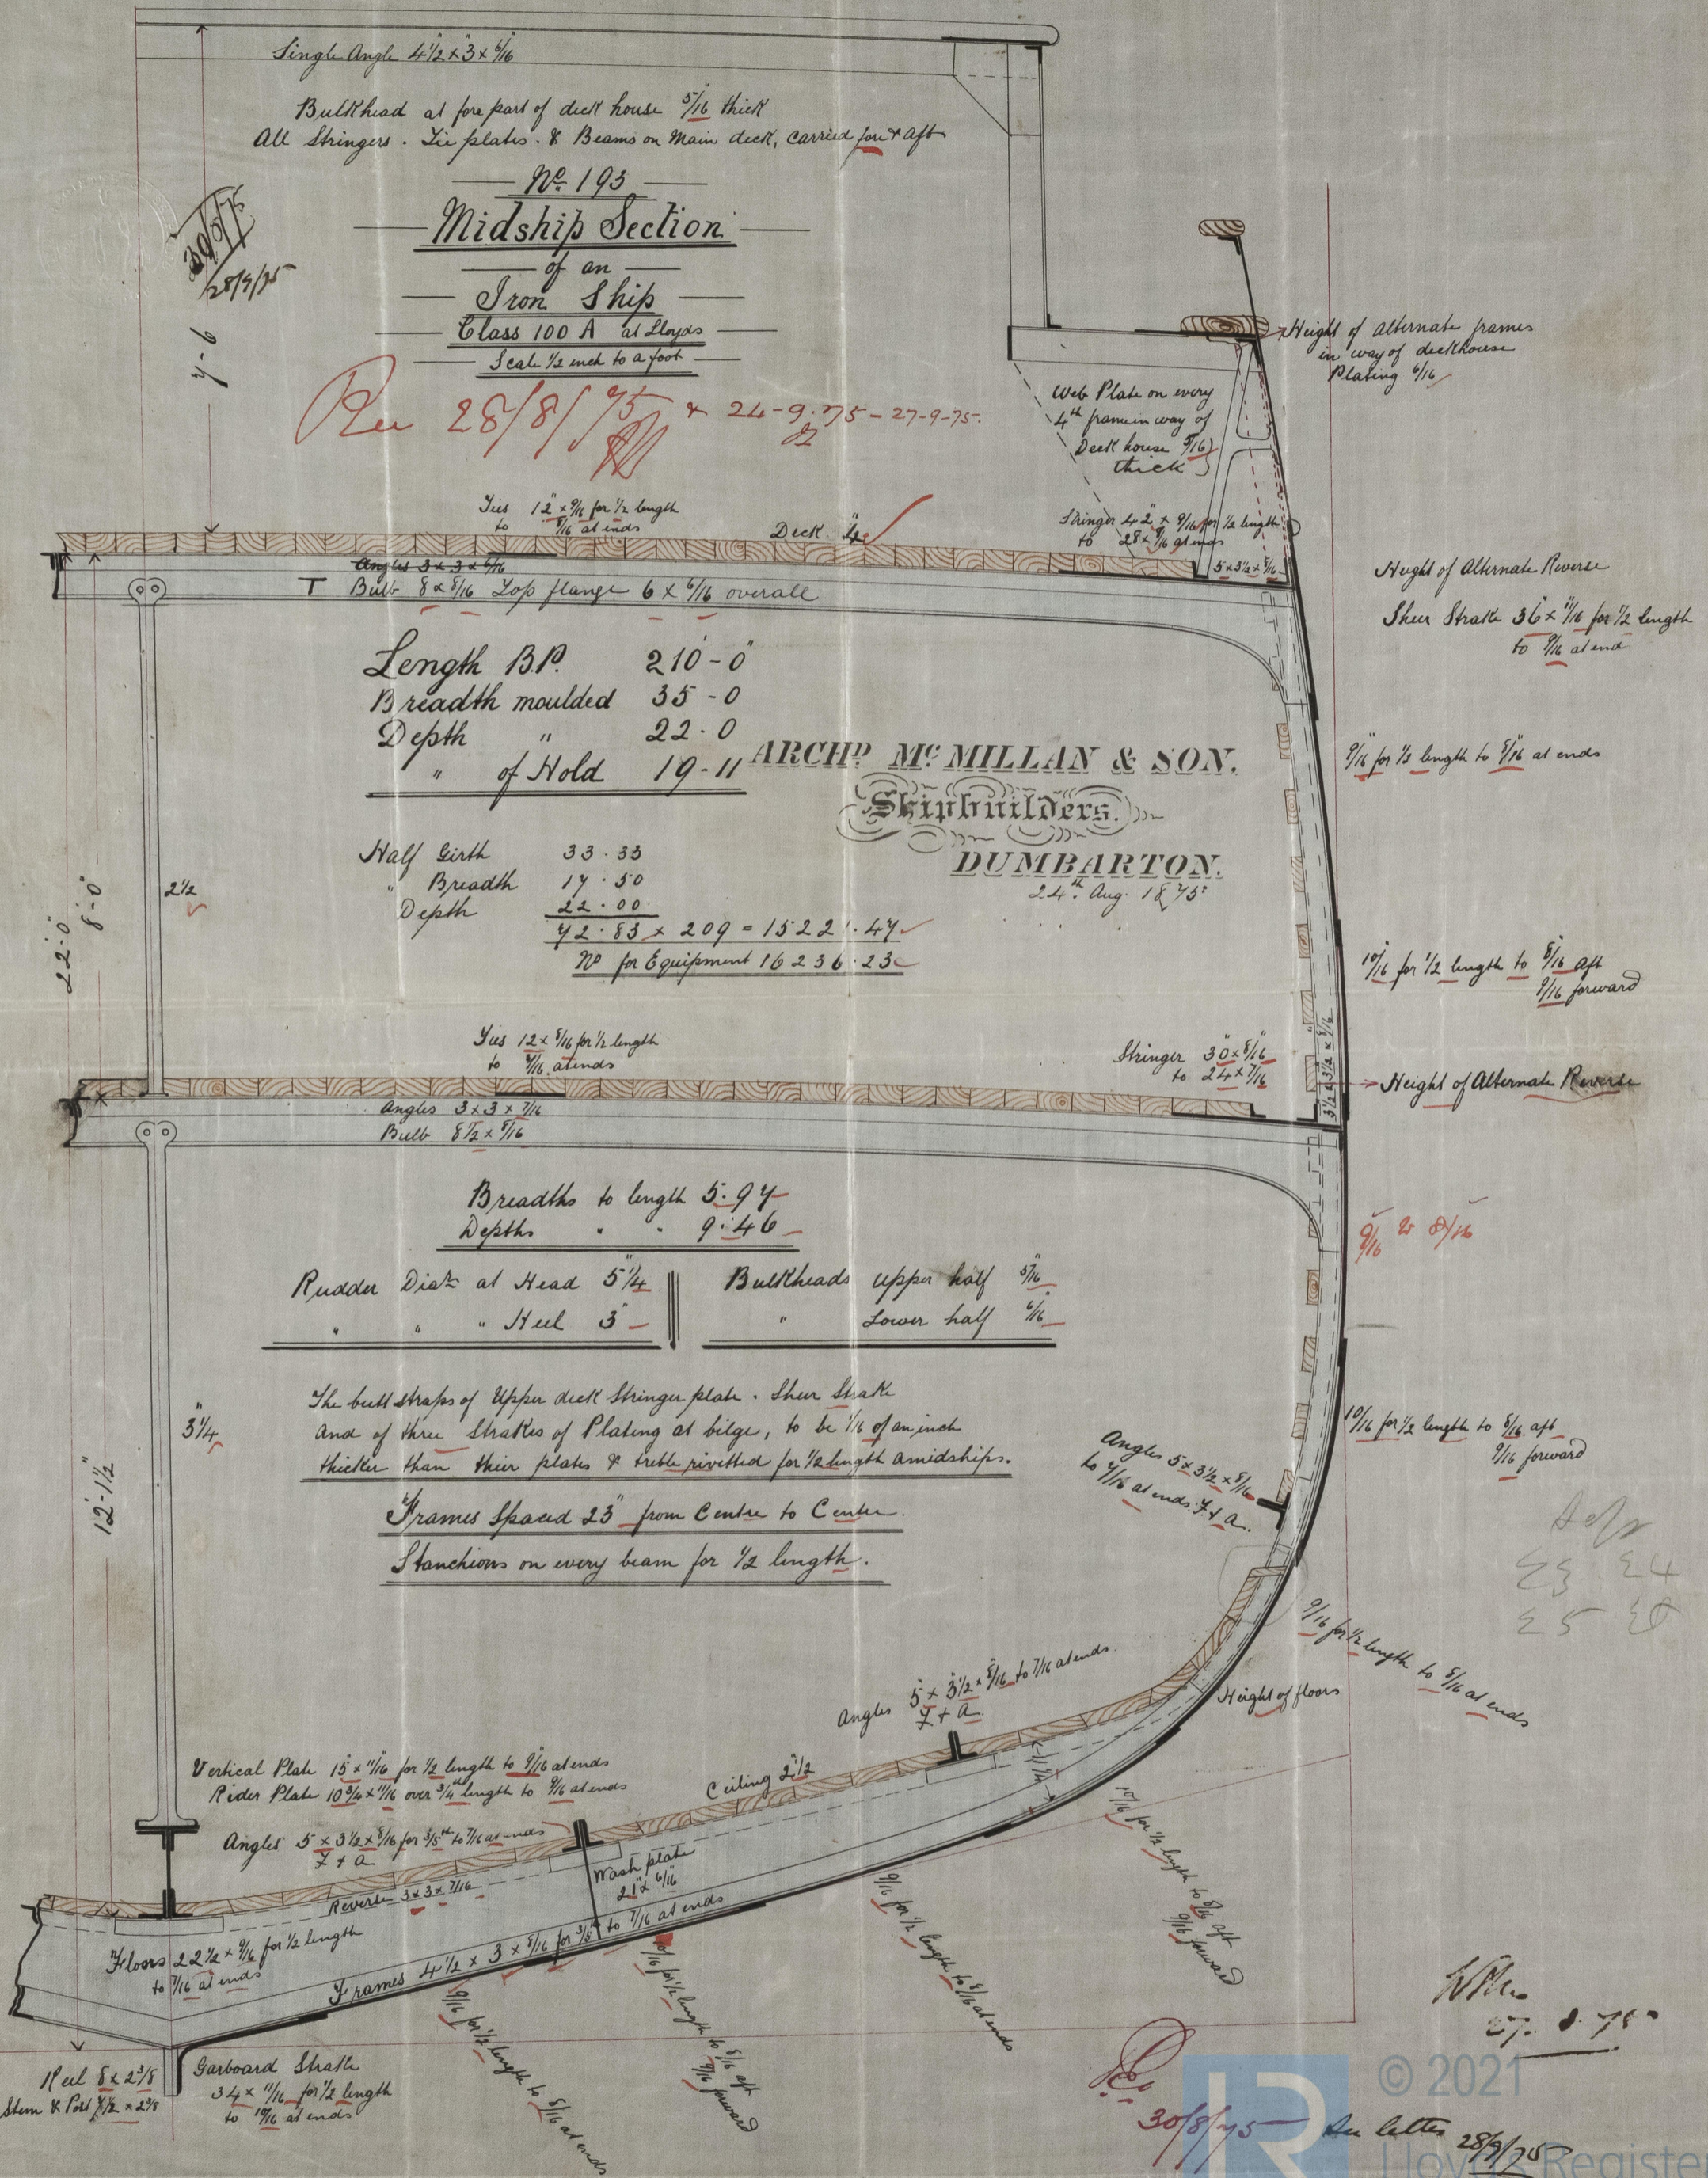

© 2021  
Lloyd's Register  
Foundation