


Sew S² "Malaga"
 Report No. 3652

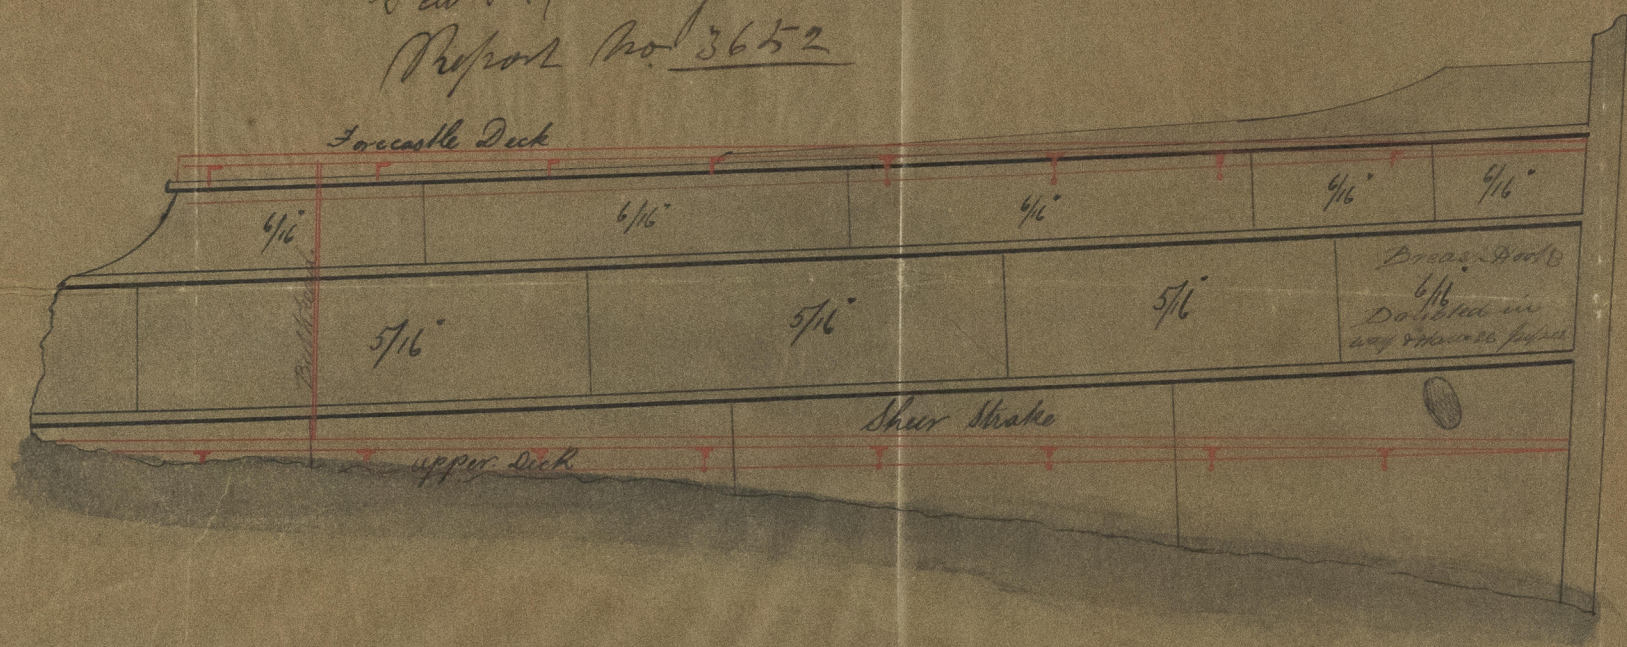


Rec 10/3/76
 H

— N^o 155 SS —

— "MALAGA" —

Scale 1/4 inch to 1 foot

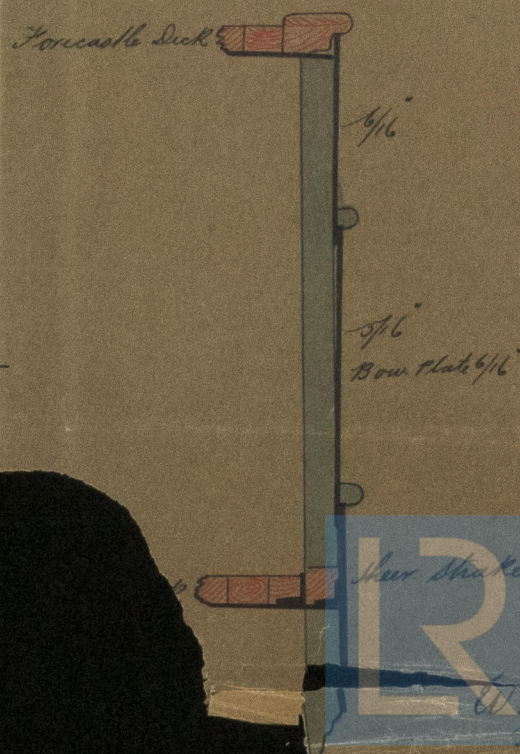

See letters,

11/3/76



© 2021

Lloyd's Register
 Foundation

IRON 516-0017