


Sew Sp. "Malaga"
Report No. 3652

Dimensions	Lloyds	
Length between Pers -----	256.5	Girt 36. $\frac{1}{2}$ ✓
Breadth Extreme -----	31.10	$\frac{1}{2}$ B 15. 11 ✓
Depth of Hold to Upper Deck -----	25. $3\frac{1}{2}$	Depth 25. $3\frac{1}{2}$ ✓
Main -----	18. $3\frac{1}{2}$	$\frac{44}{10}$ <u>40.10</u> ✓
Class 100 A1 @ Lloyds		
Net for frames = 70.10.		
" " Plating = 70.83	256.4 = 18161 ✓	
" " Equipment = 77.73	= 14456 ✓	
Depths in Lengths $\frac{10}{11}$ Upper Deck -----		
" " $\frac{11}{12}$ Main Deck -----		
over 8 Bre width in length.		

Scale $\frac{1}{2} = 1 \text{ foot}$

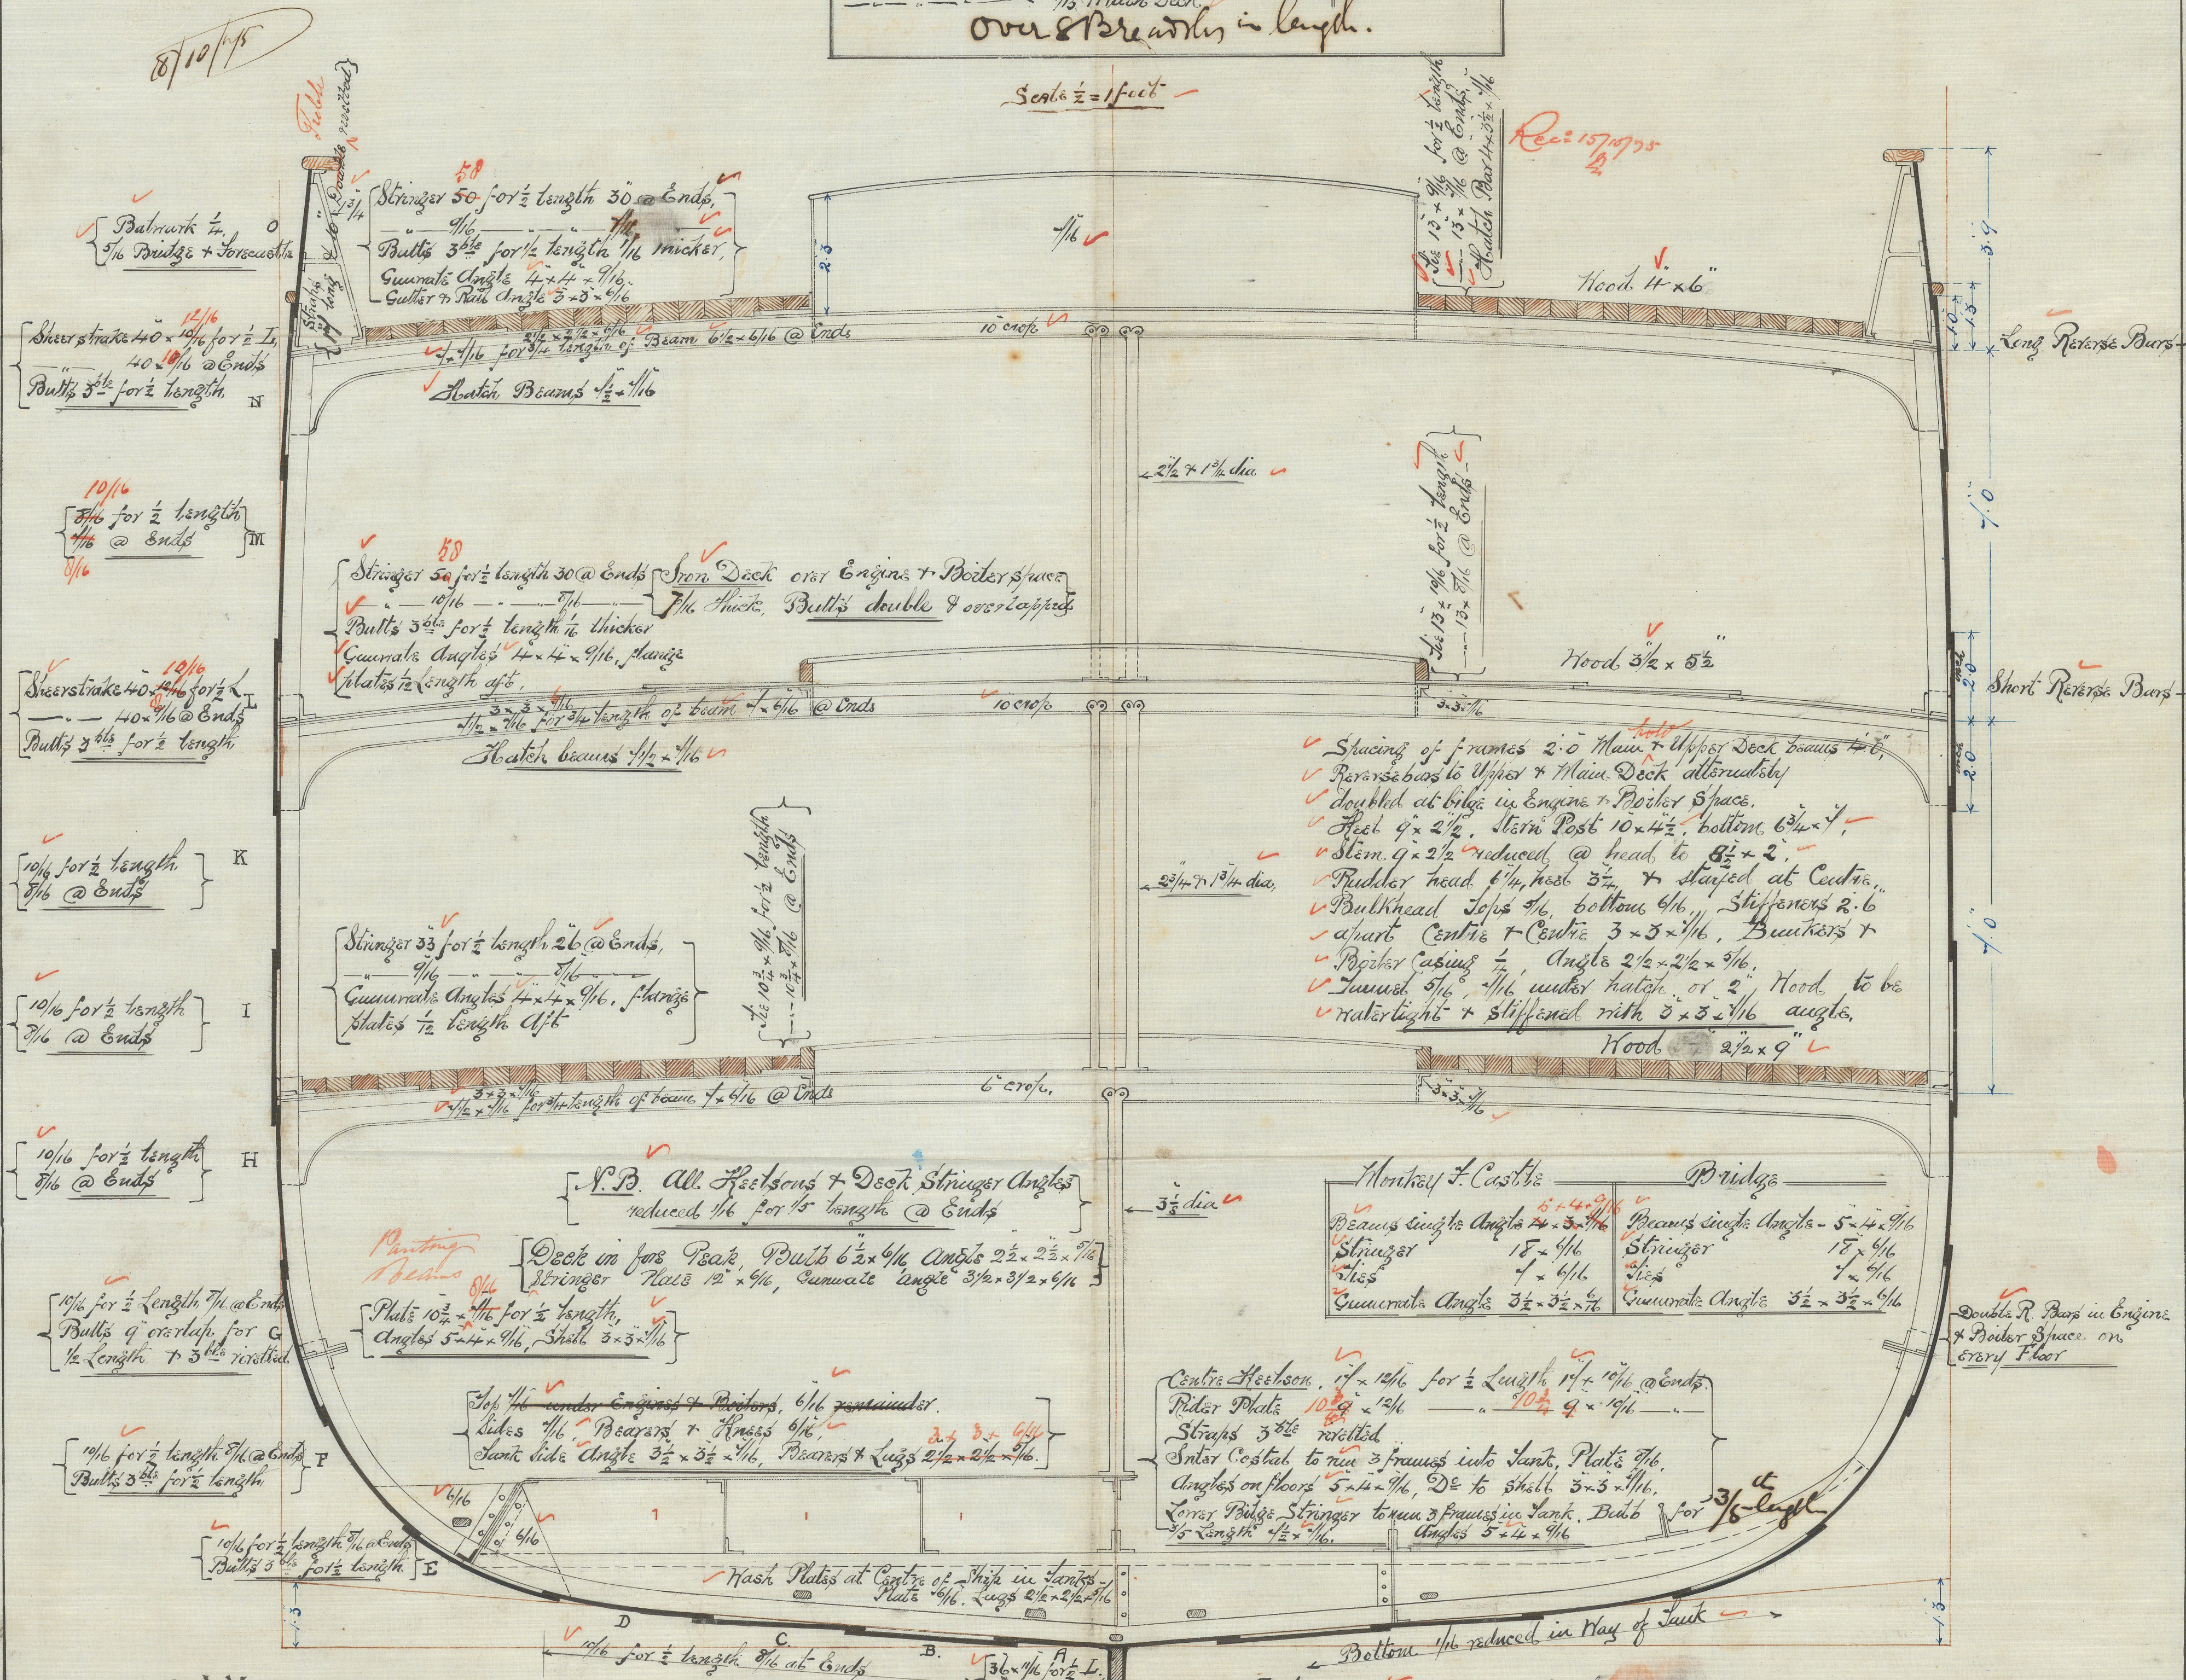

W. GRAY & CO.
IRON SHIPBUILDERS
&
REPAIRERS
15th Oct 1845
WEST HARTLEPOOL

Sundries
Boss Plate ^{111/2} " Best Best Quality ✓
Saws all Double, rolled, except 1/2 ✓
edge of Shear + that single, 1/2 + 3/4 @ Ends ✓
Rods in frames from small 7/8 + 3/4 @ Ends ✓

Sheet Notes $1\frac{1}{8}$
Pitch — $5\frac{1}{8}$

Trametes, $4\frac{1}{2} \times 3 \times \frac{1}{16}$ for $\frac{1}{2}$ length $\frac{1}{16}$ @ Ends.
 $2 \cdot 0$ apart C + C, next pieces $3 \cdot 0$
Floors, $2\frac{1}{2} \times \frac{1}{16}$ for $\frac{1}{2}$ length $\frac{1}{16}$ @ Ends,
 $\frac{1}{16}$ under Doublers.
Reverse Bars, $3 \times 3 \times \frac{1}{16}$, double in Virginia. Run to
 upper turn of Pulge

155.