


Yard No. 39

A 3

Midship Section of Screw Steamer

90 A

Length Between Perps	98' 6"
Breadth	17' 0"
Depth from Top of Keel	9' 0"
Tonnage B. M.	135 Tons.
Scale $\frac{1}{2}$ " = 1 foot.	Sep 29/75

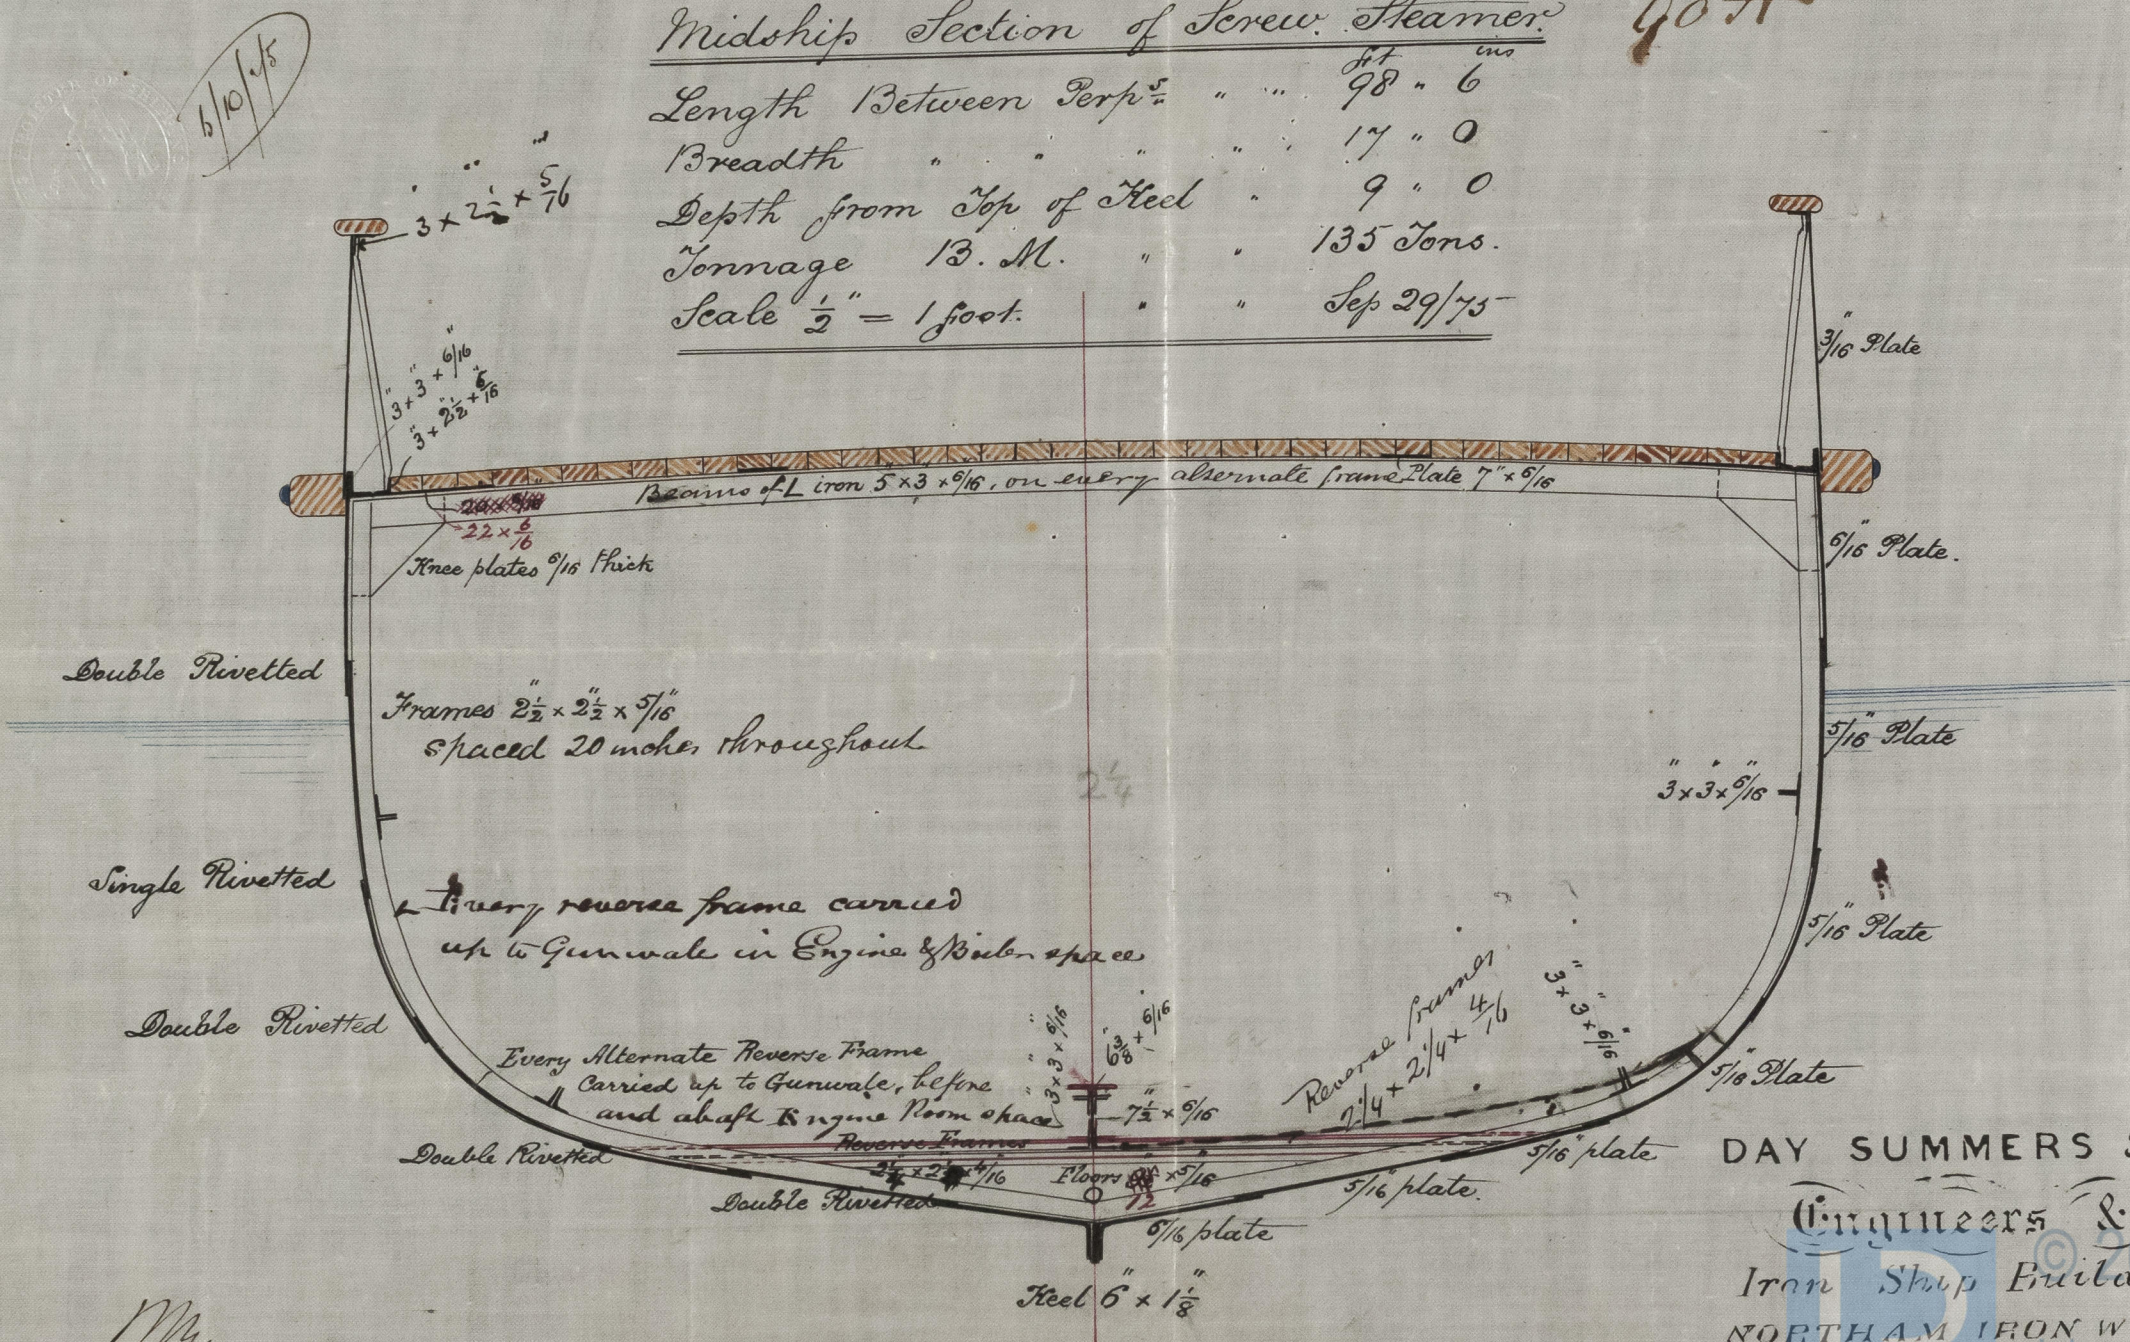

DAY SUMMERS & CO  
Engineers & Co.  
Iron Ship Builders  
NORTHAM IRON WORKS  
SOUTHAMPTON

Mr  
7/10/75

IRON 616 - 0032

© 2021 Lloyd's Register Foundation