

Barque "Scottish Hero" Report No. 11.425.

S. N<sup>os</sup> 79 & 80


Scale 1 in = 1 foot

Fore Mast 24 1/2" dia x 71' 9"

Seams double riv<sup>d</sup>

To be 1/16 thicker than the plating { Butts below partners double riv<sup>d</sup> ✓  
remainder triple ✓  
Plating 5/16 x 3/16 ✓

Mast doubled in way of wedging to extend above upper deck  
11' 0" x 1/16

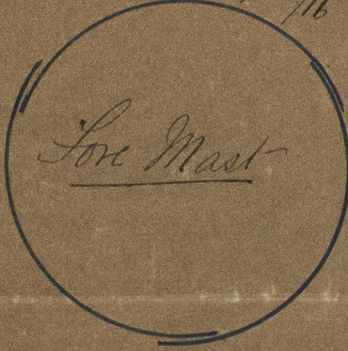

Chrees 3/16, angles 4 1/2 x 3 x 1/16  
and efficiently strengthened  
on the front edges as per  
rule

Straps 1/16 thicker  
than plating  
3/4 Rivets


Bowspout 20' 0" outside dia 26"

Seams double riv<sup>d</sup>

{ Butts " " inside of Red. ✓  
" " " " outside " ✓

Plating 1/16 x 5/16

Doubled at Red 6 ft x 1/16 angles

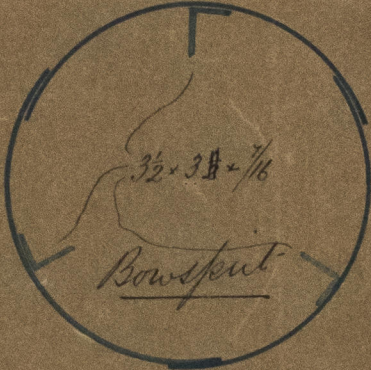

Straps 6 x 7/16

{ Butts below Partners double riv<sup>d</sup> seams triple ✓

Plating 1/16 x 5/16 as per rule

doubled in way of wedging 11 ft x 1/16 to extend above upper deck


Lower Topsail Yard 14' dia x 58' 0"

Plating 1/16, 3/16 + 3/16

seams single riv<sup>d</sup>

Butts triple

doubled at center 5' 0" x 1/16

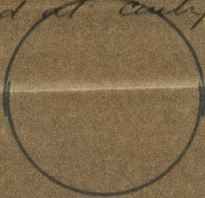


Fore & Main Yards 69' 0" x 17" dia ✓ Ends 8 1/2 in

Plating 3/16, 1/16 + 3/16 as per rule

Seams single riv<sup>d</sup>

Butts triple ✓

doubled at center 6' 0" x 3/16 ✓

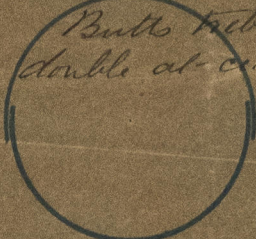

© 2021

Lloyd's Register  
Foundation

IRONSSIDE 1054