

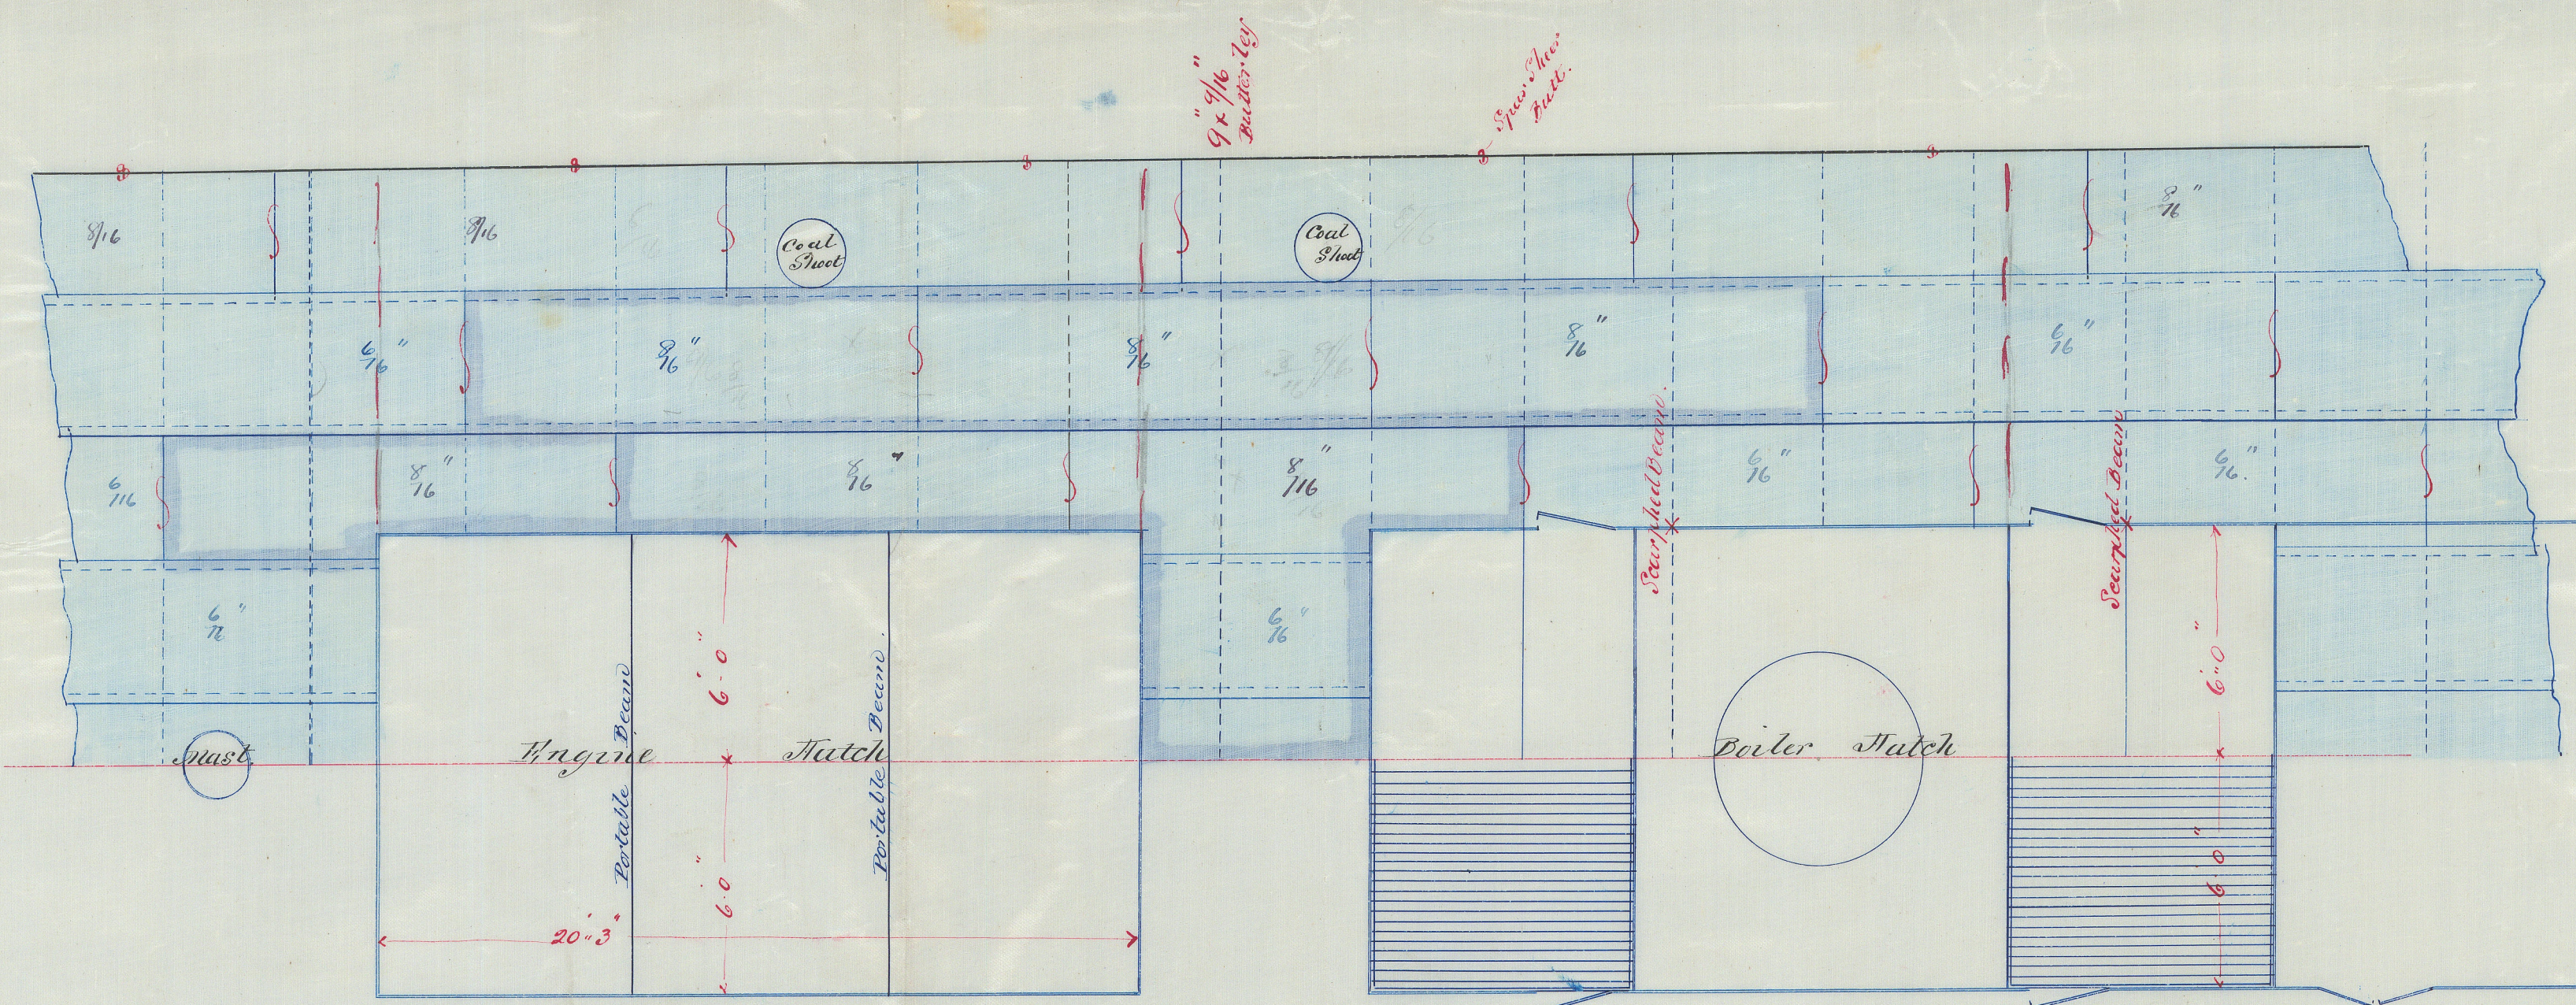
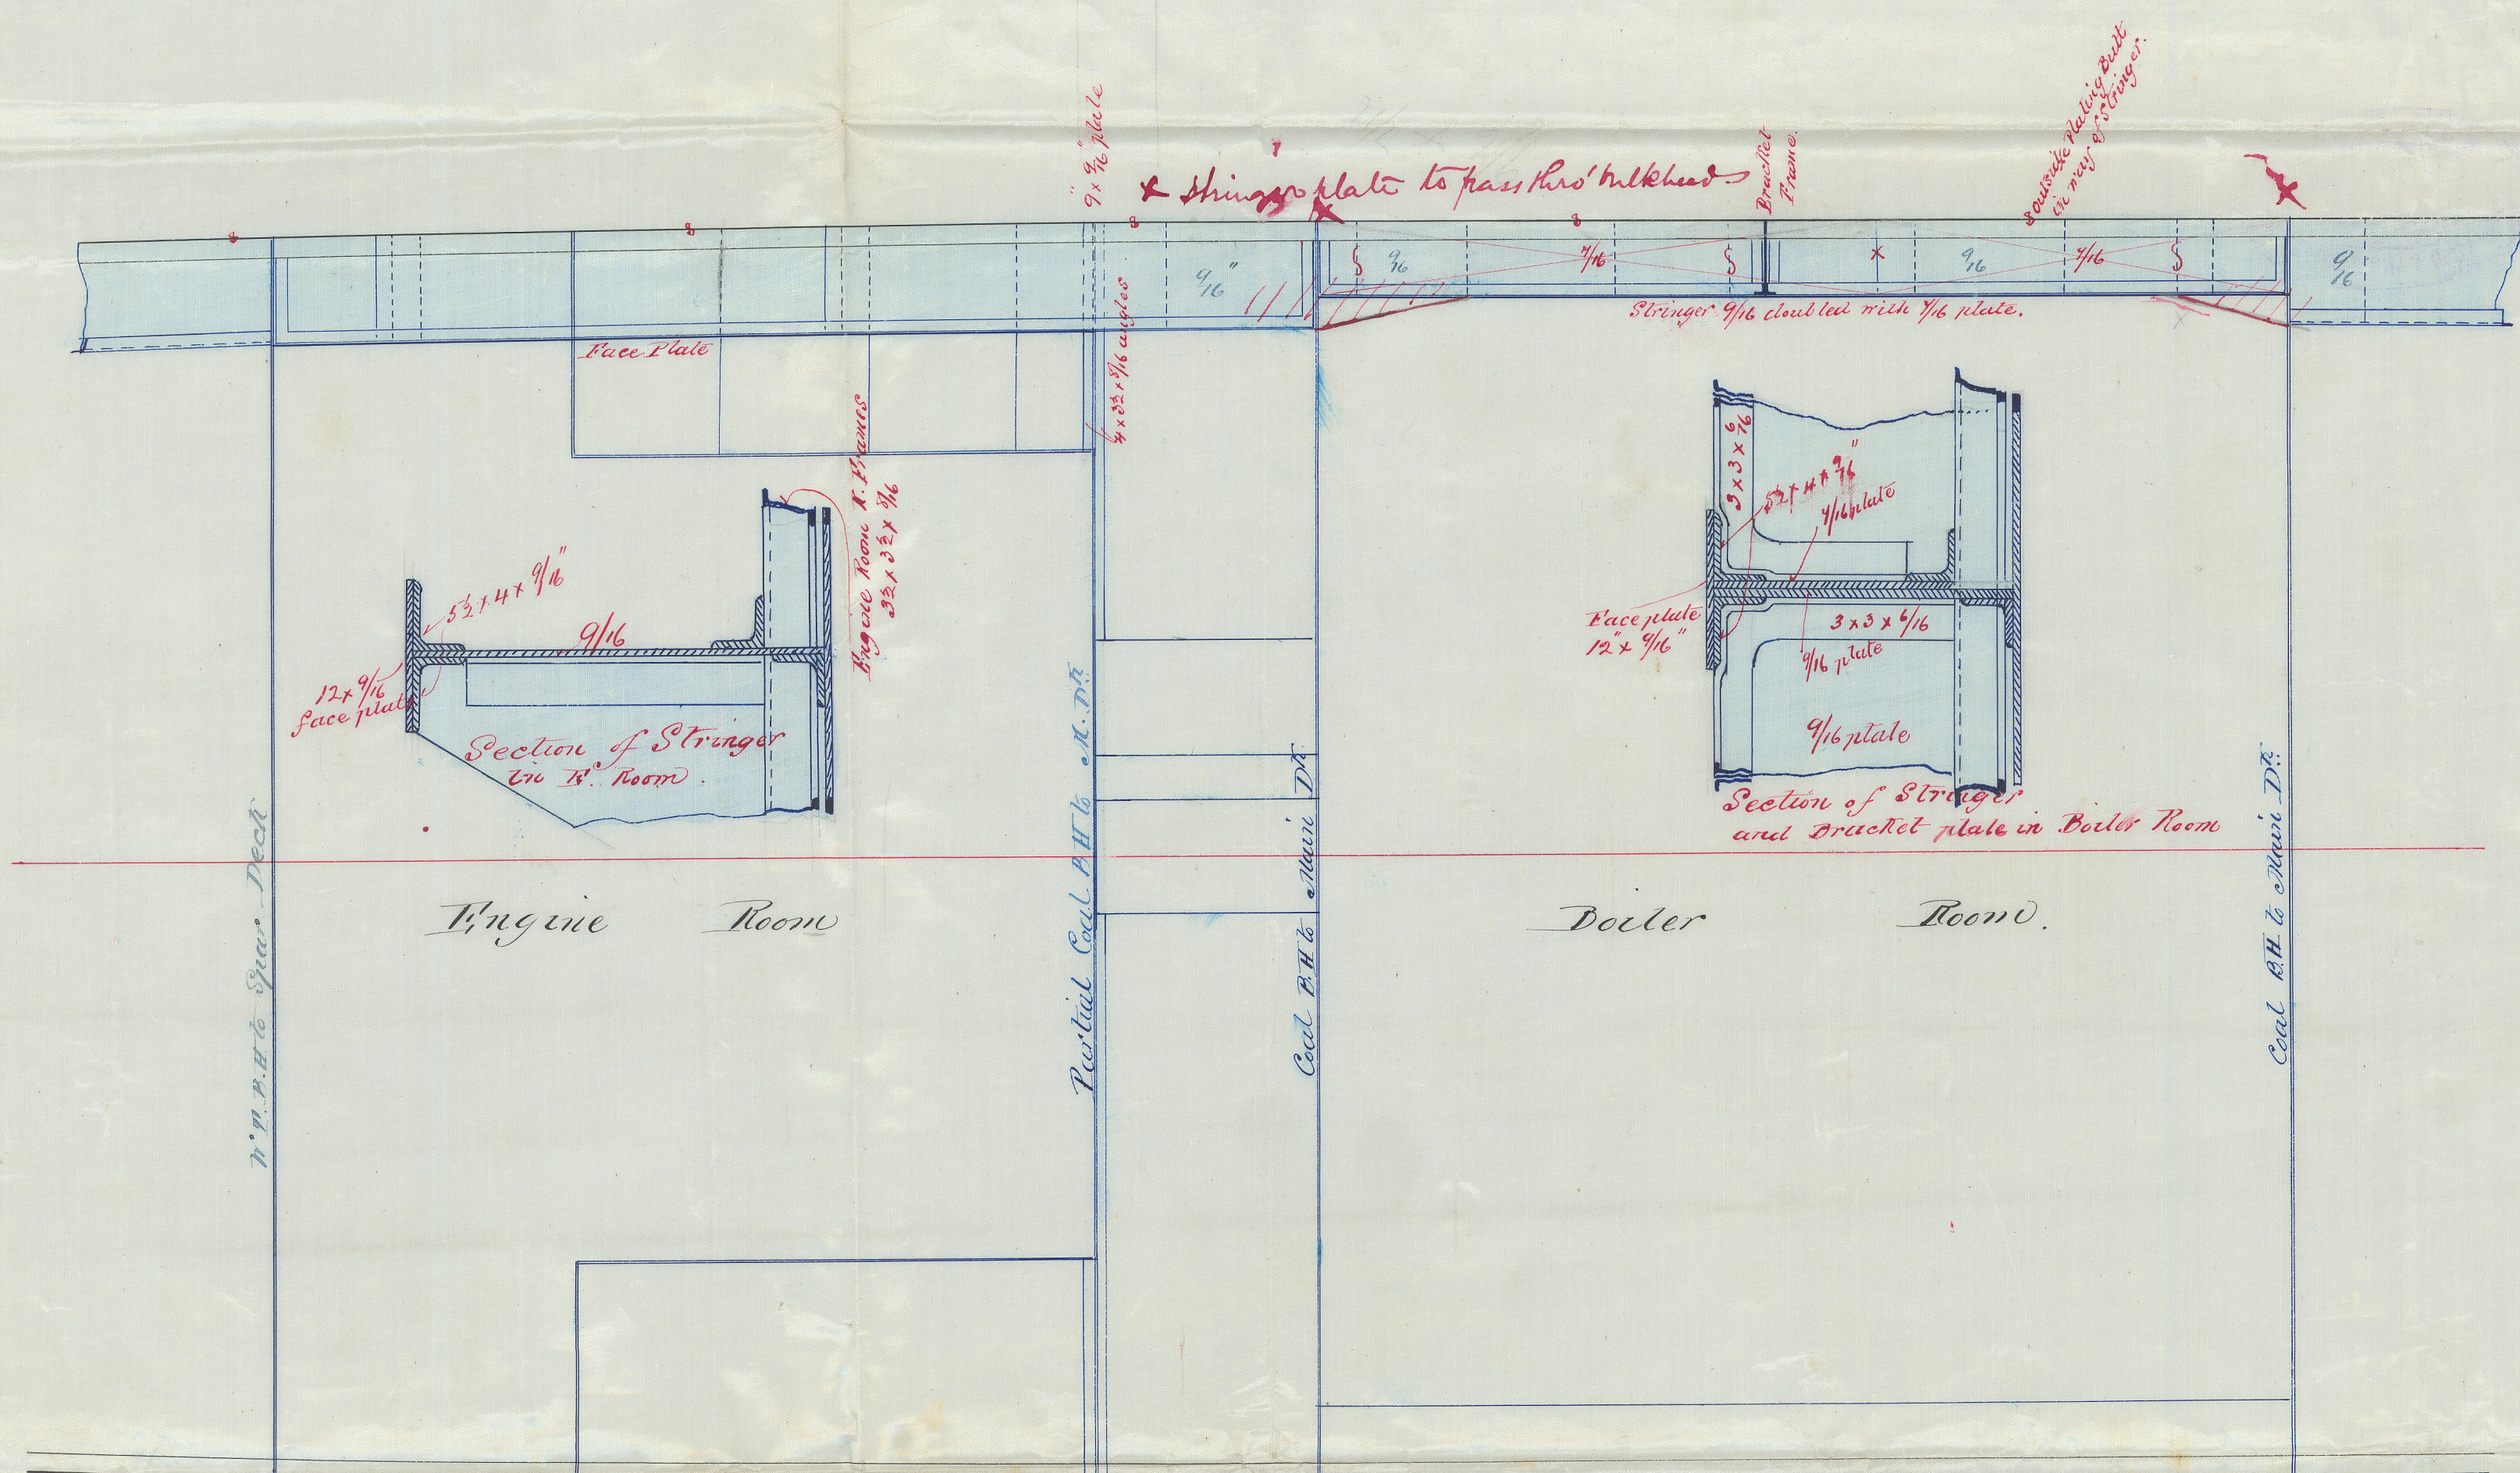
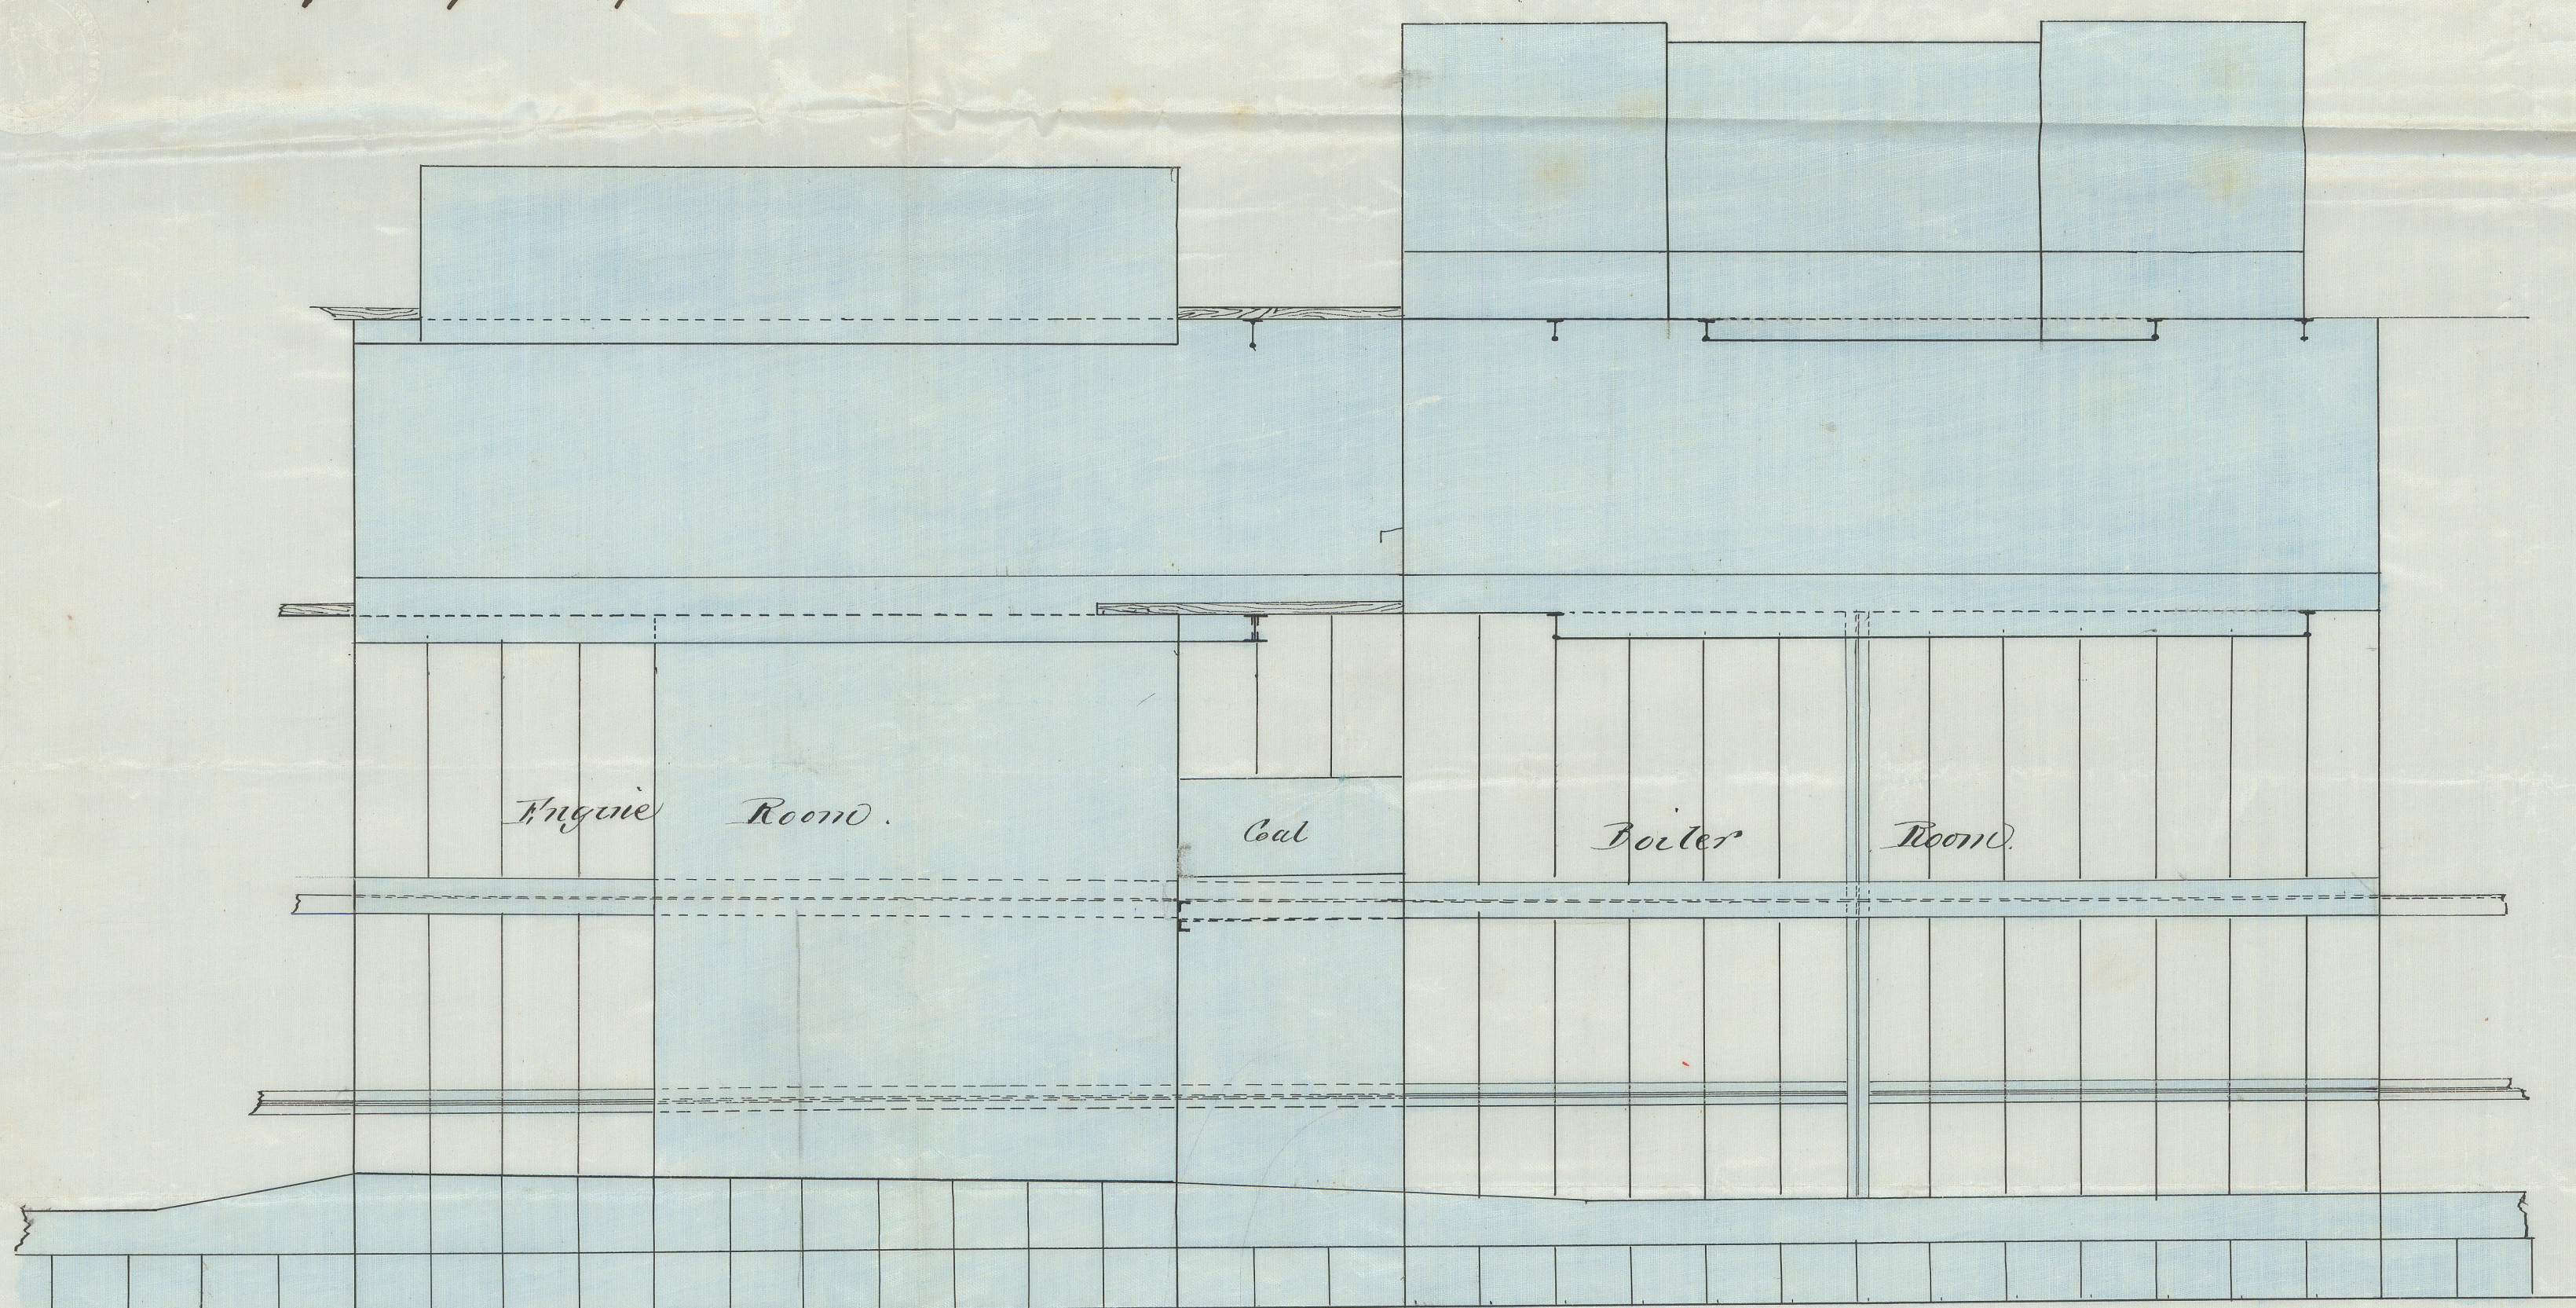


S.S. 'Wakatipu'
 Glasgow Report No 4247
 3/12/75
 Sketch of Engine & Boiler Hatch
 on
 Spar, Main and Lower decks.
 No 188. Rev 2/12/75
 Scale 1/4" = 1 foot
 4

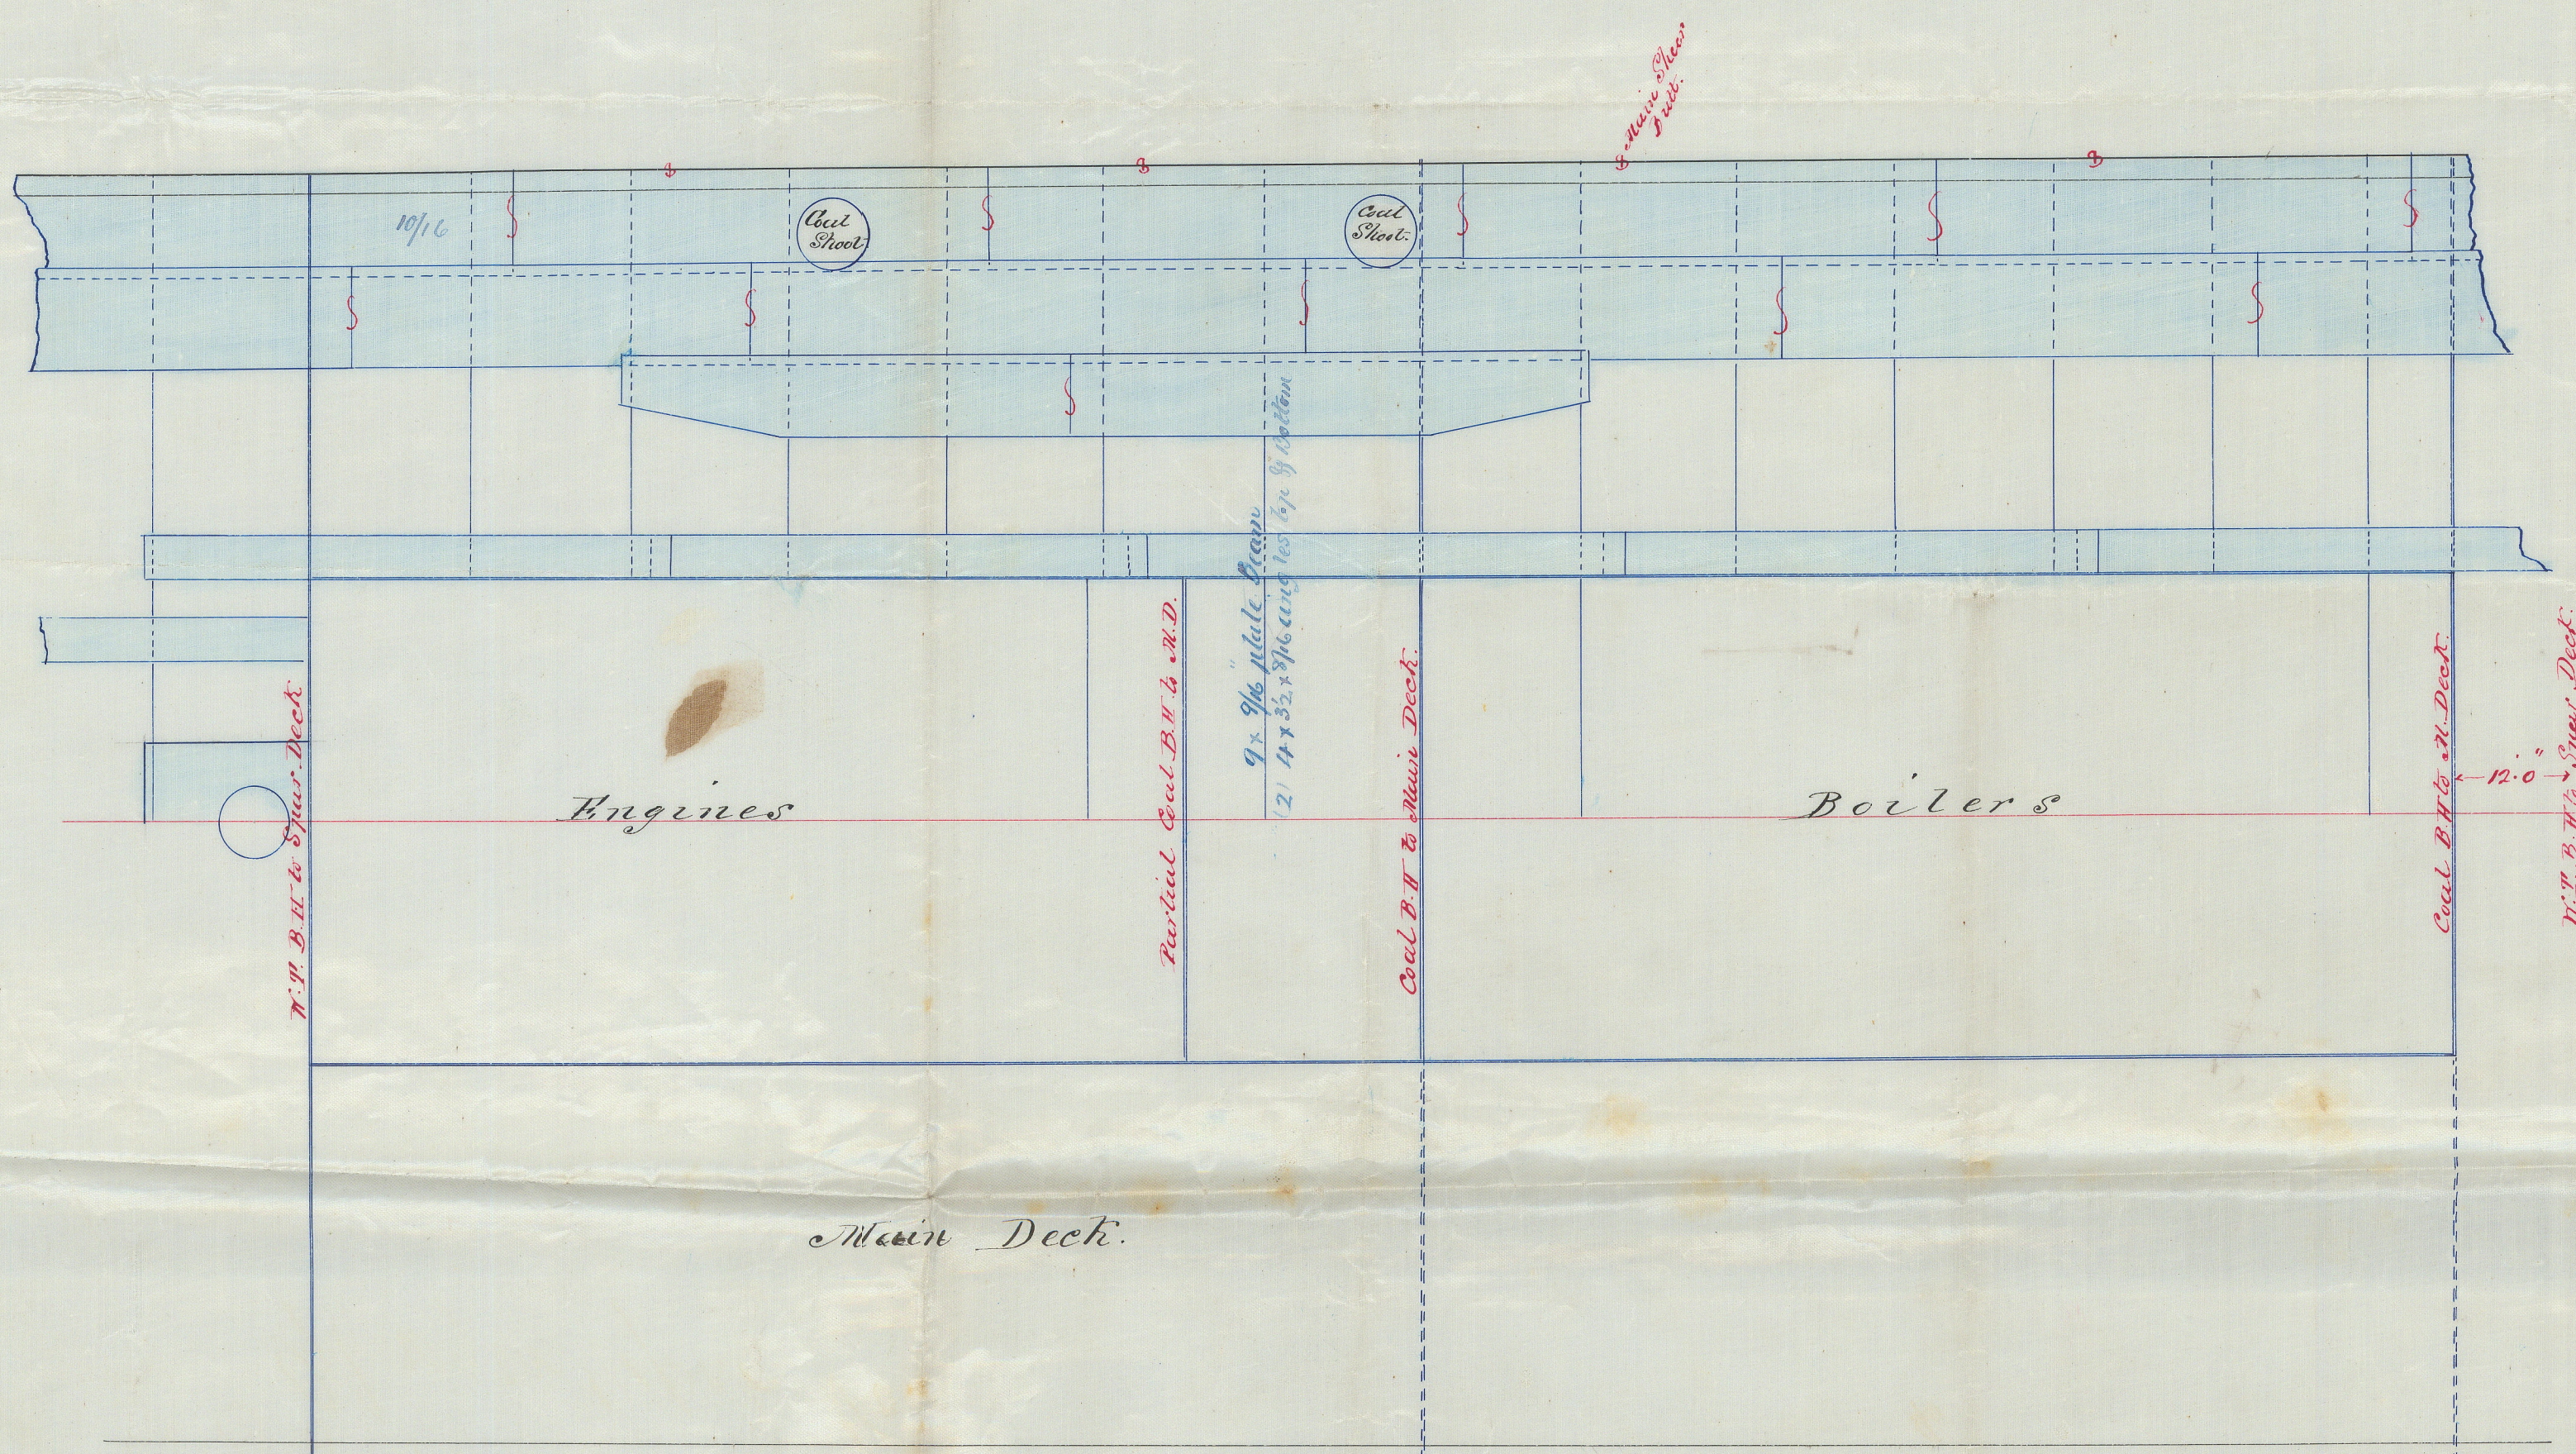

Spar Deck

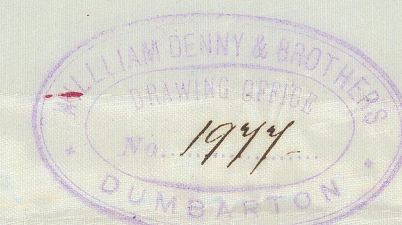

M.M.
 3/12/75