No 218 Ship

Ship "Scottish Chieftain" Scale ½ = 1 foot Report No 3646

16/12/75

Numbers for Scantlings

½ Breadth	19.1½
Depth	25.6½
Girth	38.6
	83.2

Length 223.5 × 83.166 = 18587 Scantlings
1239
~~20826~~ Equipment
19826

Dimensions.

Length over all	244.9
Do. B.P.	225.0
Breadth Moulded	38.3
Depth in Hold	23.6
Tonnage under deck about	1345 Tons.

Breadths 5 and under 6
Depths 8 . . 9

Class

100 A at Lloyds

Rev 13/1/76

Poop 41 ft long from Stern post
Forecastle 31 ft long

Poop Beams 1 angle ~~5½×3×7/16~~ 6½×3×9/16
" Stringer 24×⅜
" Ties 9×⅜
" Gunwale angle 6×3×⅜
" Side plating ⅜

Forecastle Beams Bulb 6×⅜
" " Angles 2½×2½×5/16
" Stringer 24×⅜
" Ties 9×⅜
" Gunwale angle 3×3×⅜ 3½×3×7/16
" Side plating ⅜

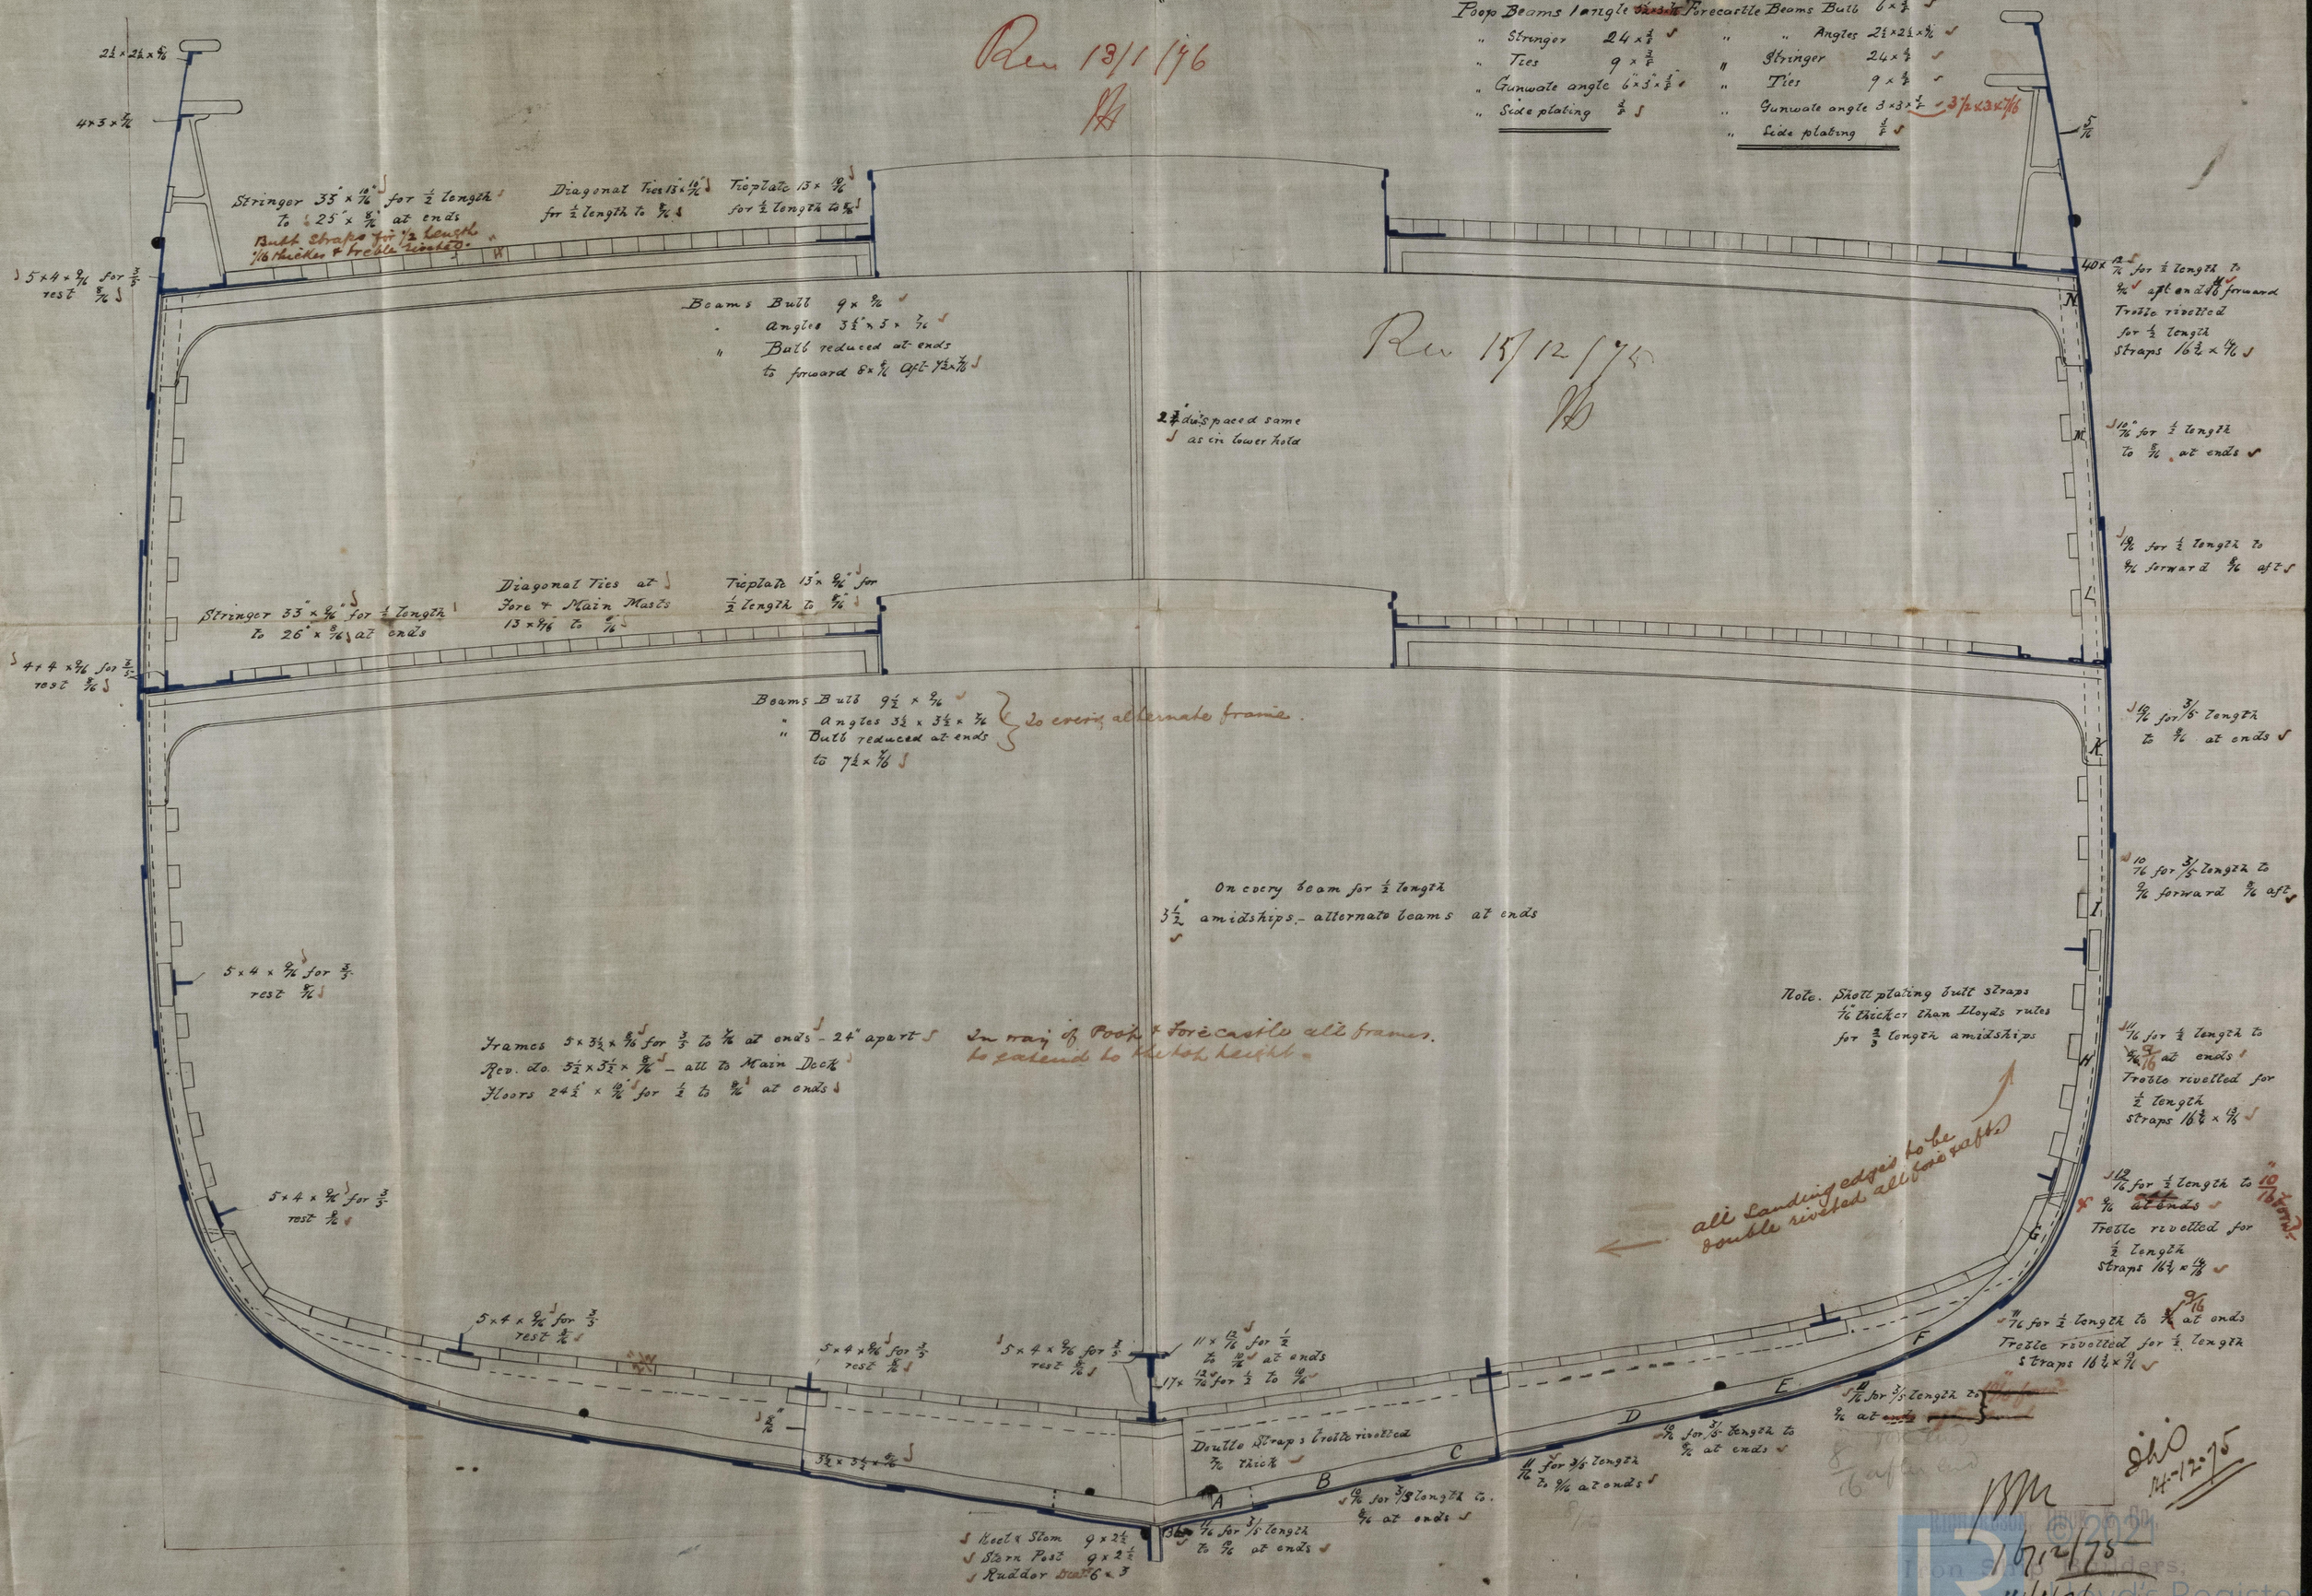

14-12-75

16/12/75

14/1/76

Richardson, Duck & Co.
Iron Ship Builders,
Stockton Hartlepool
Lloyd's Register Foundation
IRON516-0067