





$\frac{1}{2}$ Breadth 17.5 ✓

$\frac{1}{2}$ Girth 34.5 ✓

Depth 22.45 ✓

$\frac{22.93}{94.95} \checkmark$ $\frac{57}{100}$ Number

215.5






Rec 4/12/75-8/10/76

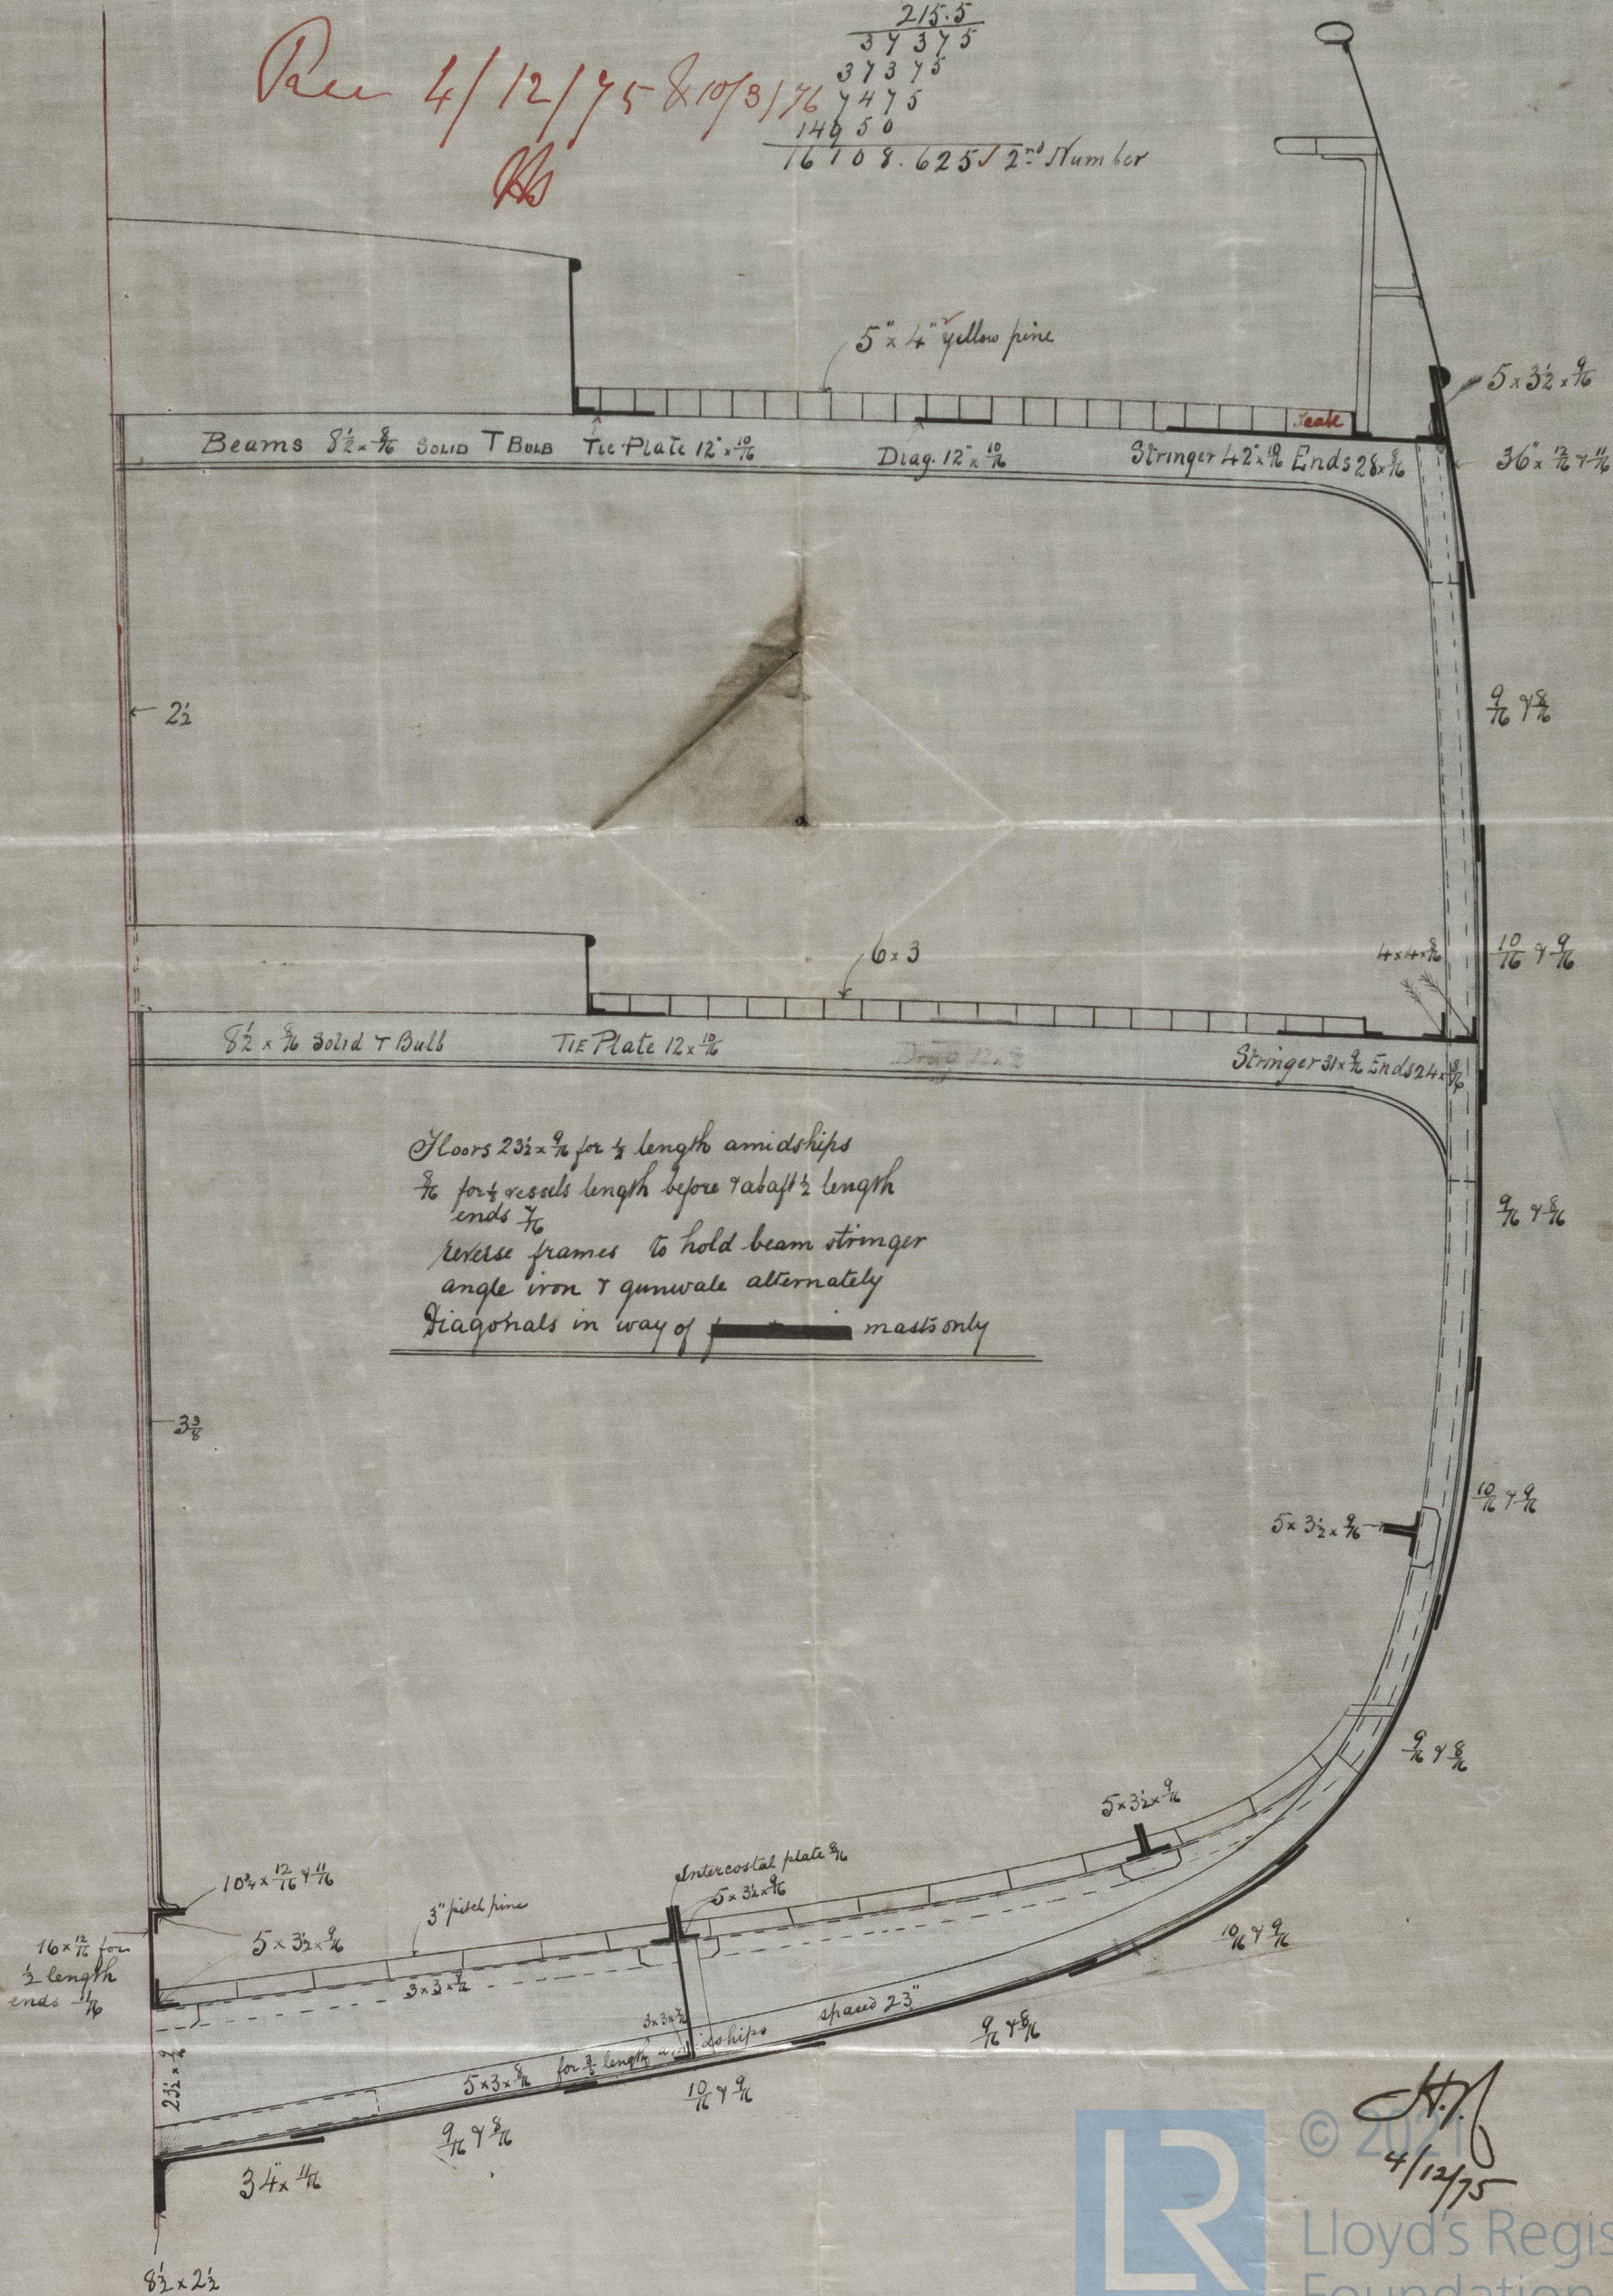

© 2021
4/12/75
Lloyd's Register
Foundation

IRONSIG-0073