



Section showing Cargo Port Ship 5/P  
 Scale 1" = 1 Foot. Dec 10/3/76

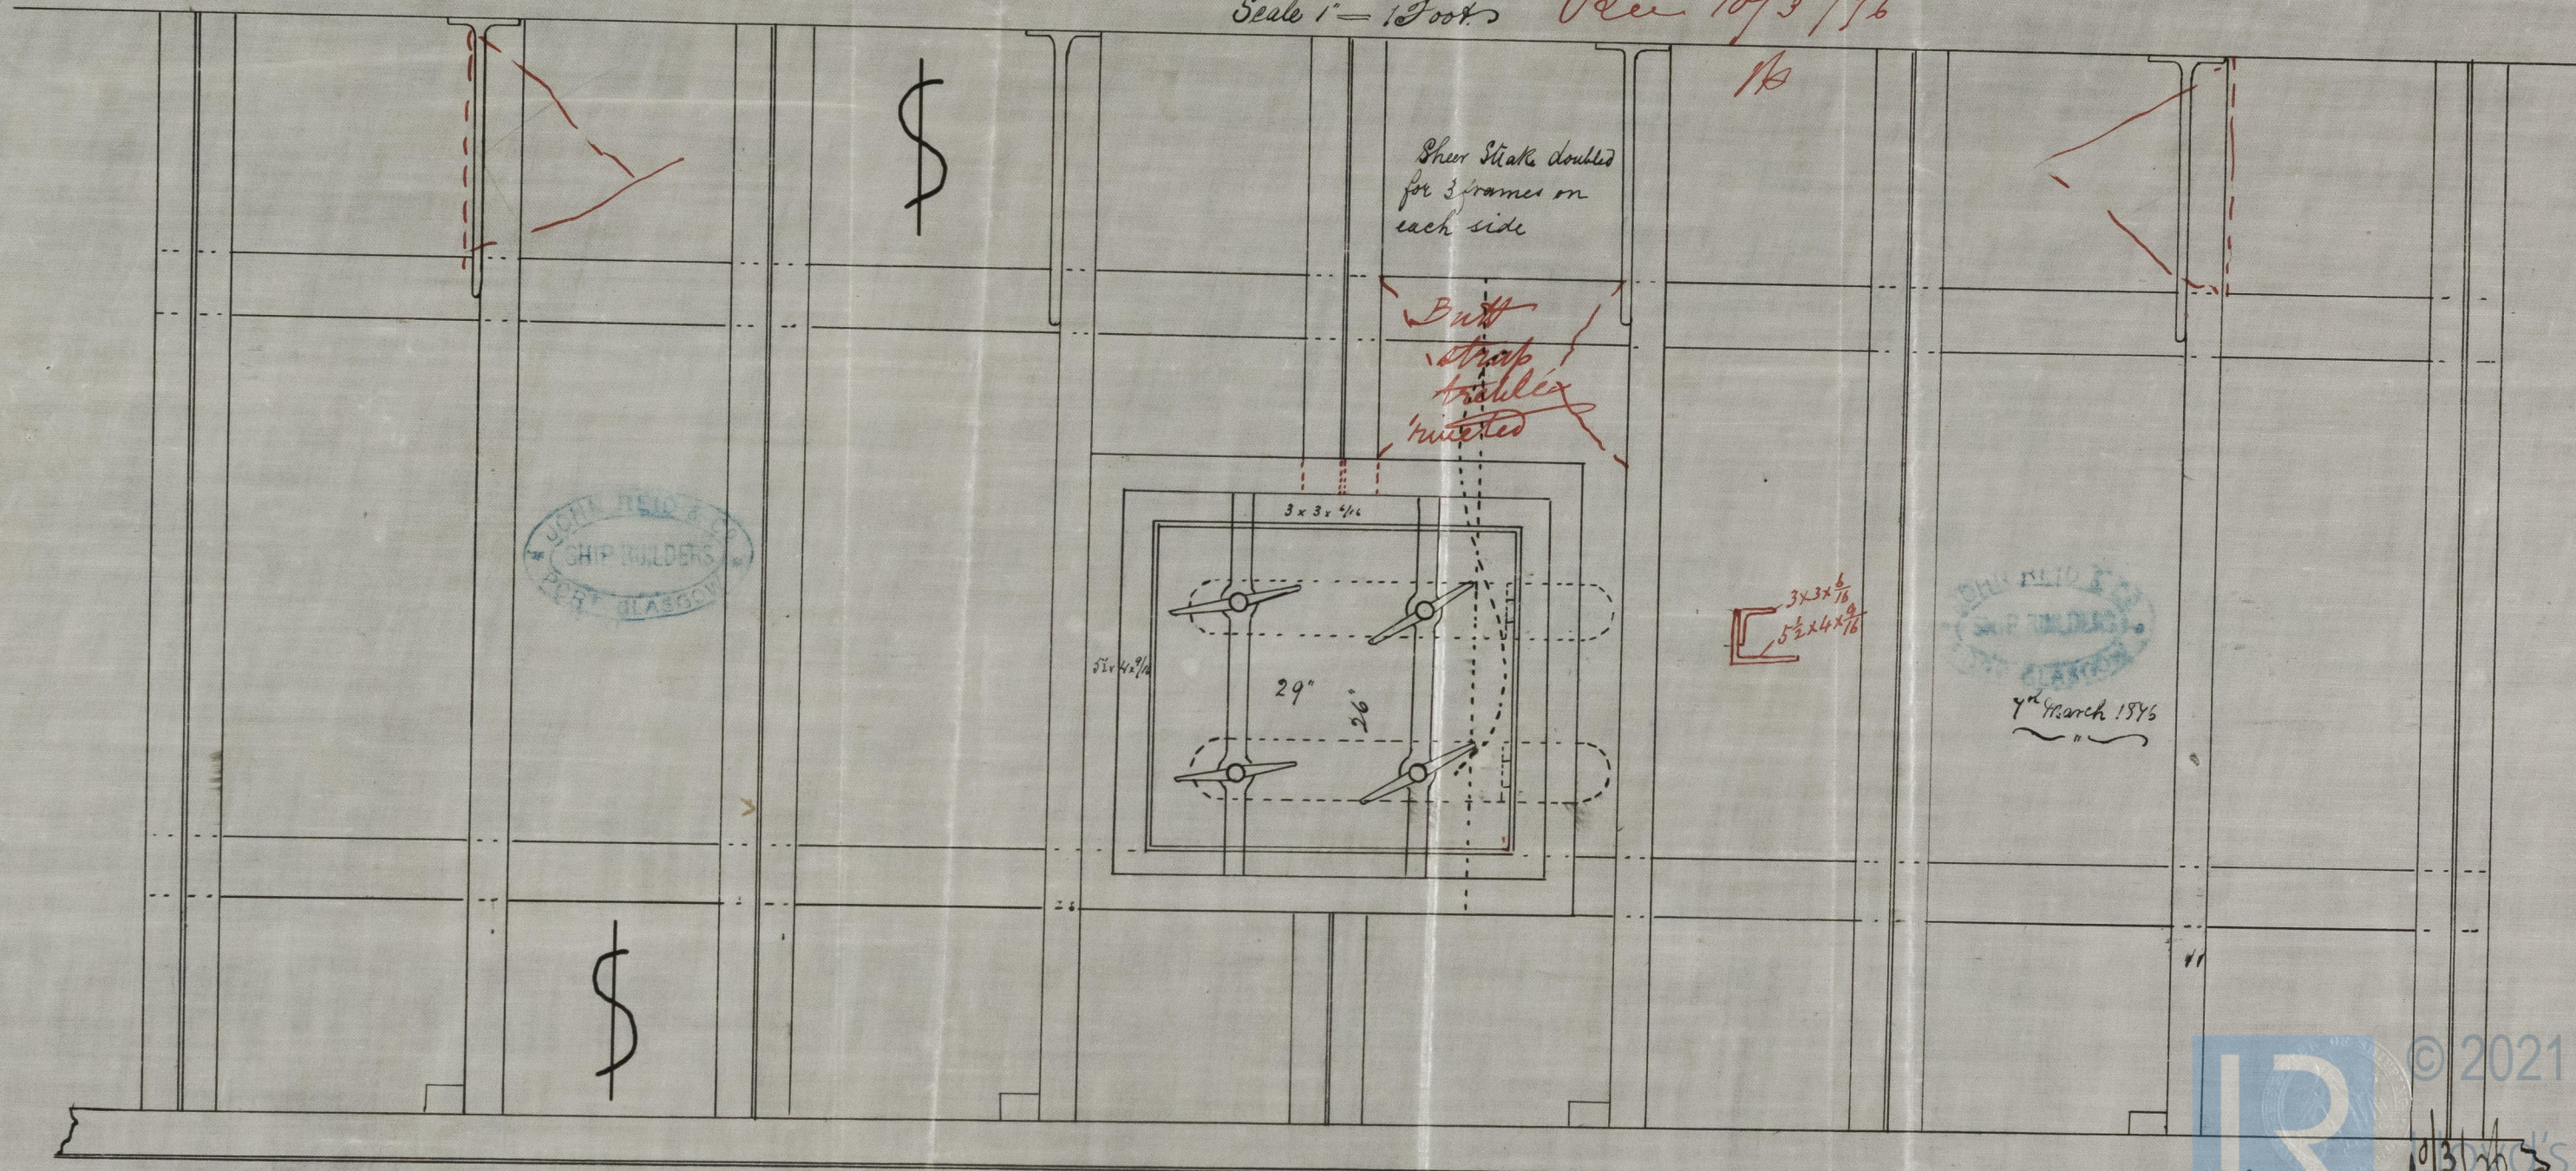

3 x 3 x 1/4  

 SHIP BUILDERS  
 PORT GLASGOW

7th March 1876

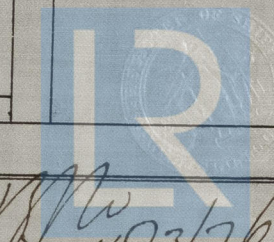

© 2021

Ships Register  
 Foundation

180516-0075

1876  
 10/3/76