


MAIN DECK PLAN S. S. N 208.

Kaitaki

Glasgow Report No 4257

Length between Perpendiculars 105' 2" *Dec 26/11/75*
 Breadth Extreme 21' 3 1/2"
 Depth Moulded 10' 8 1/2"

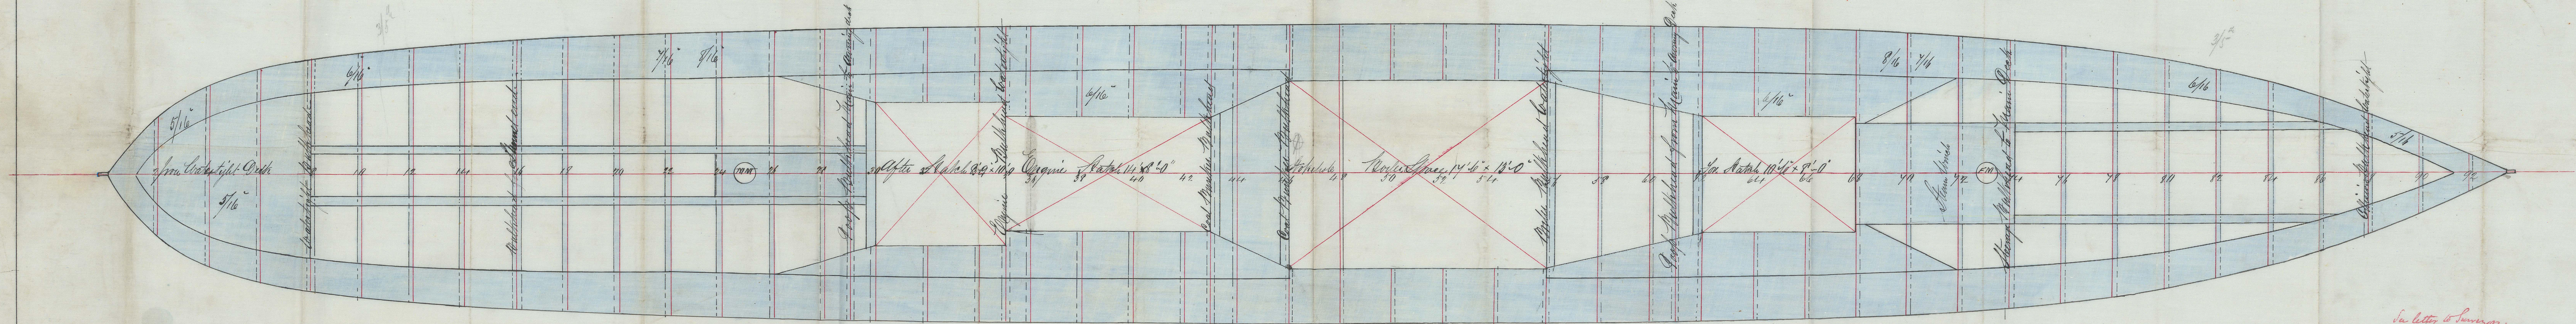

SCALE 1 INCH EQUAL TO 4 FEET

In letter to Parsons 27/1/75
 The Wingate & Co.
 ENGINEERS & SHIPBUILDERS
 17, AUSTIN, 23rd November 1875

180516-0088