



27/11/75

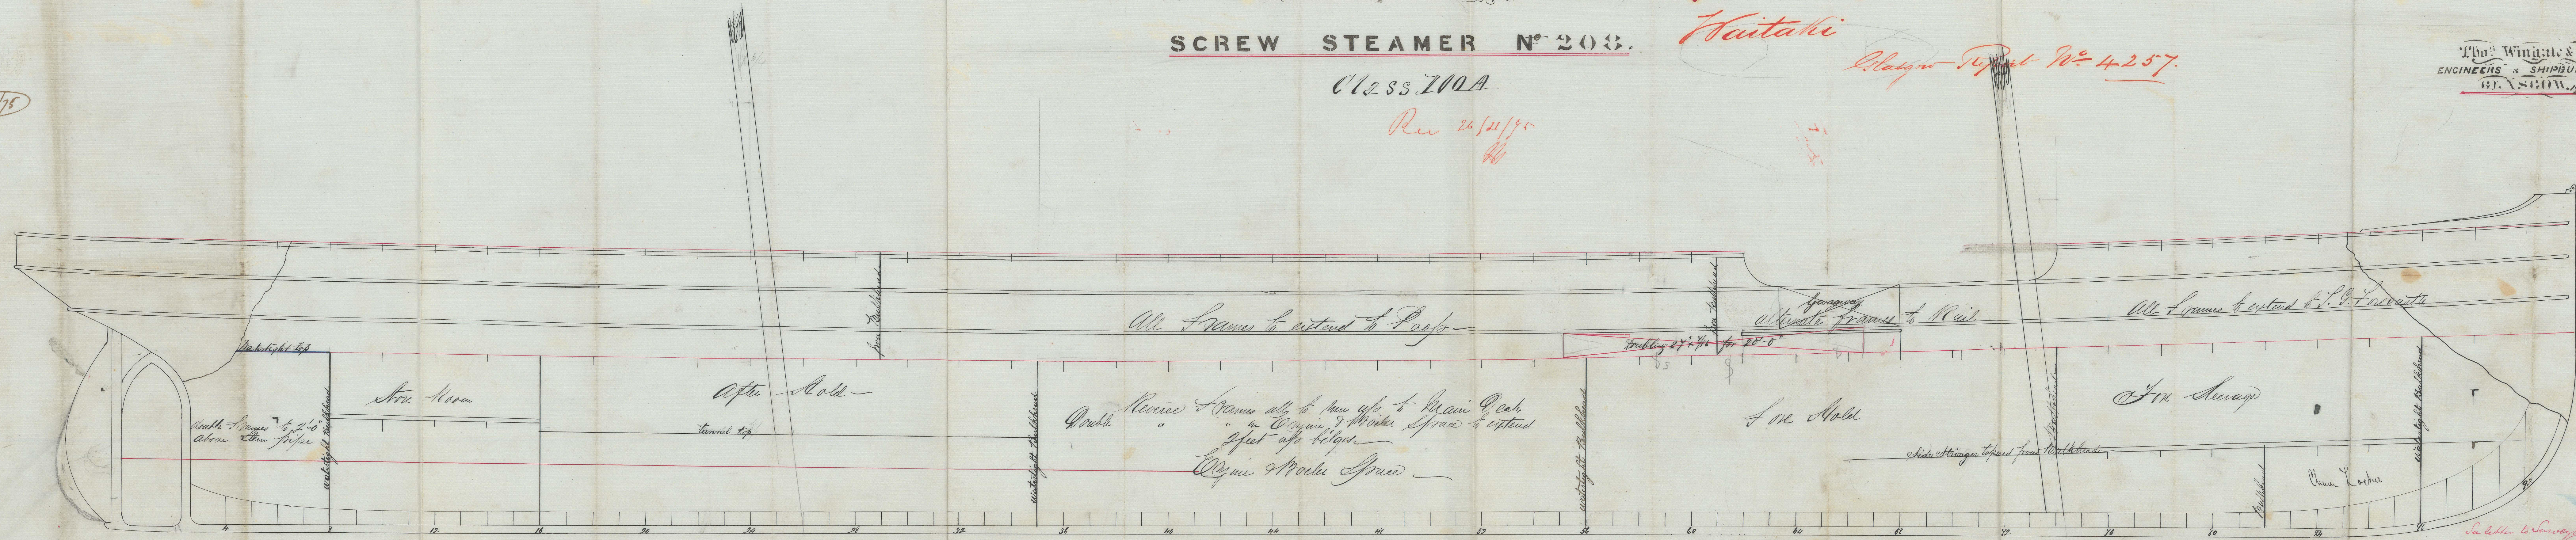

SCALE  $\frac{1}{4}$  INCH EQUAL TO A FOOT

See letter to Surveyors. 27/11/75  
L.S.