

14/12/5

—SCALE:  $\frac{3}{4}$  INCH = 1 FOOT—


-DIMENSIONS-

Length of Keel and Trawler	235'0"
Breadth Moulded	29'6"
Depth ——" —"	17'6"
—" in Hold to top of keeling	16'4½"

Class 100A.

Rec 18/12/45

Traced by effects  
Compared by MS. of R.H.

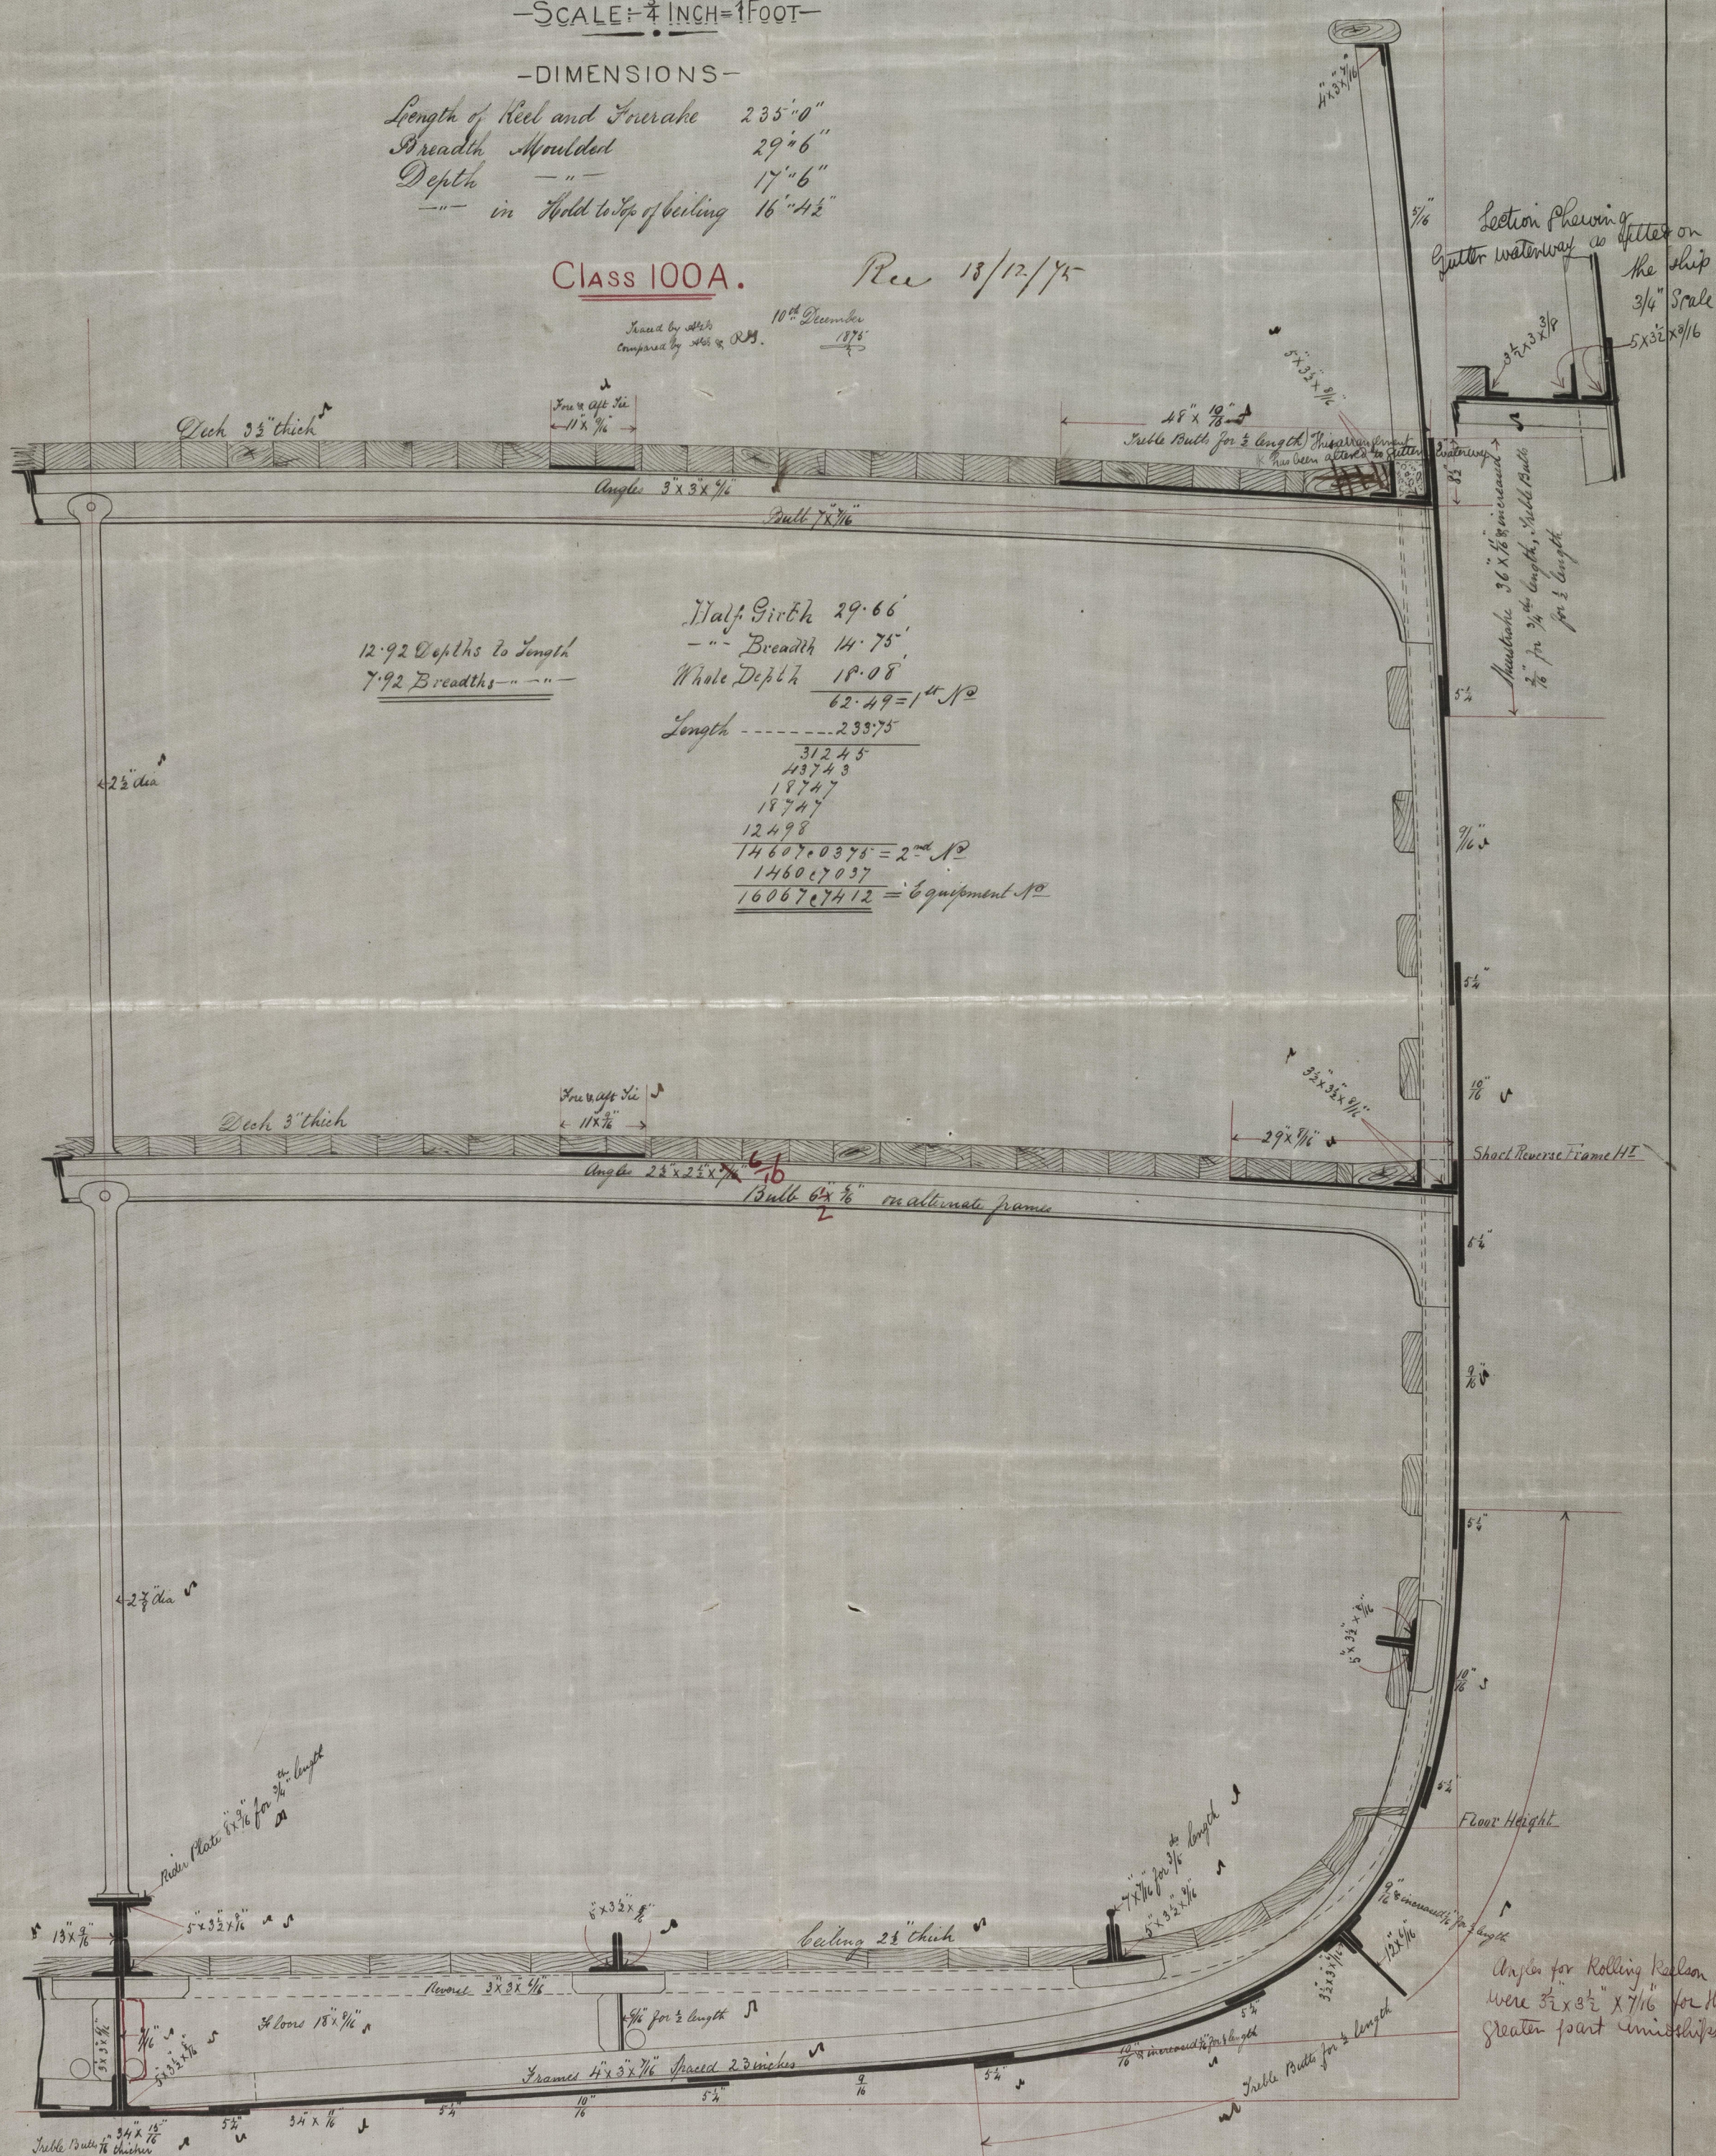

Angles for Rolling Keelson  
were  $3\frac{1}{2} \times 3\frac{1}{2} \times 7\frac{1}{16}$  for the  
greater part of the ship.