


25/11/76

N^o 170 Ship. Plan Shewing Position of Hold Beams

Scale $\frac{1}{8}$ " inch = 1 foot

Rev 25/11/76

"Arago"

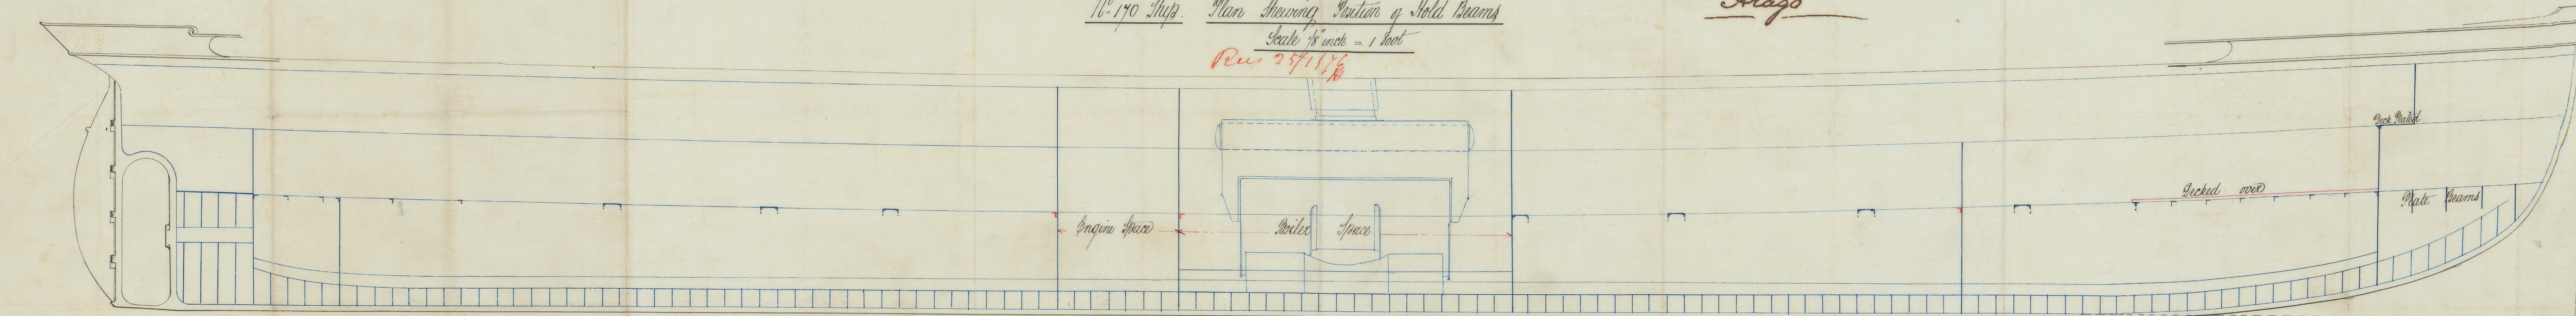

IRONS16-0099