

Midship Section S.S. Queen


Scale $\frac{1}{4}$ Inch = 1 foot

to Class 90 or 100 A

Frames Spaced 18 Inches Centre to Centre

21-3-76
JN

Rev 23/3/76
JN

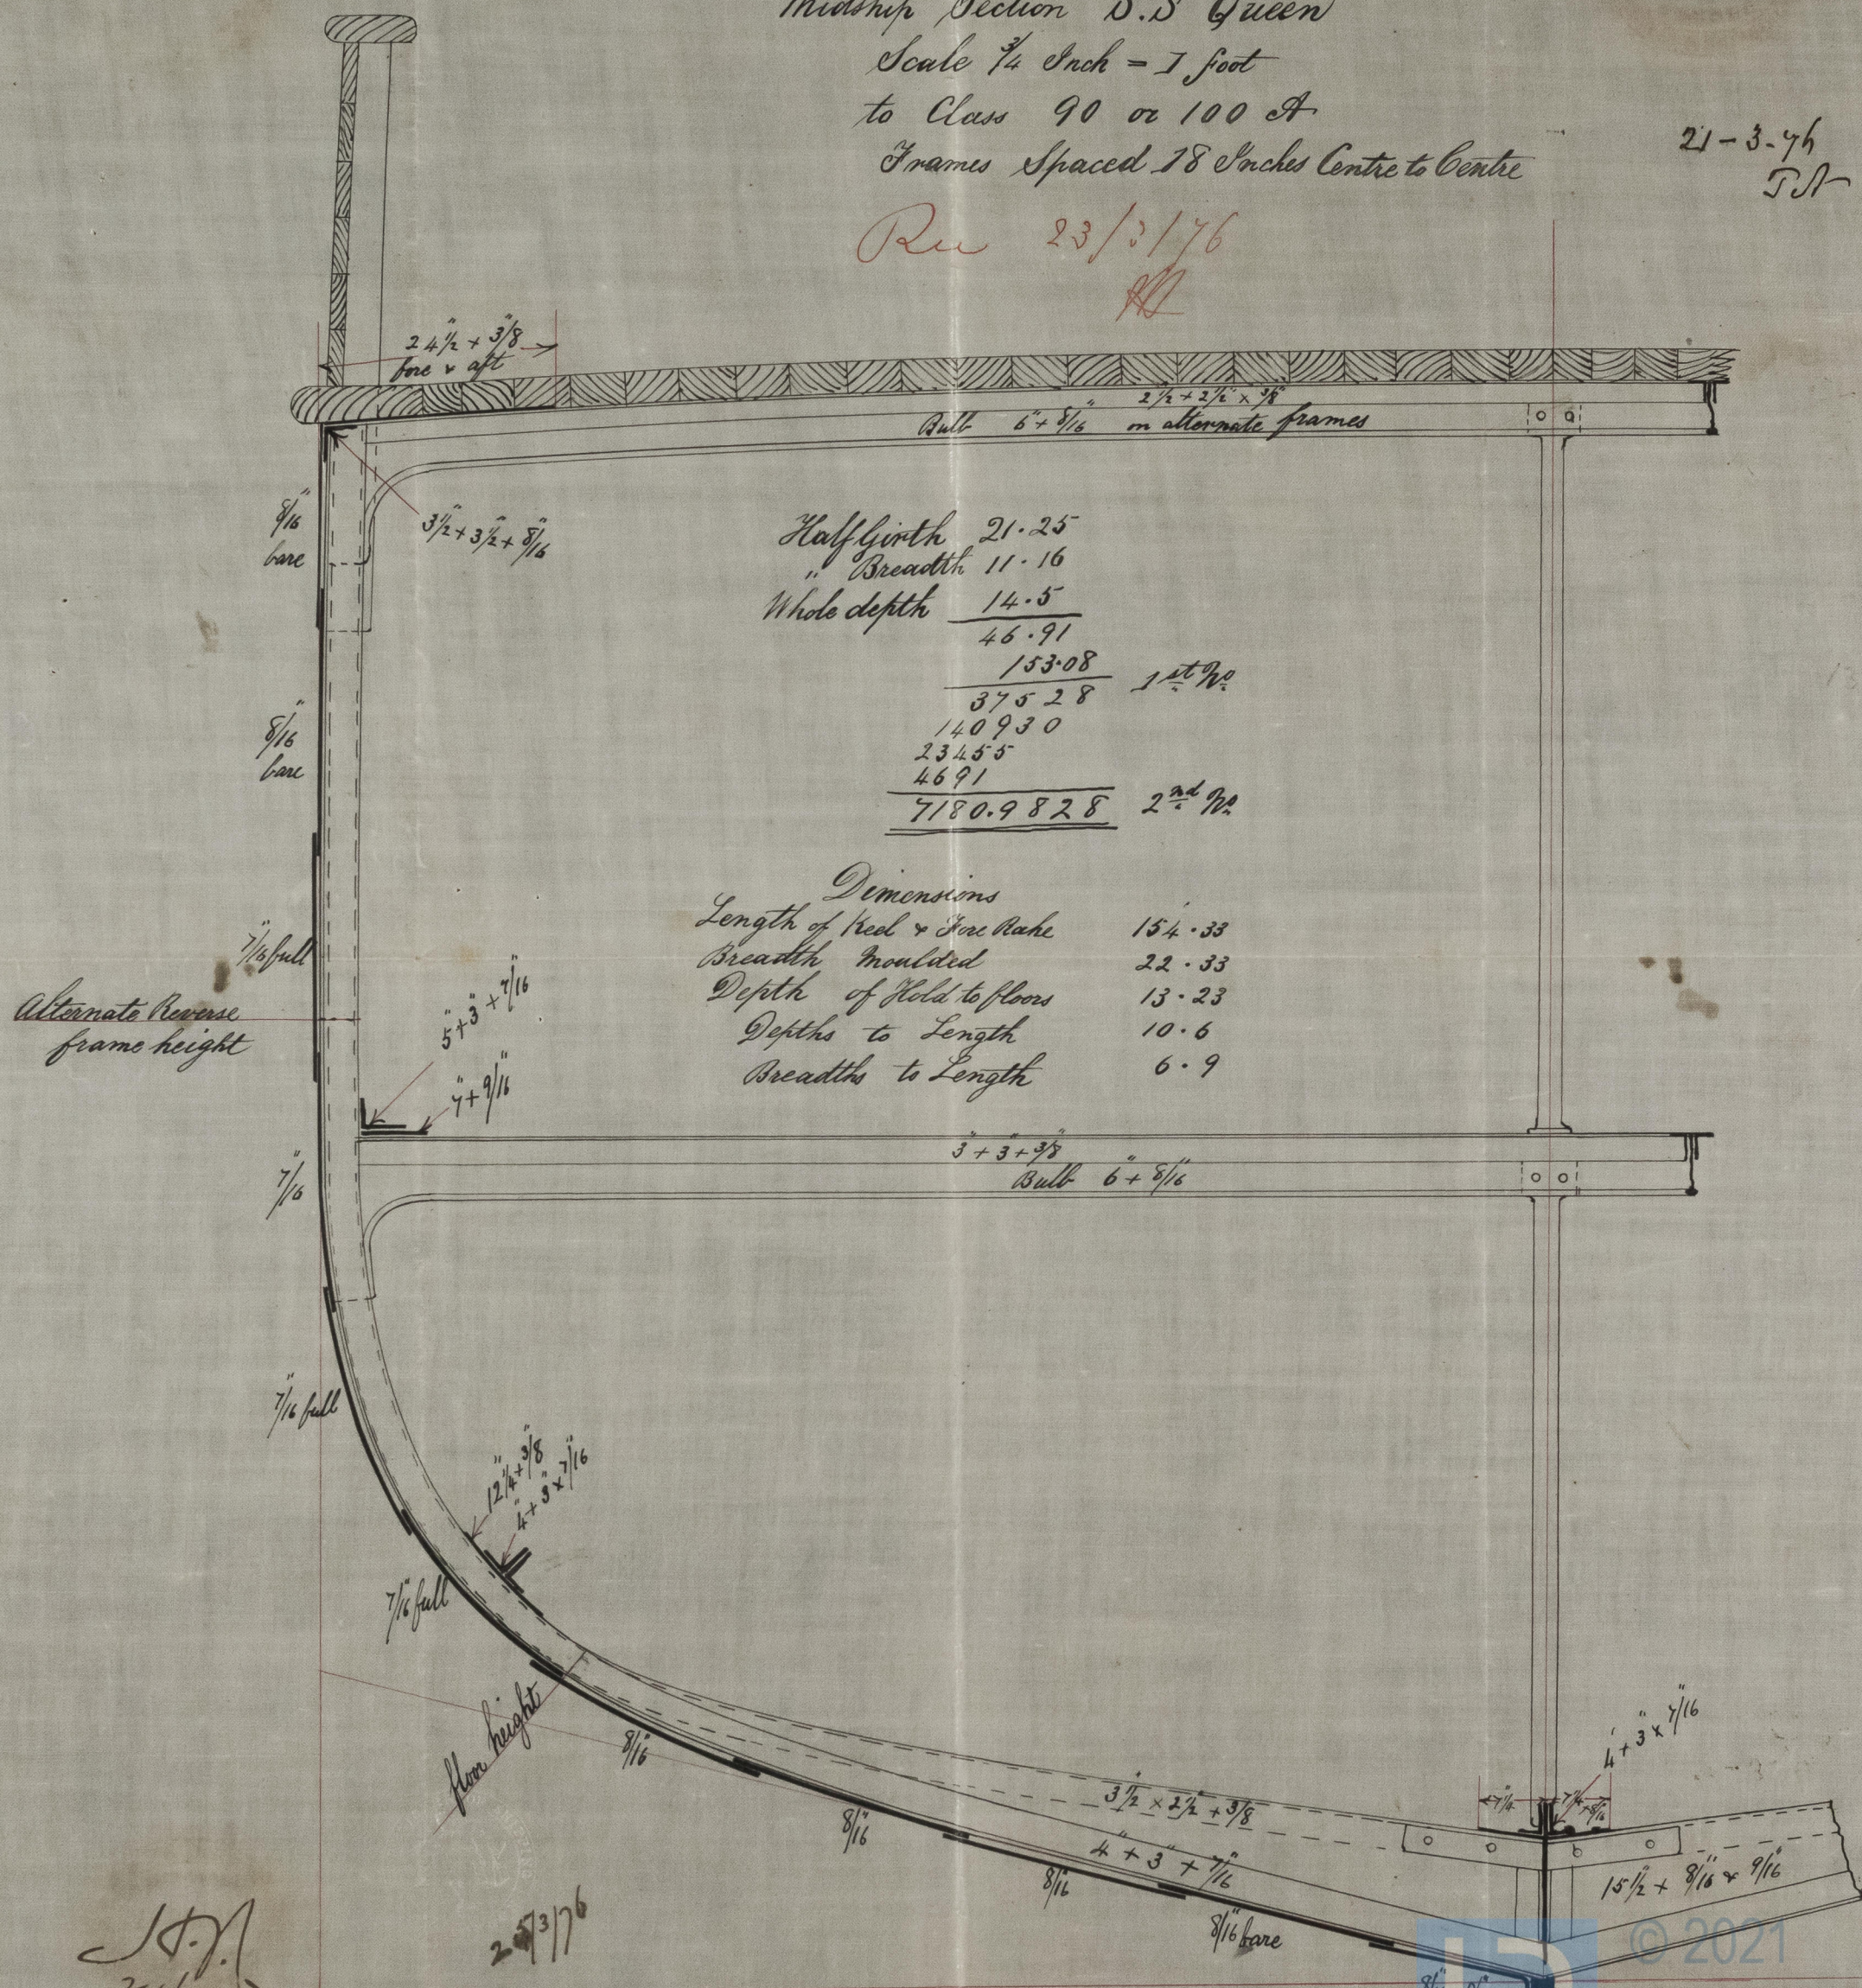

J.N.
24/3/76

24/3/76