


Bk Cadlys
Glasgow Report No 4265

20/12/75

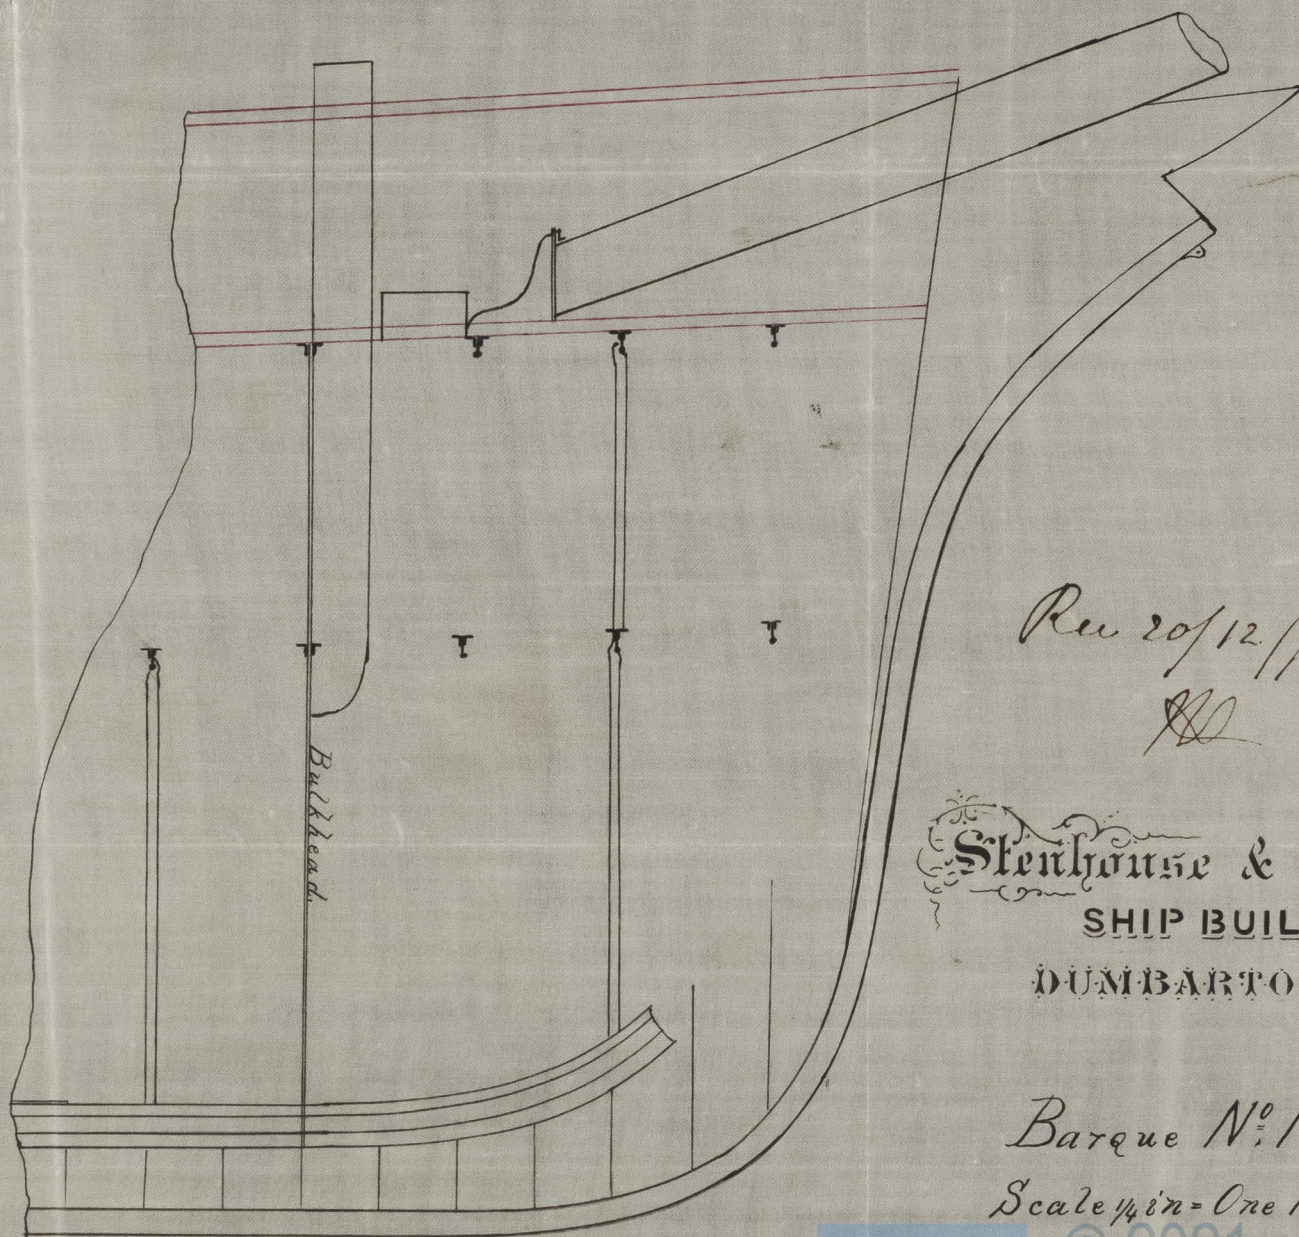

Rev 20/12/94

[Signature]

Stenhouse & Co
SHIP BUILDERS.
DUMBARTON.

15/12/75
[Signature]

Barque No 13

Scale 1/4 in = One Foot.

© 2021
W. L. M.
18th
20/12/75
Lloyd's Register
Foundation

RON 516 - 0202