

BK Cadlys.

Barque No 4265

Midship Section Barque N°13

to Class 100A at Lloyds

Re 20/12/75

Half Moulded Girth.....28.10


Breadth.....13.75

Depth from top of keel.....18.55

Large N° Outfit N°

60.40 x 154 = 9301. 9921.

20/12/75

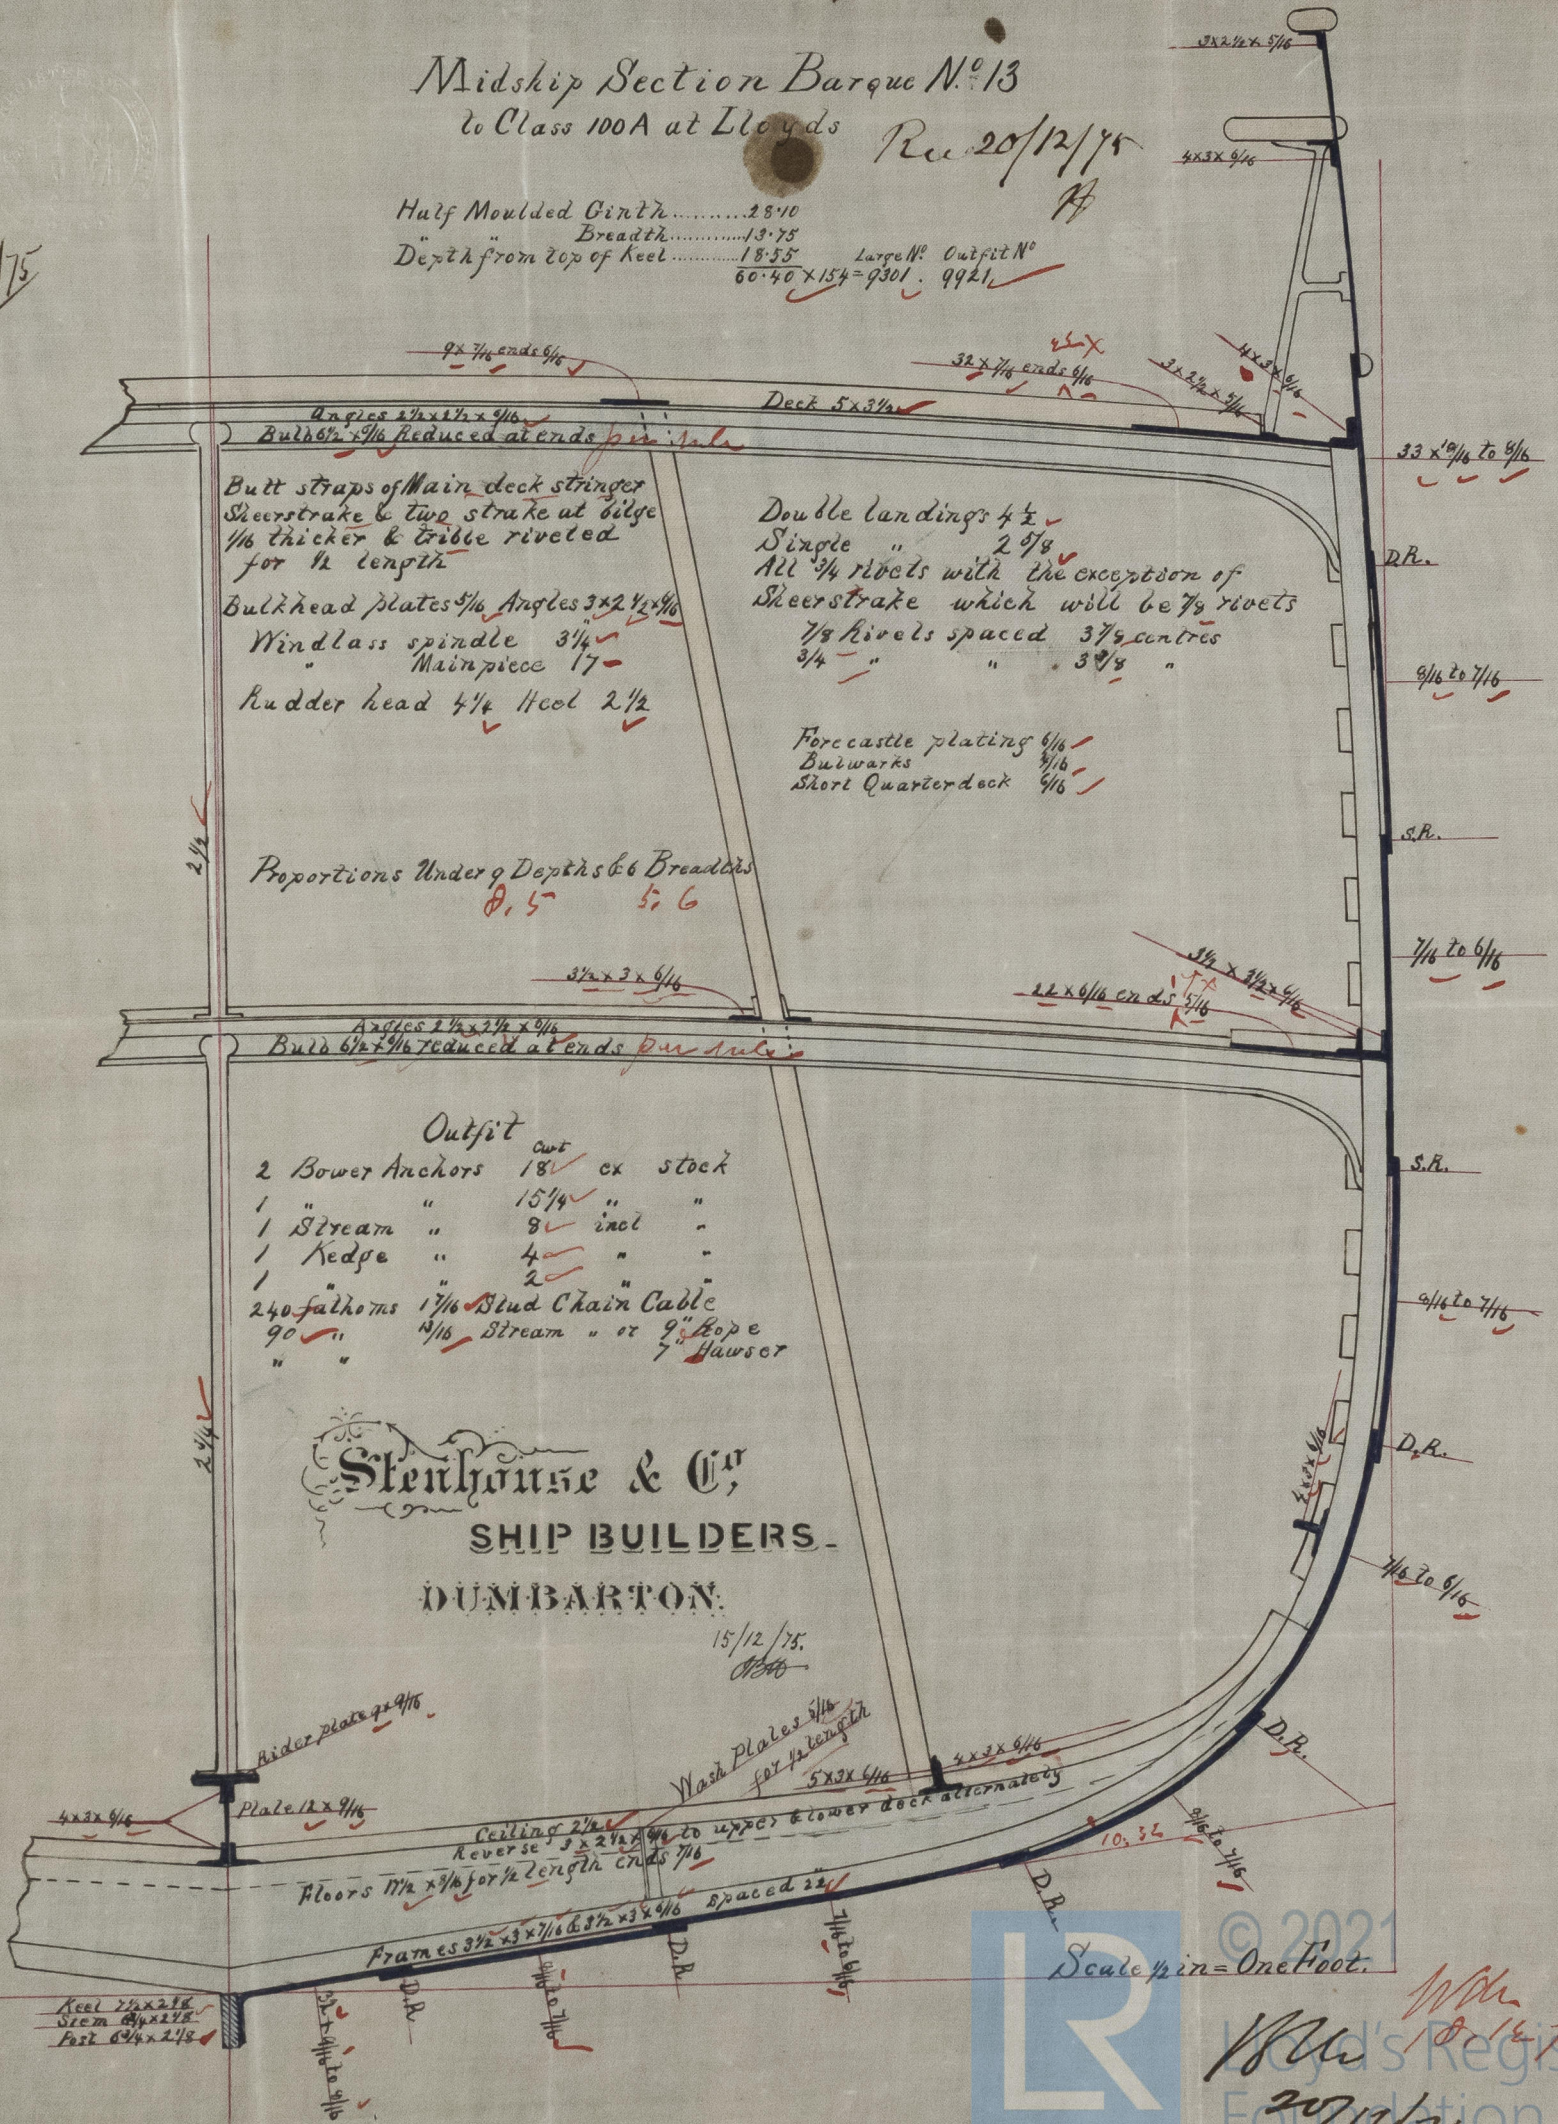

IRON 516-0203