

6/1/76

"Claf Juggeson". Report No 13285.

S.S. No 97

MIDSHIP ~ SECTION

Dimensions

Length between perps 176 feet.
 Breadth of Beam 25 feet
 Depth (moulded) 13 ft - 9 ins

Scale $\frac{1}{2}$ IN = 1 FOOT.

Rev 1/1/76

To class 100 A. (sunning deck) at Lloyd's.

Dimensions required for scantlings.


Length on deck 175 ft.
 Beam 25 ft.
 Depth to main deck 14 ft.
 $\frac{1}{2}$ girth to main deck 23 feet.

DEC-775.

$\frac{1}{2}$ moulded breadth 12'-6"
 Depth from top of keel
 to top of main deck beams } 14'-0"

$\frac{1}{2}$ girth of midships } 23'-0" L. 2nd NA
 Section to main deck } 49.5 x 175 = 8662.

Breadth to length " 7
 Depth " 12.5

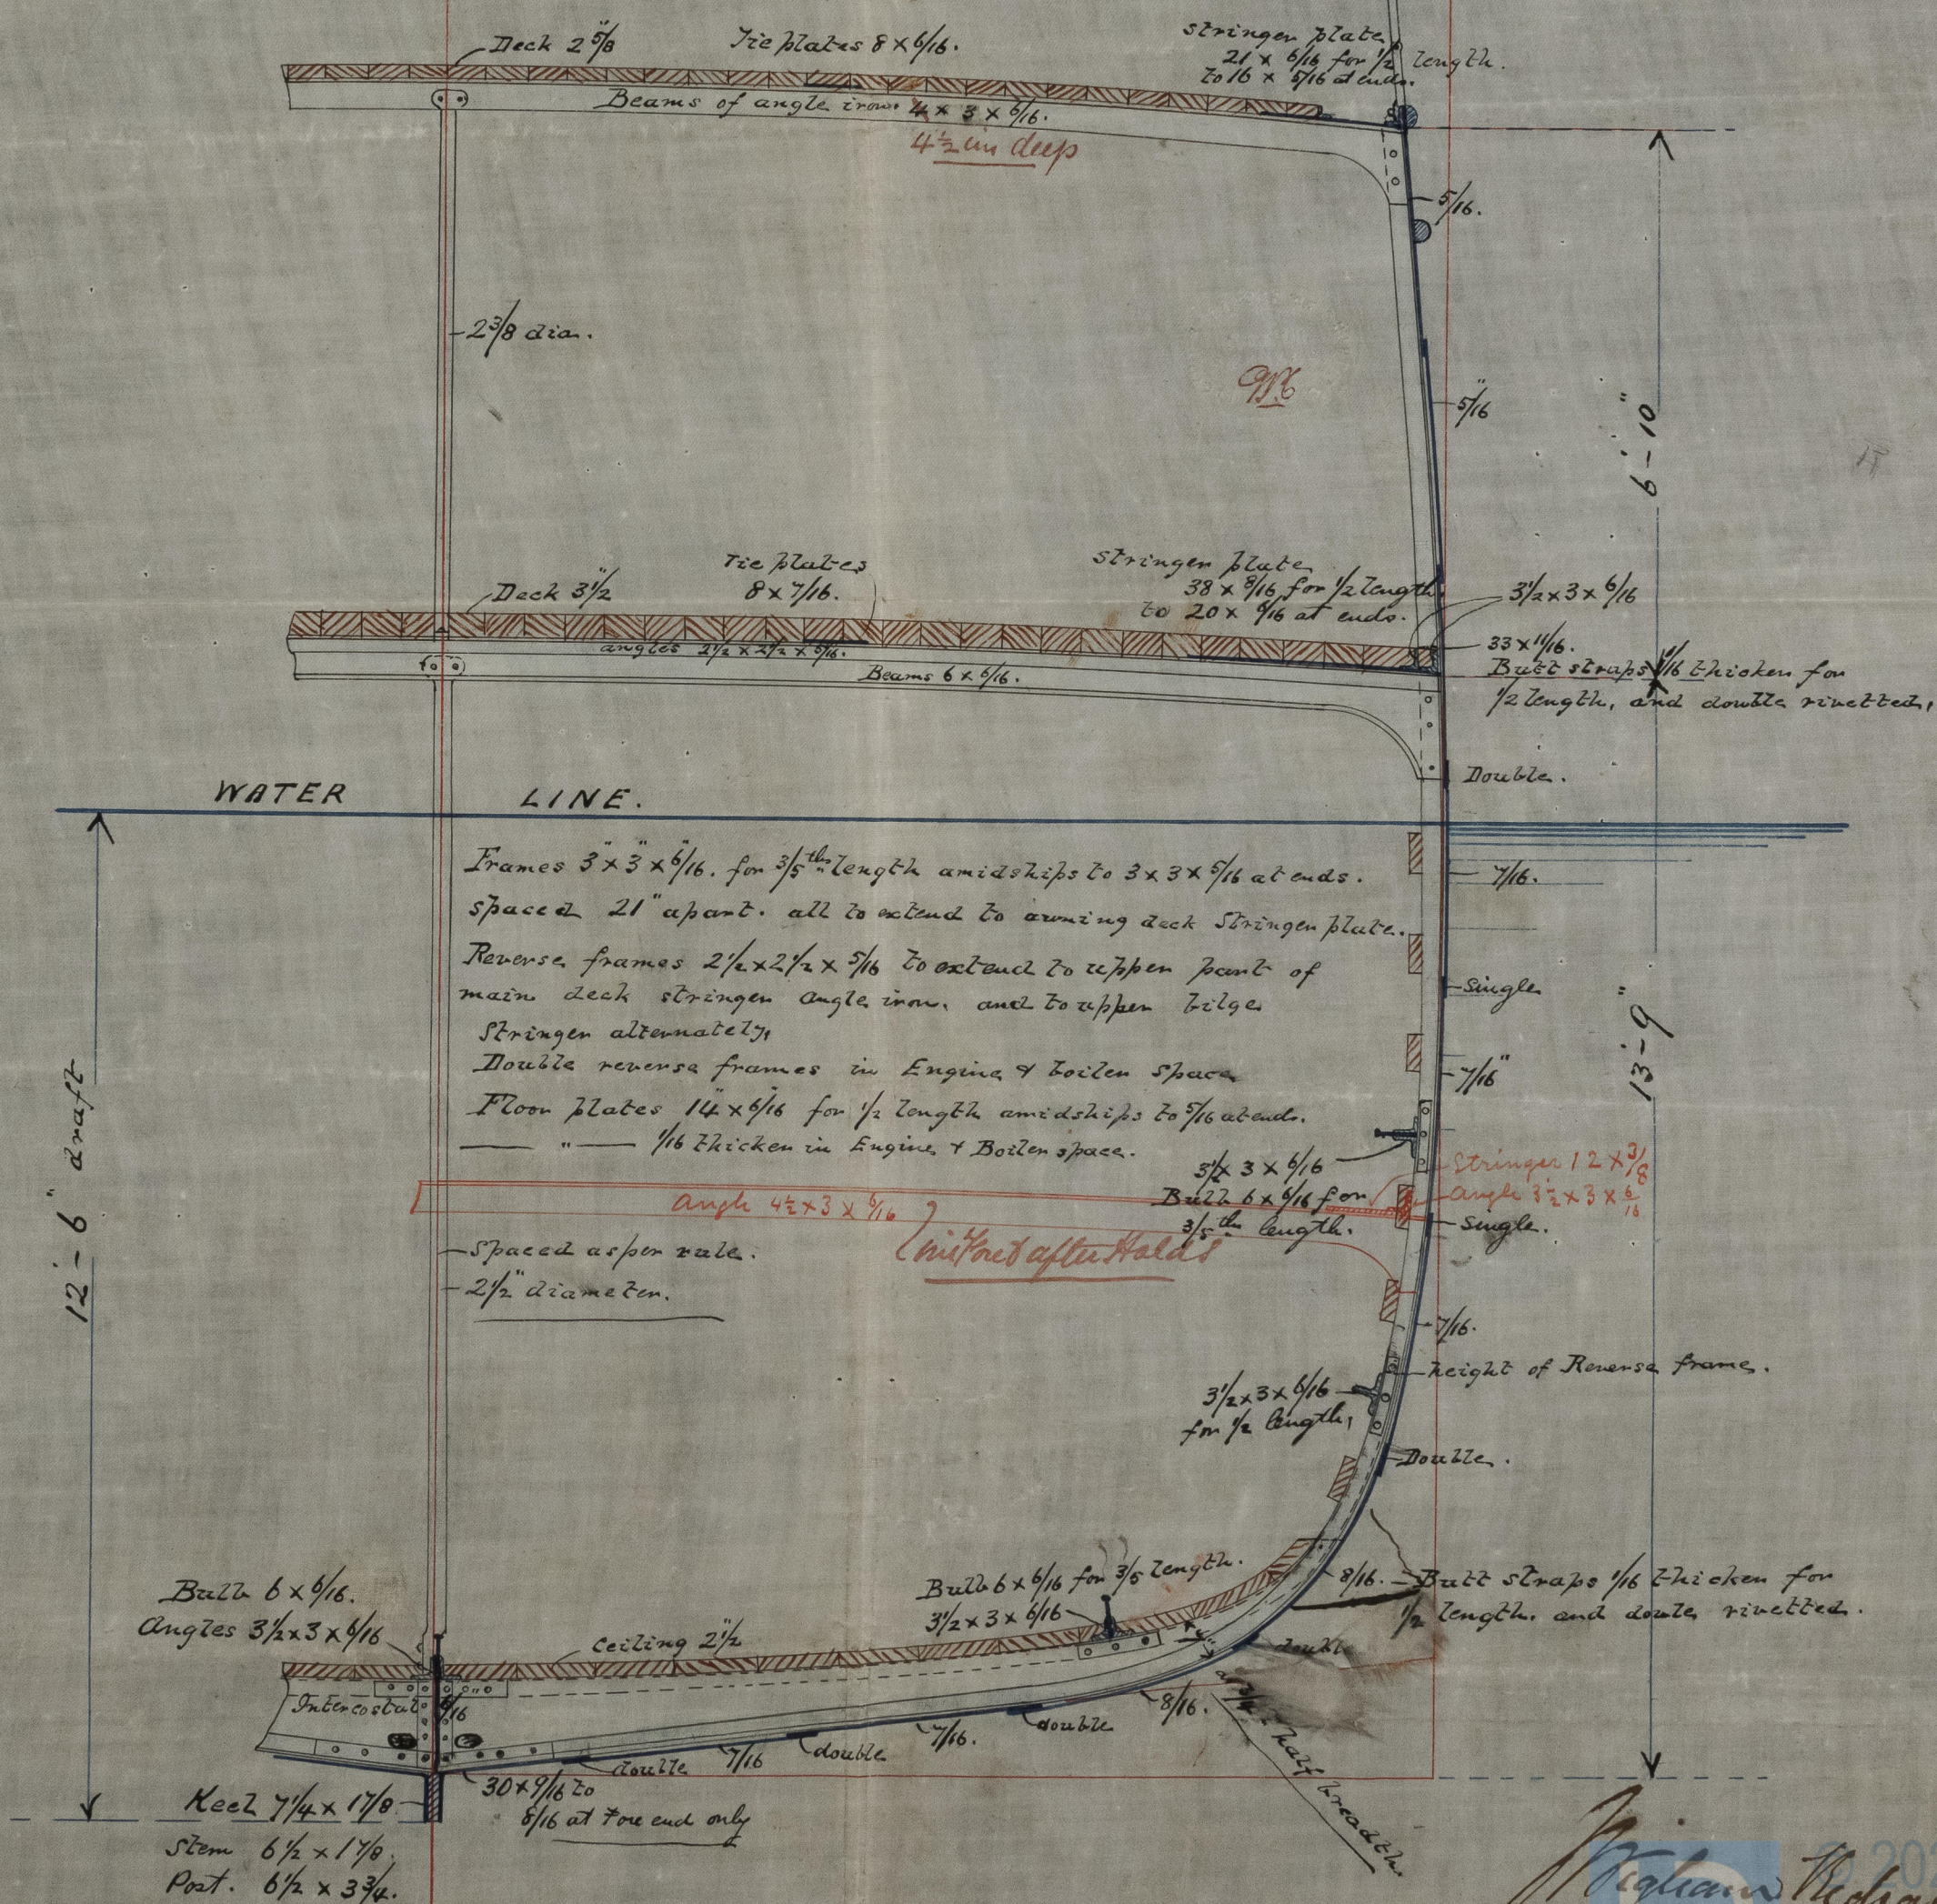

Richardson 18
 Lloyd's Register
 30th Dec 75