


S. J. N<sup>o</sup> 218

Scale  $\frac{1}{8}$ " = 1 foot.

B

Sew. Sr. "Rouen" report N<sup>o</sup> 11.463

July 10<sup>th</sup>  
1876.

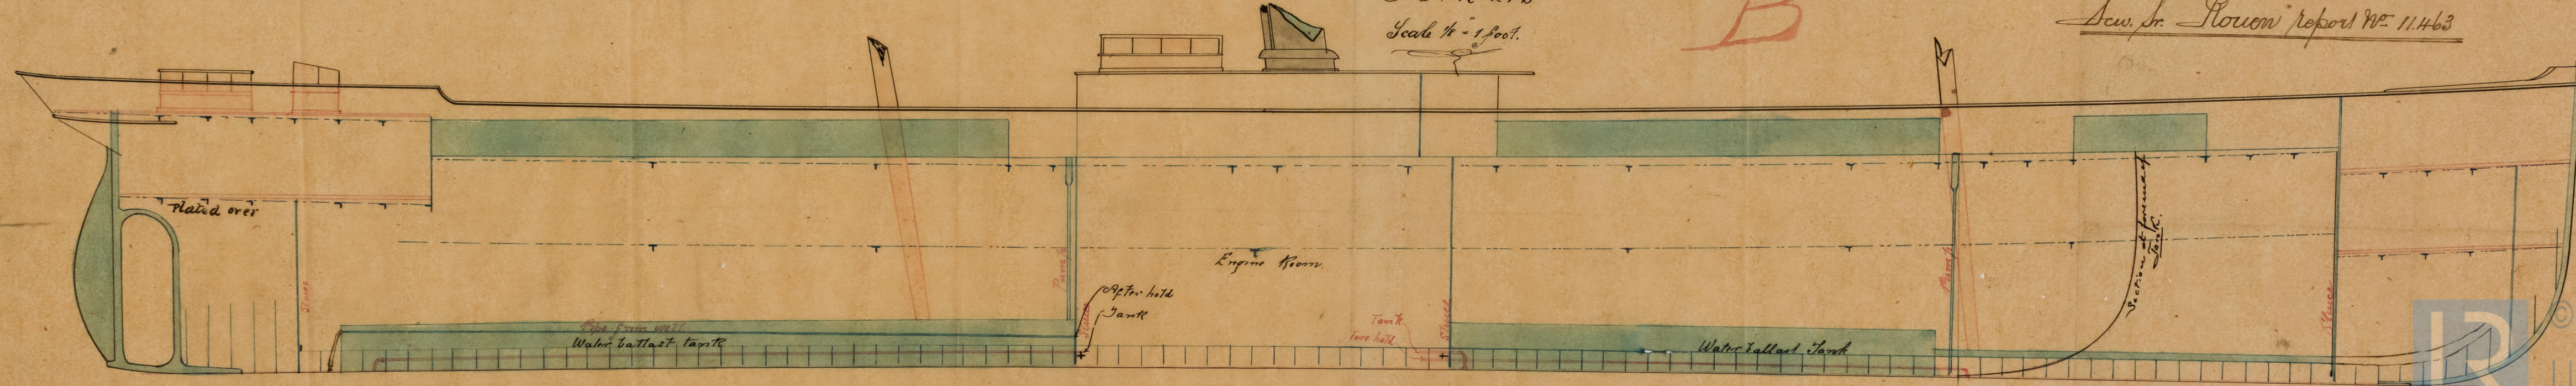

© 2021  
Lloyd's Register  
Foundation

IRON 517-0014