


March 3<sup>rd</sup>  
1876.

Scale  $\frac{1}{2}$ " = one foot.

Rev 10/8/76

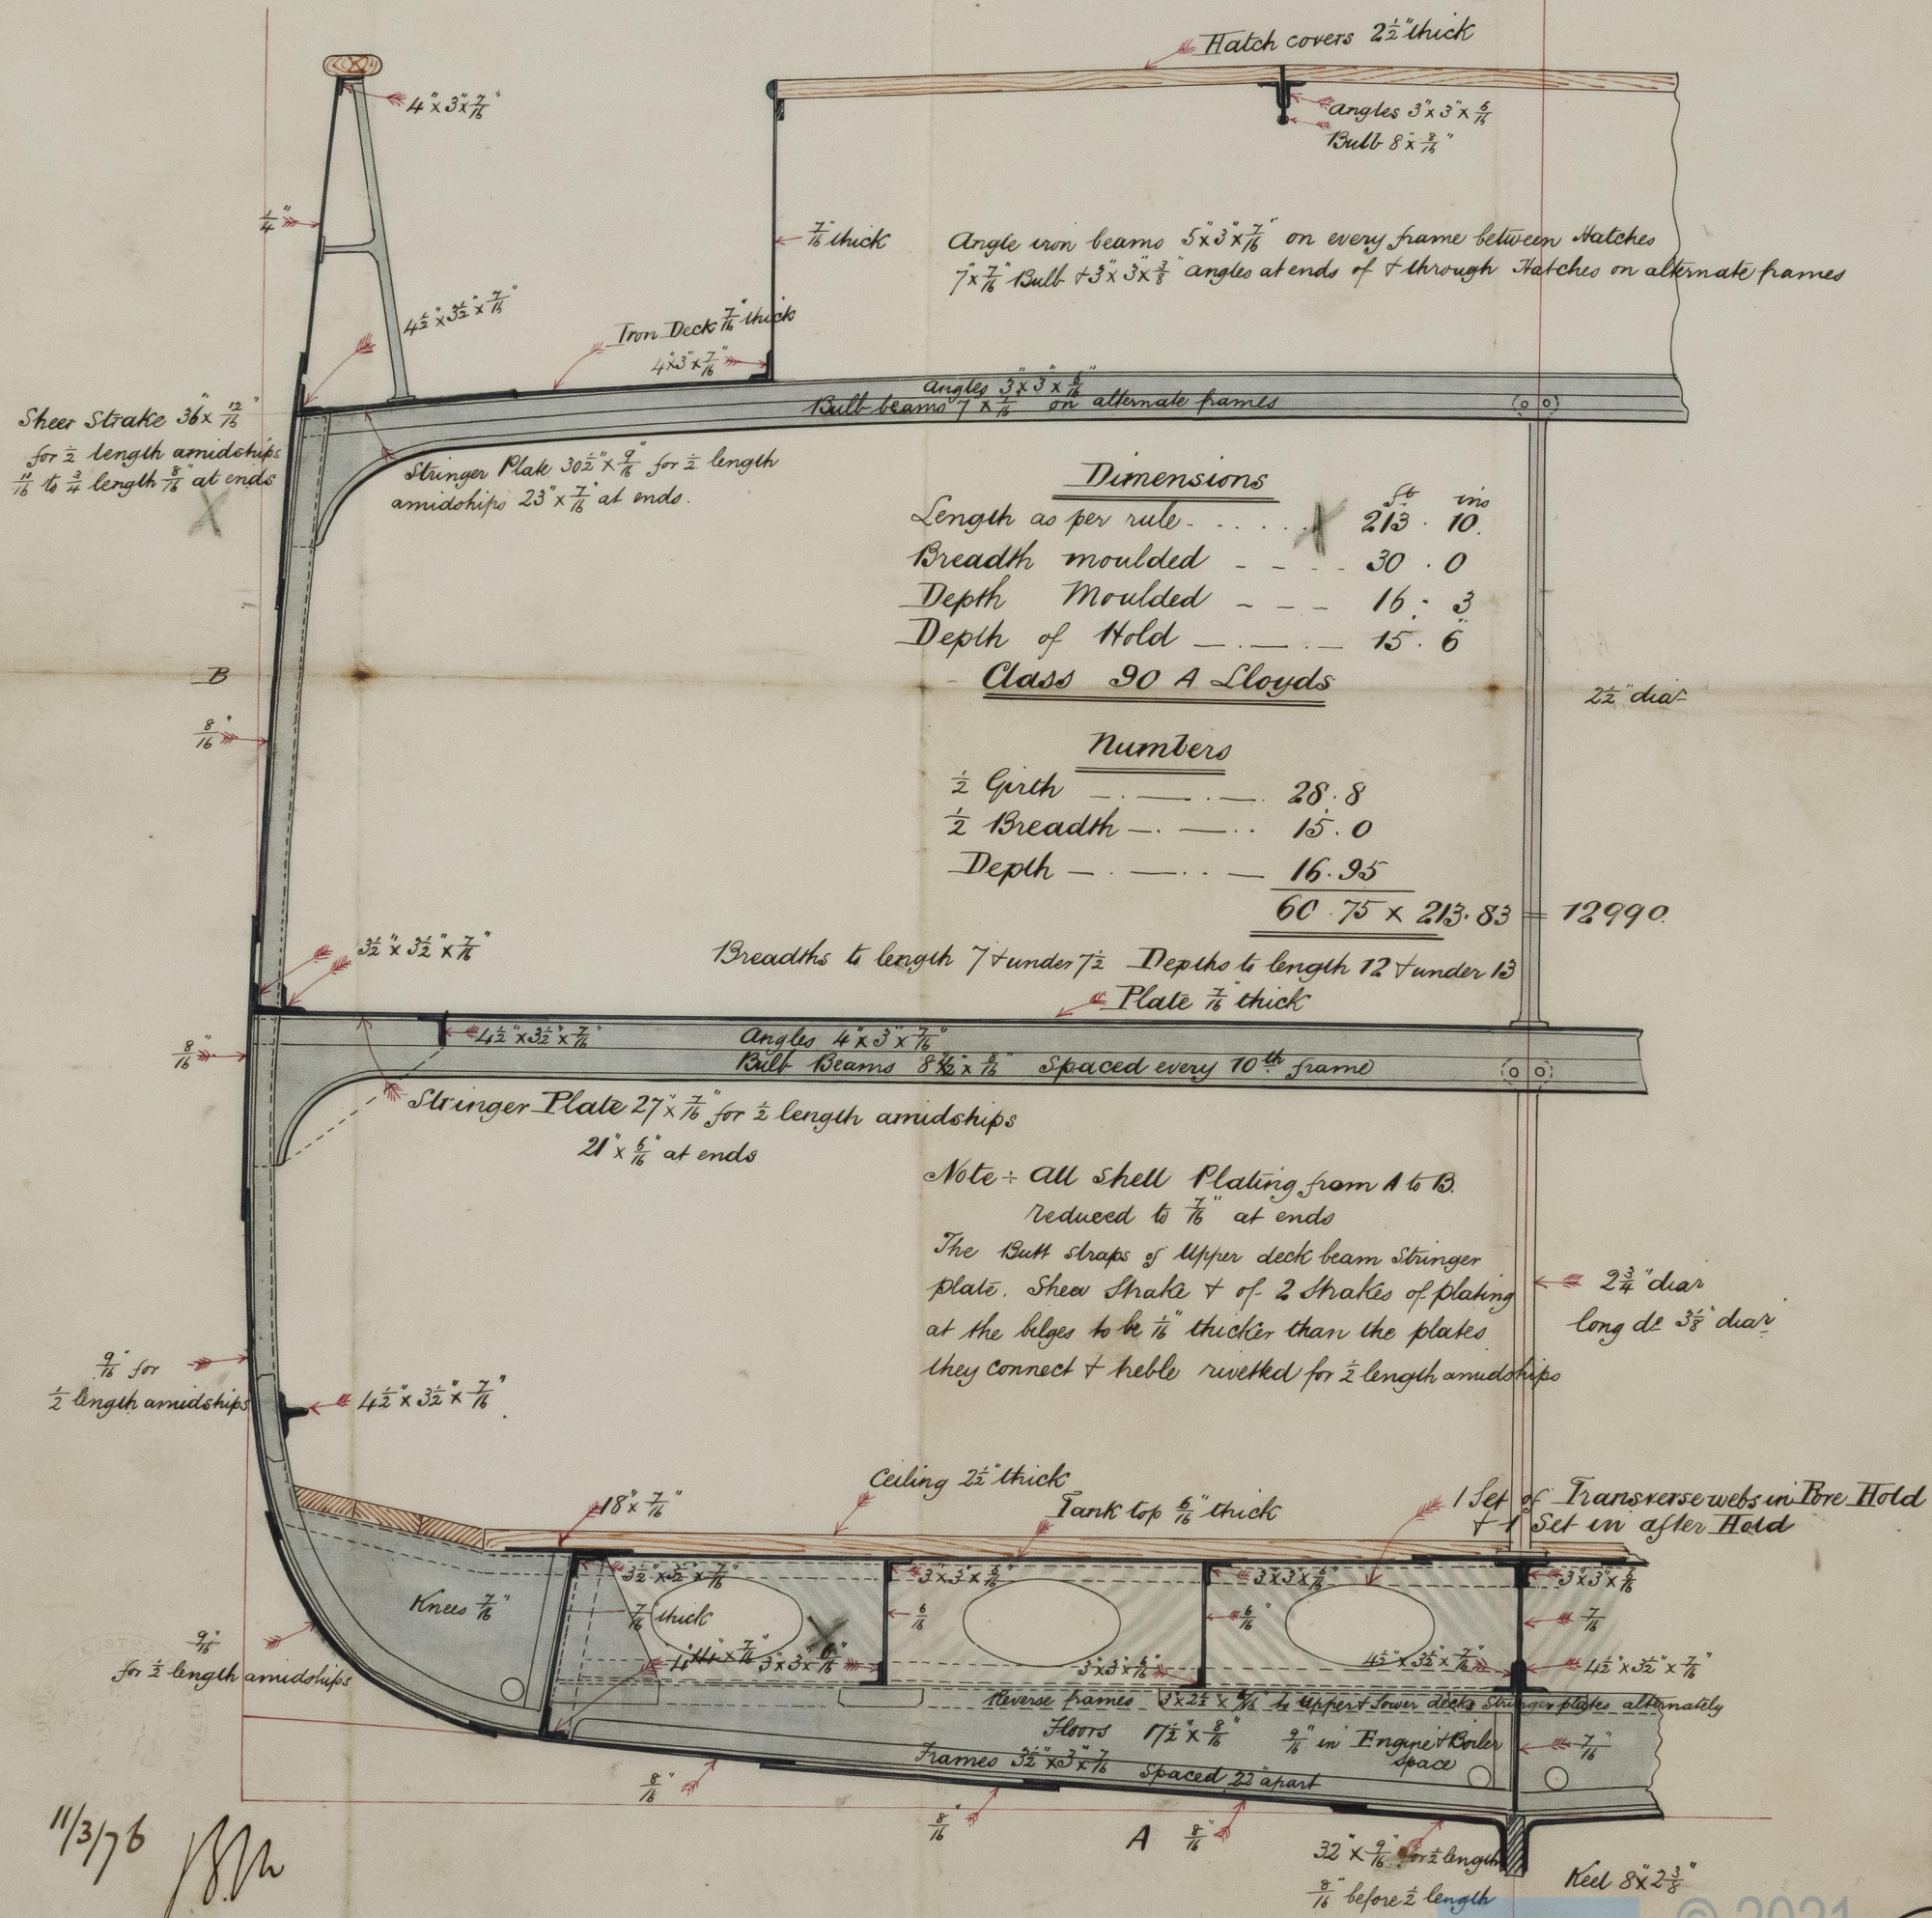

11/3/76 J.S.M.

15. 11. 1936