

18/2/76
19/3/76
14/4/76


S.S. No 86 S.S. "Amulet"

Class 90A with Poop & Forecastle

Glasgow Report No. 4310

Iron 16818.

Per 17/2/76 & 8/3/76 & 3/4/76

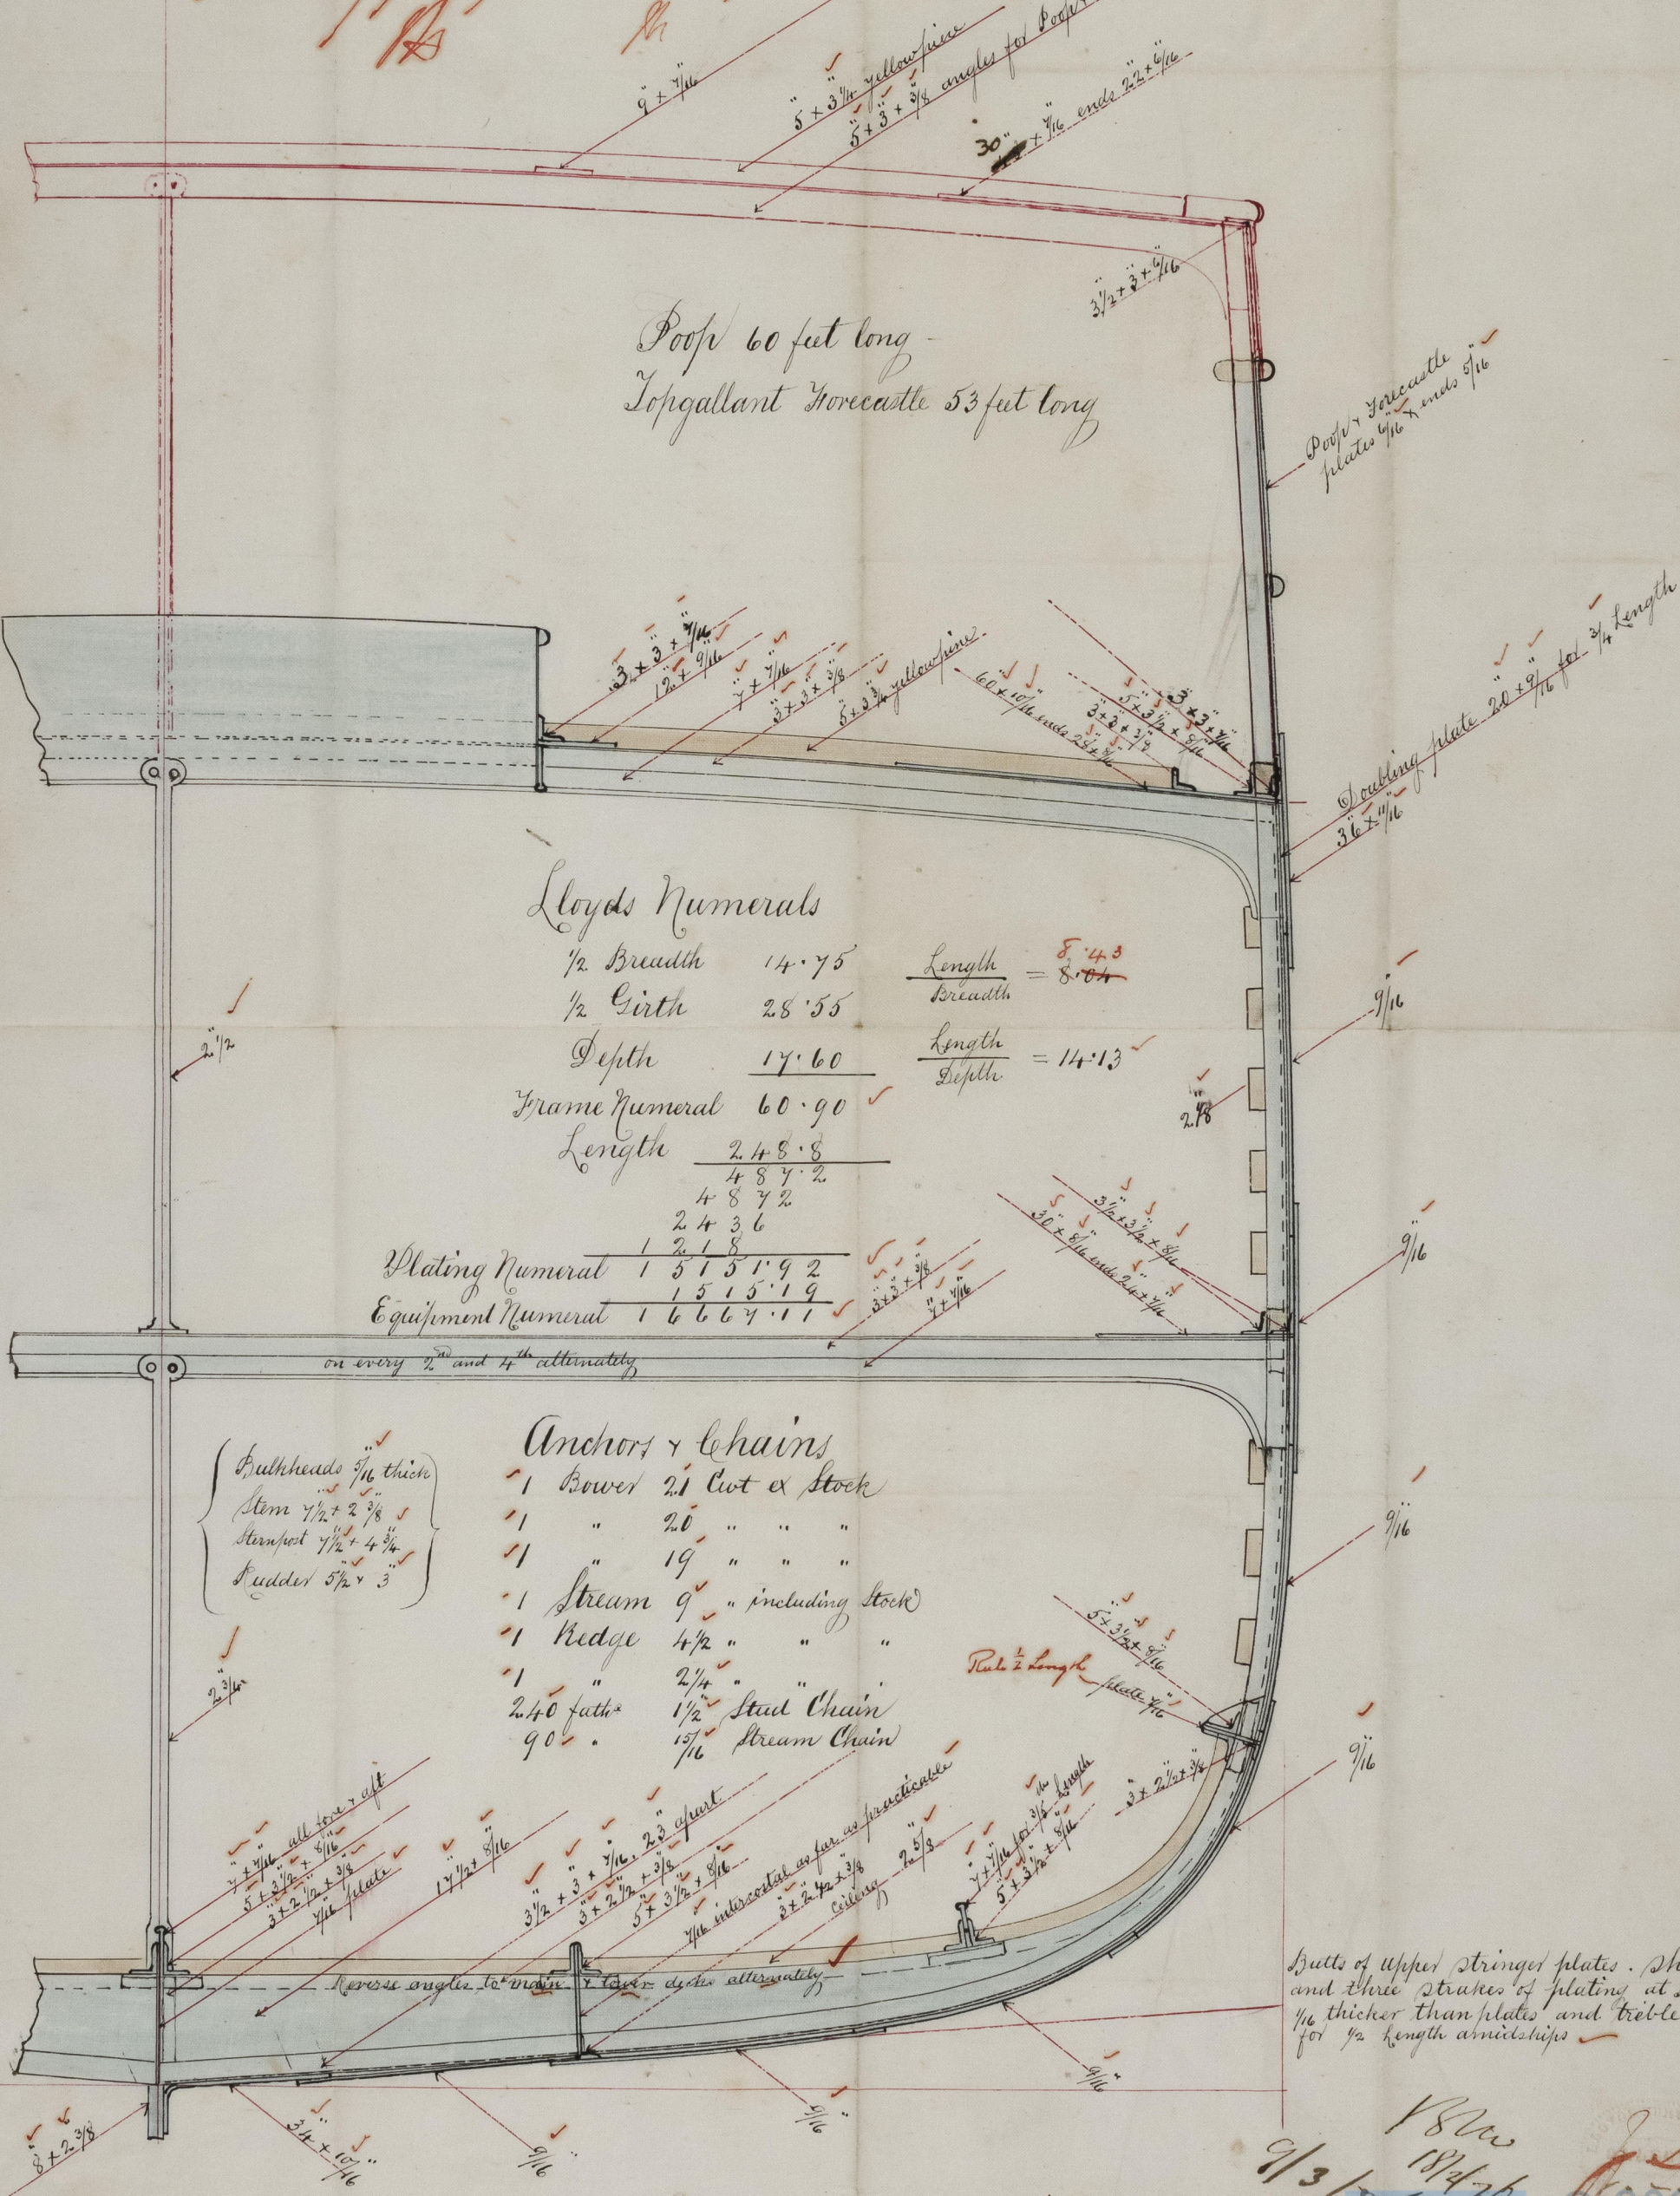

Lloyds Numerals

1/2 Breadth	14.75	Length	8.43
1/2 Girth	28.55	Breadth	8.04
Depth	17.60	Length	14.13
Frame Numeral	60.90	Depth	
Length	248.8		
	487.2		
	487.2		
	243.6		
	21.8		

Plating Numeral	15151.92
Equipment Numeral	15151.9
	16667.11

Anchors & Chains

- 1 Bower 2 1/2 Cwt & Stock
- 1 " 20 " " "
- 1 " 19 " " "
- 1 Stream 9 " including Stock
- 1 Ridge 4 1/2 " " "
- 1 " 2 1/4 " " "
- 240 fathoms 1 1/2 " Stud Chain
- 90 " 1 1/2 " Stream Chain

Bulkheads 3/16 thick
Stem 7/16 + 2 3/8
Stempost 7/16 + 4 1/4
Kudde 5/16 + 3

Butts of upper stringer plates. Sheer Strakes, and three Strakes of plating at Bilge to be 1/16 thicker than plates and triple riveted for 1/2 length amidships

AITKEN & MANSSEL.
SHIPBUILDERS & ENGINEERS
GLASGOW