

No. 23

Barque "Belle of Annon" Report No. 11.477

$\frac{1}{2}$ m. b. — 16.50
 depth m. — 22.58
 $\frac{1}{2}$ x Girth — 33.66

SCALE 1/2 INCH TO A FOOT

Class 100 A + 20 yrs L pool

Length according rule $\frac{72.74 \times 185.0}{36370}$

$$\begin{array}{r} 36370 \\ 58192 \\ 7274 \\ \hline 1345690 \end{array}$$


DIMENSIONS.

First Incidents

Under 6 Breadths Smooth P.P. 190" 0

9 depths. Breadth Moulders --- 33 " 0

Depth of floors } 20 " 8 1/2
to upper Deck Beams }

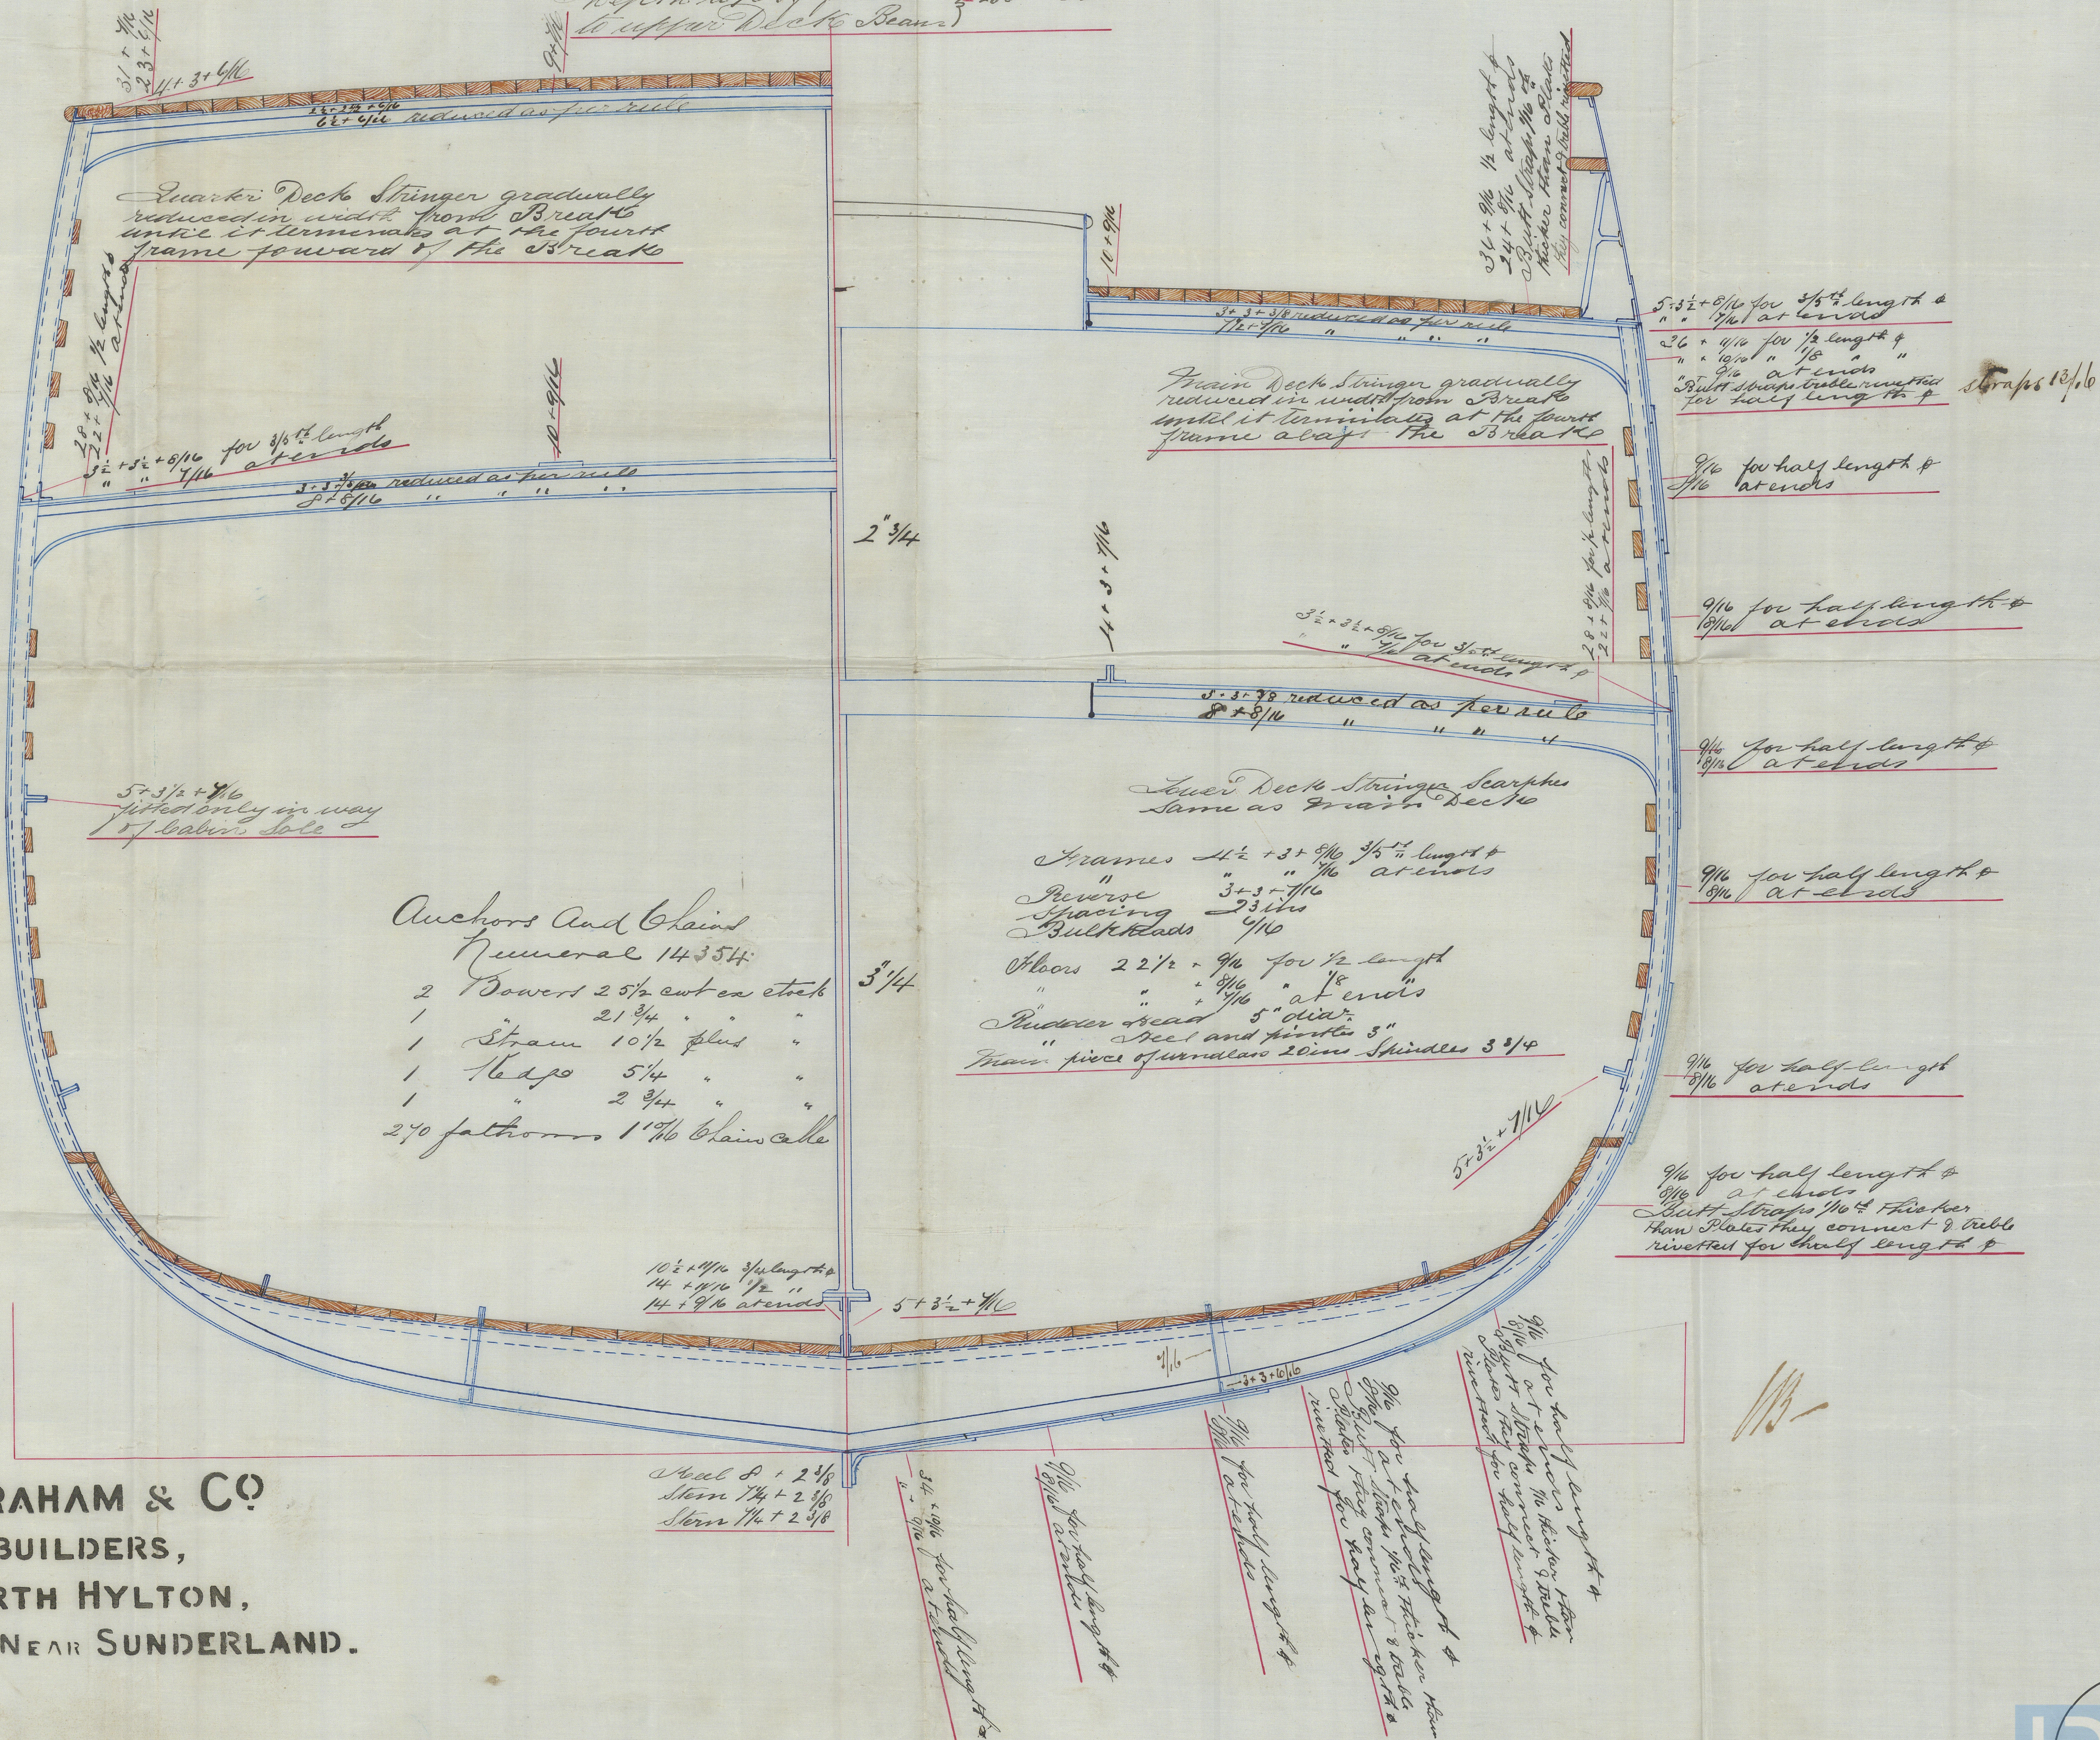

OSBOURNE, GRAHAM & CO
IRON SHIPBUILDERS,
NORTH HYLTON,
NEAR SUNDERLAND.