
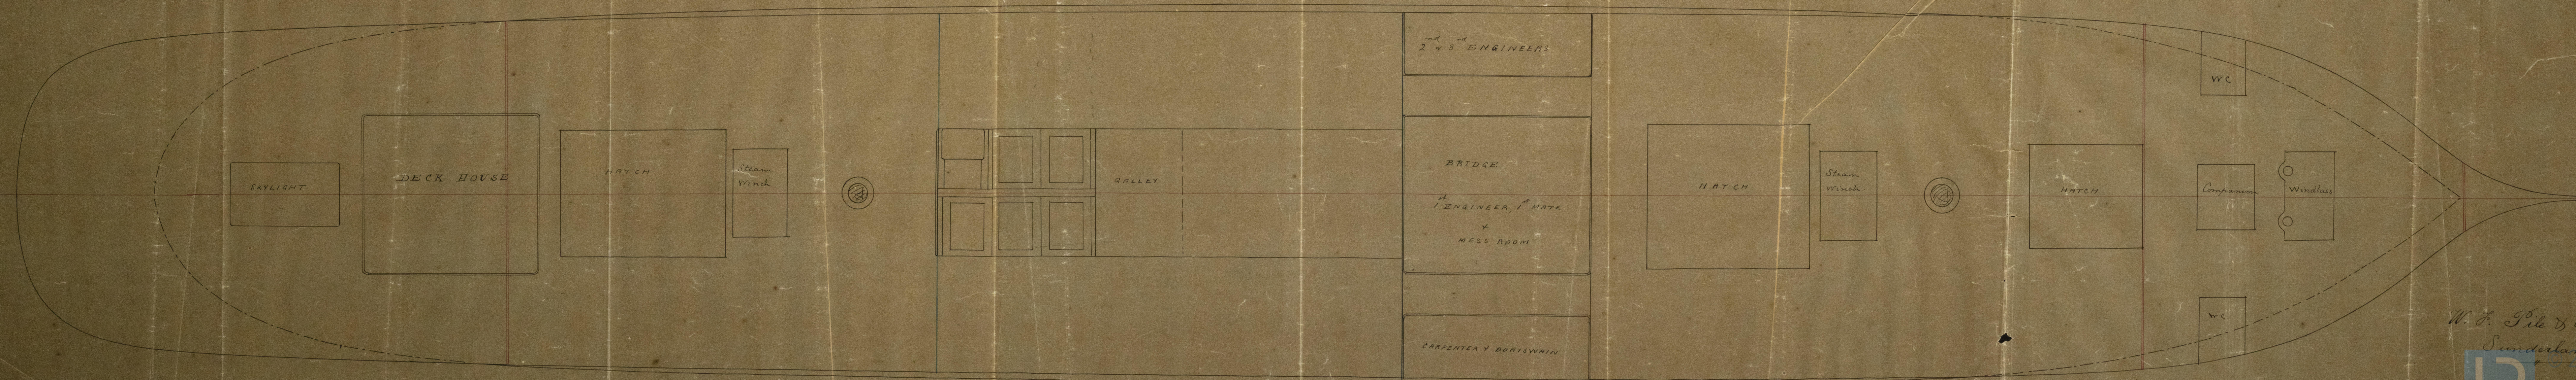



S.S. "Dawn" No 241.
Report No 11,494

General Arrangement of Screw Steamer No 241.
Scale $\frac{1}{4}$ Inch = 1 foot.

July 15th/76

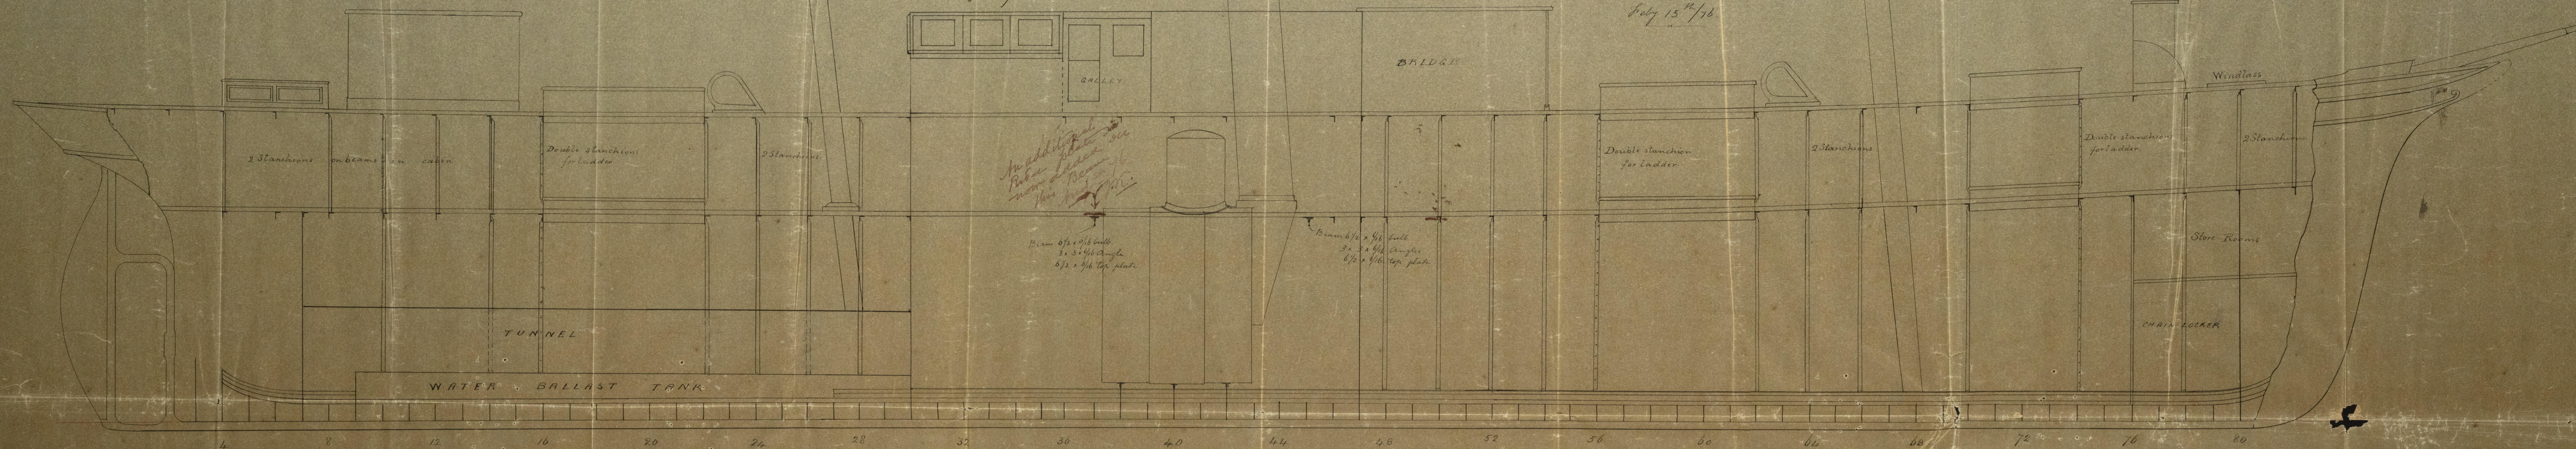

W. F. Pile & Co
Sunderland

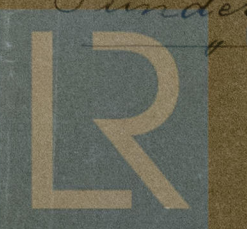

Lloyd's Register
Foundation

IRON 517-0066