

Yacht 270


# - Proposed Midship Section - of-

Screw Steam Yacht

To Class 100 A Dec 8/3/76

Scale  $\frac{1}{2}$  inch = 1 foot

12

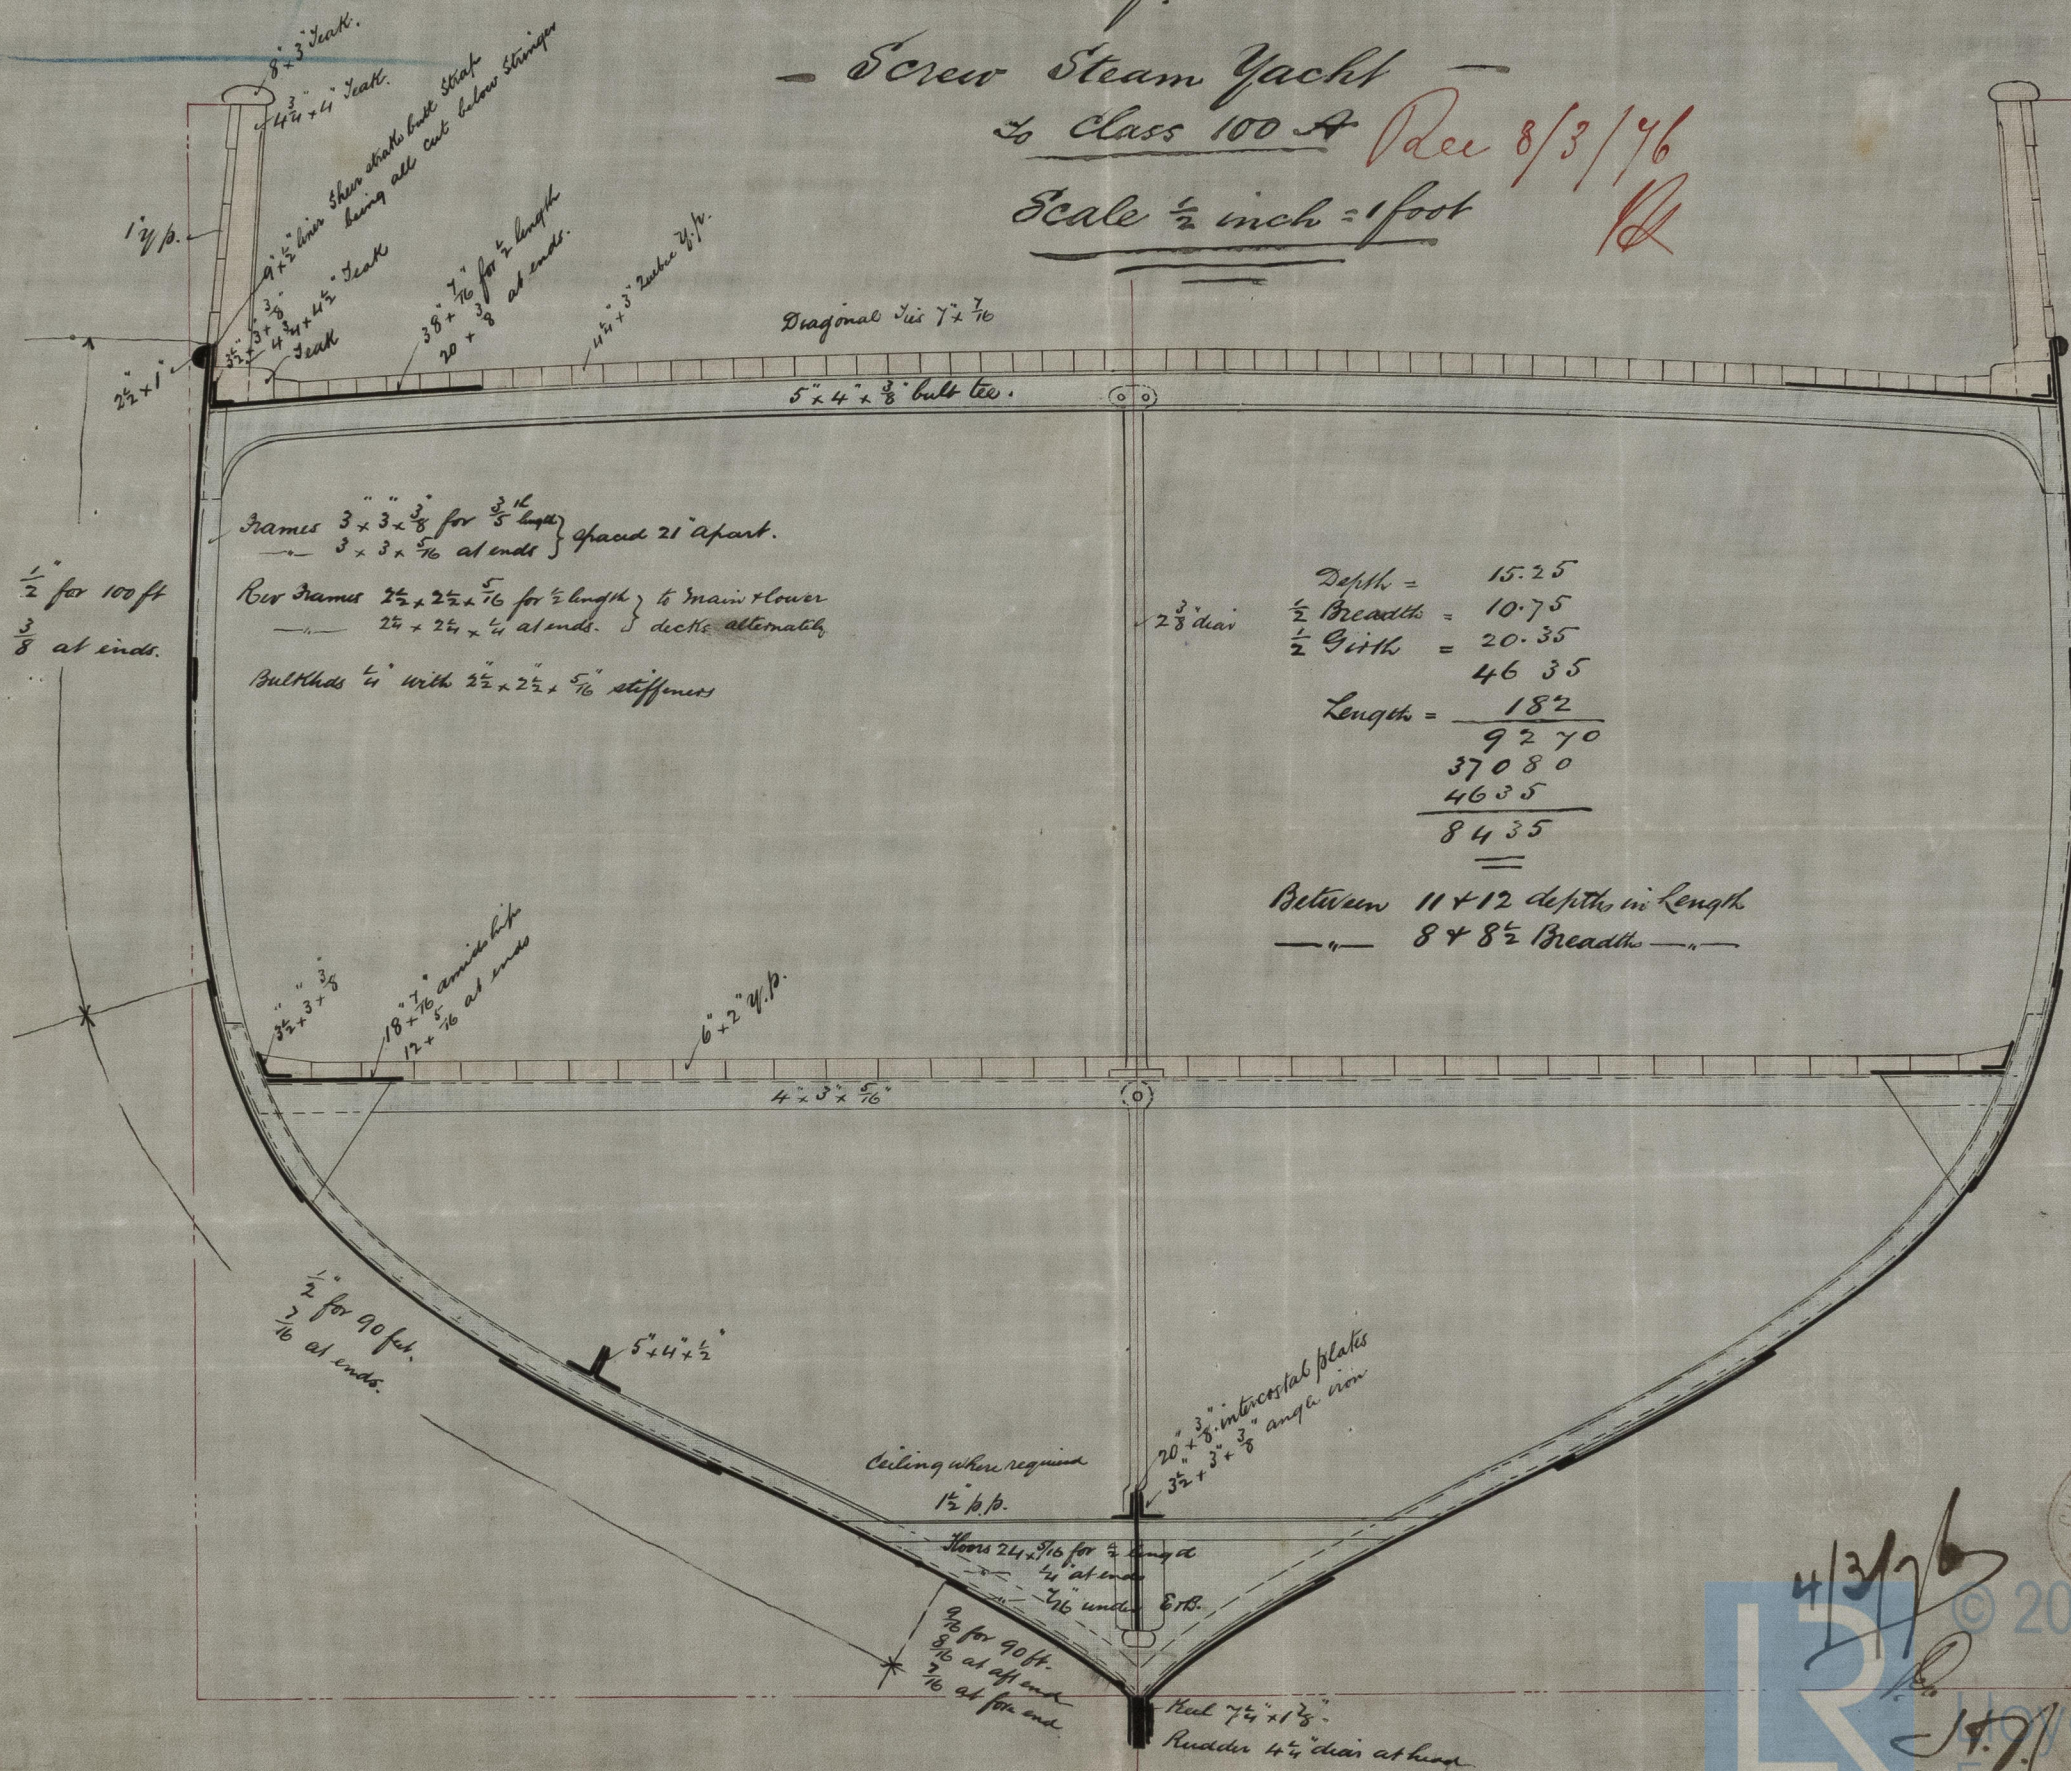

Depth = 15.25  
 $\frac{1}{2}$  Breadth = 10.75  
 $\frac{1}{2}$  Girth = 20.35  
 Length = 182  
 9270  
 37080  
 4635  
 8435  
 =  
 Between 11 & 12 depths in Length  
 8 & 8 1/2 Breadth



Lloyd's Register  
Foundation

190511-0078

4/3/76  
J.A.J.  
3/8/76