


- Longitudinal Section of Proposed Screw Steam Yacht -

- Scale  $\frac{1}{8}$ " inch = 1 foot -

Rev 8/3/76  
R

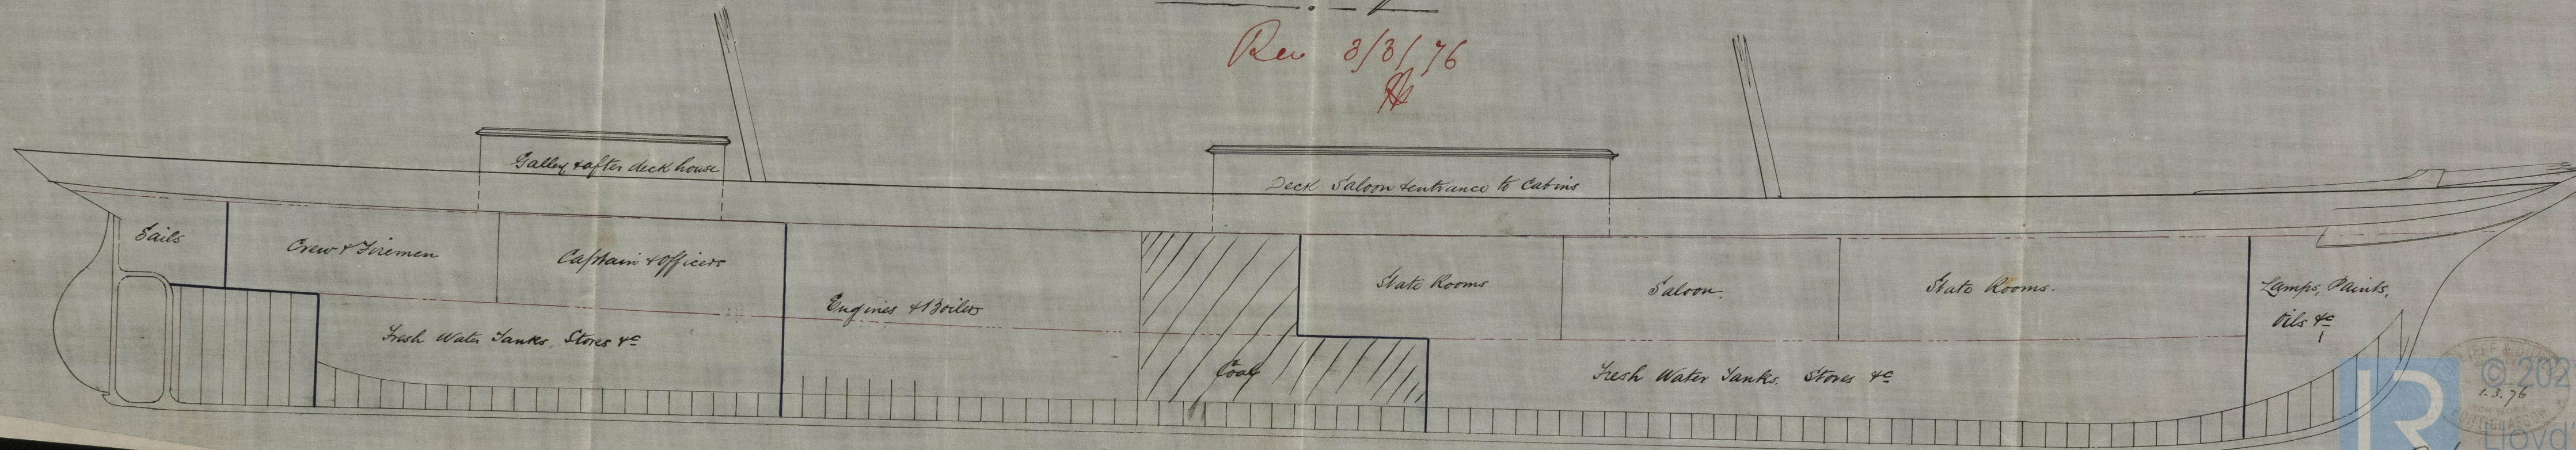

IRON 517-0079

