



Midship Section.
Per 6/9/75

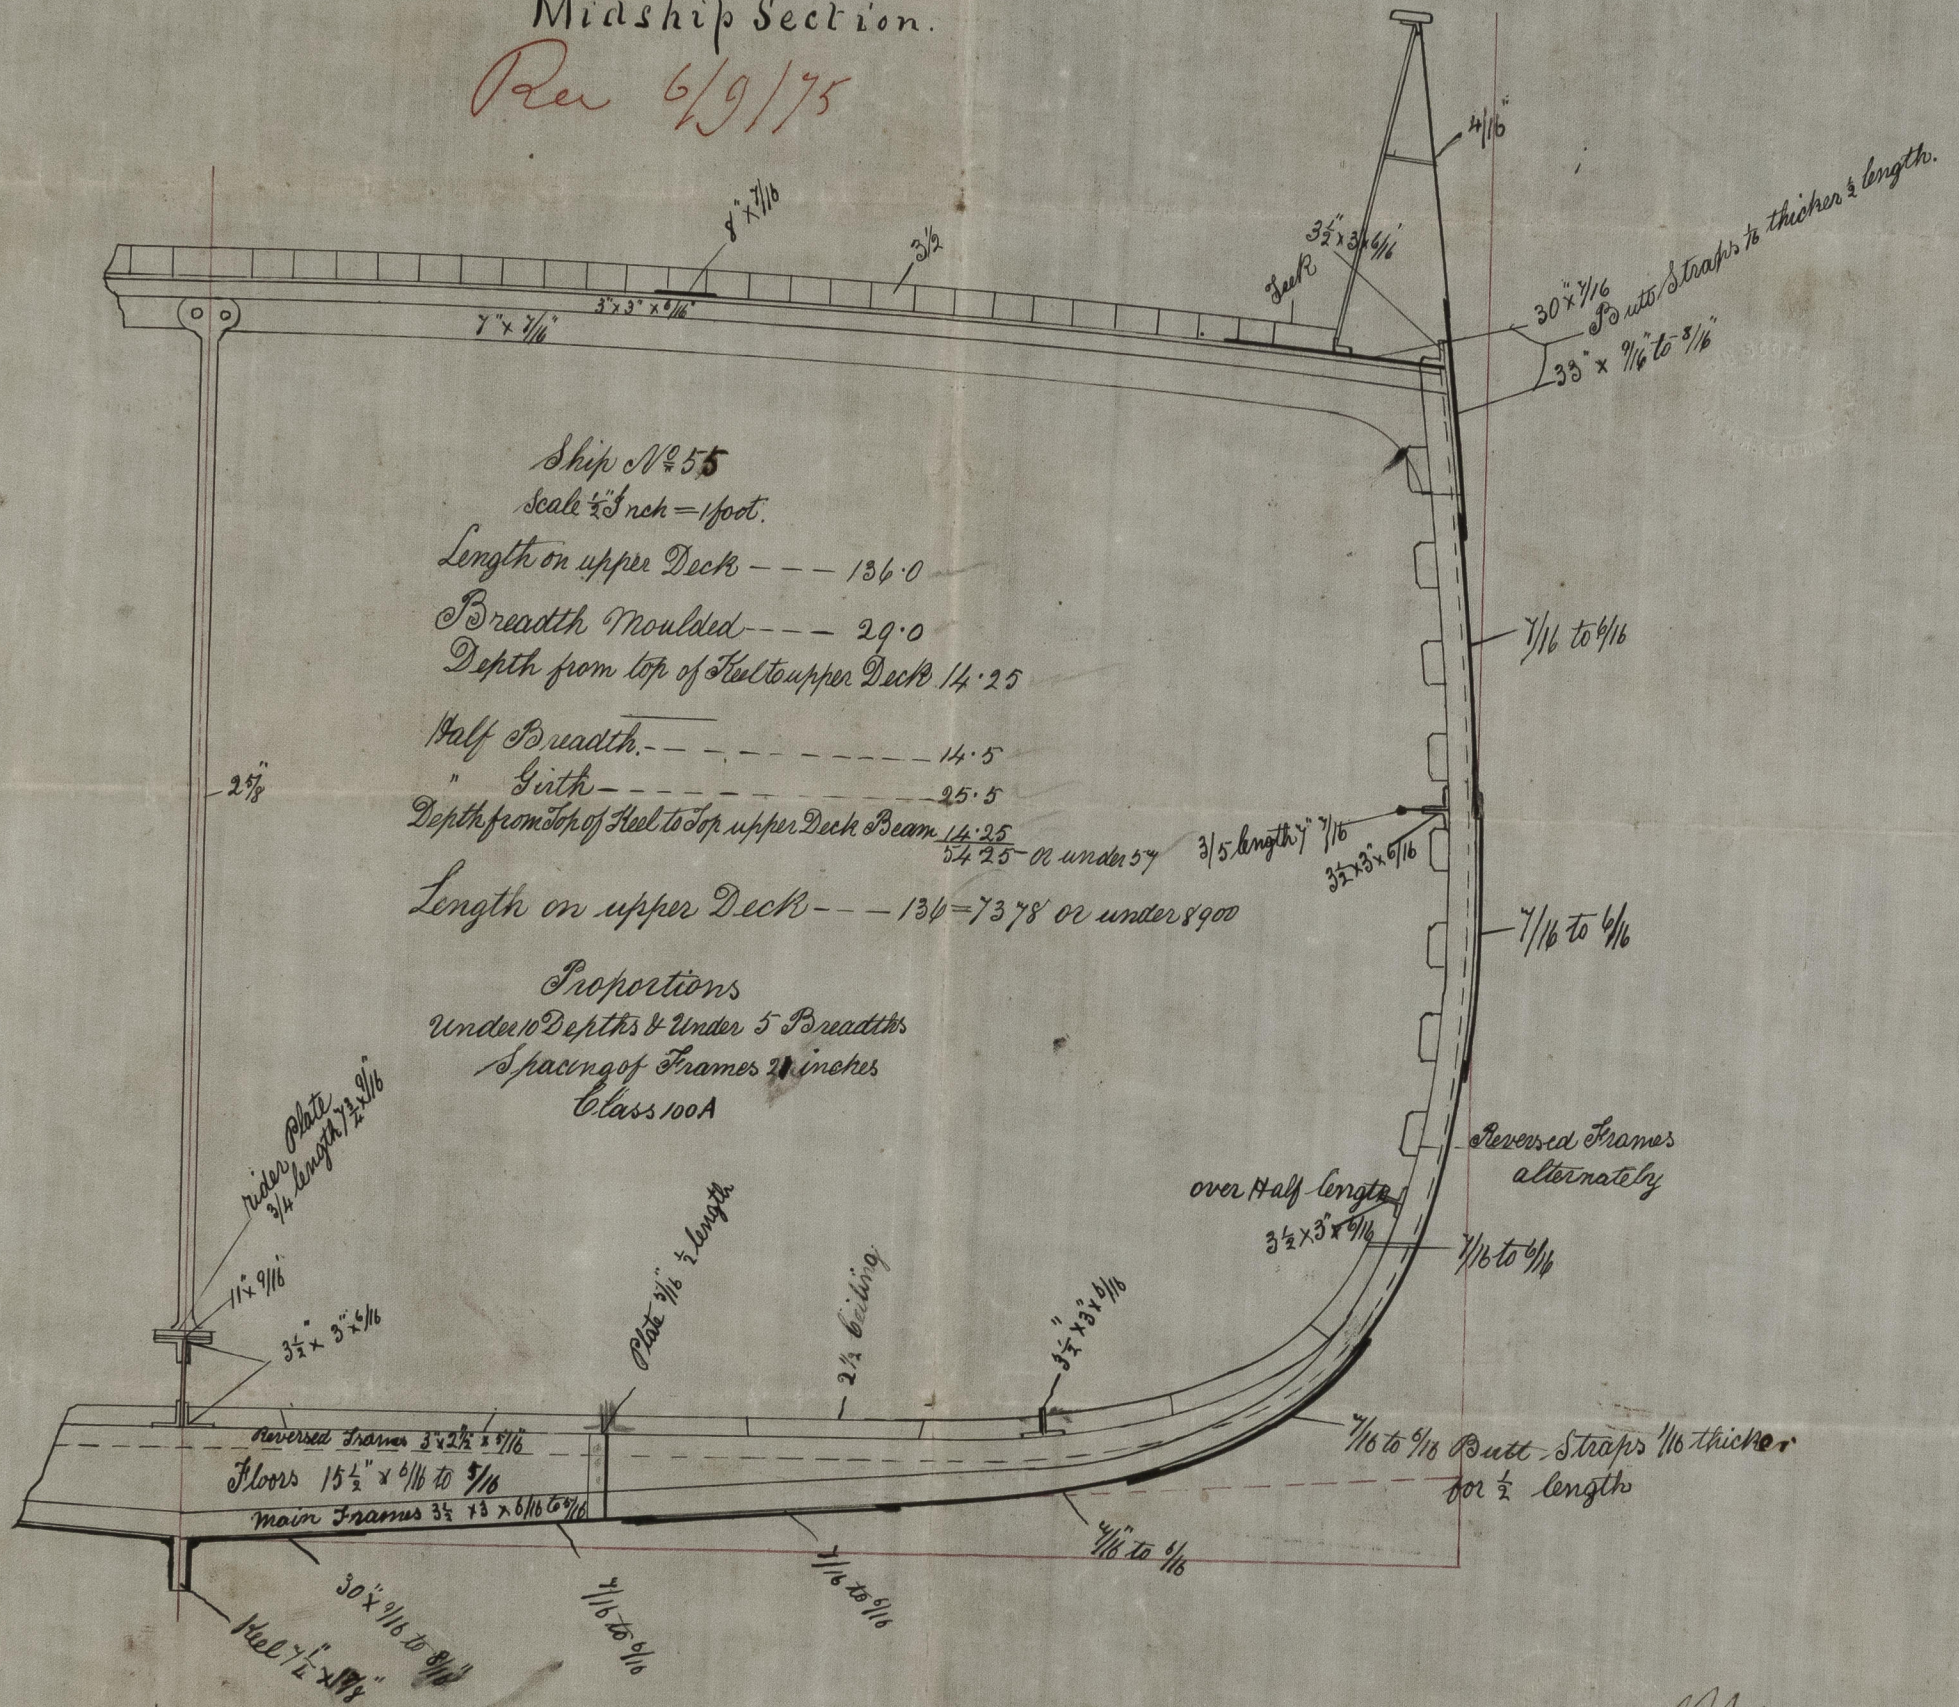

15/9/75


 © 2021
 1st 9/7 52
 Lloyd's Register
 Foundation

IRON 514-0085