

9/2/76

18m
9/2/76


No change shown
all 13 with triple masts.
But 13 says 1/2 thicker than
plates, made in three plates
& handings double masts.
End of the way?
nothing: - 1/2

Section
○

Main Mast No. 55.

Scale 1/4 inch to one foot.

Rec 21/1/76 3/2/76
4' 0"

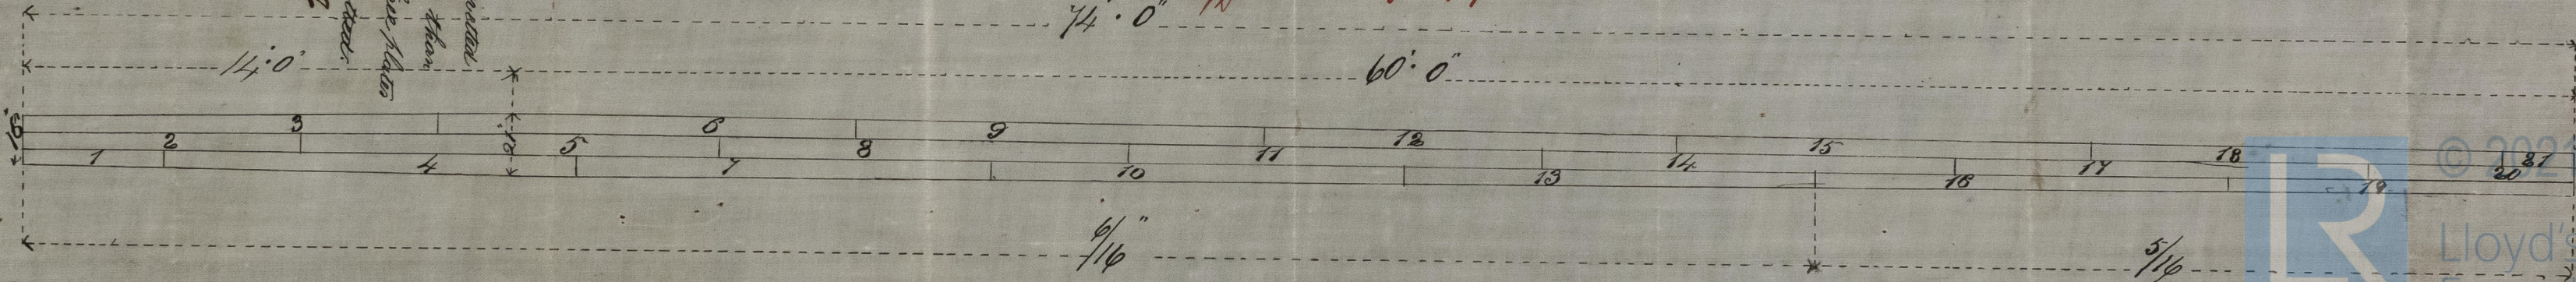

© 2021
Lloyd's Register
Foundation

IRON 517-0086