Midship Section Sailing Barque.

No. 81

Rev 6/1/76

Barque "Kirklock" report No. 11.474.

Equipment Numerals.
12474·4 + 1/15 = 13306

Equipment No. 13200

2 Bowers 25½ Cwt.
1 " 21¾ "
1 Stream 10½ "
1 Kedge 5¼ "
1 " 2¾ "
270 fathoms 1 10/16 chain cable.

6/1/76

WILLIAM DOXFORD & SONS SHIP BUILDERS 22 DEC 75 SUNDERLAND

Dimensions
Length 190'·0"
Breadth Ext. 31·0
Depth to floors 19·5½.

Class 100 A.
Rules 1875 + 1876.

Raised Quarter deck 40'·4 long, 3'·0 high.

1st Number 68 + under 71.
2nd " 11800 + " 13100.
Proportions. Under 6 Breadths.
" 9 Depths.

Dimensions as per Rules.
Depth top keel 21·20
½ M. Breadth 15·37
½ Girth 32·16
68·73
181·5
34365
6873
54984
6873
12474·495

All frames to Raised Quarter deck
Reverse frames alternately.

Additional Beams to be fitted in fore peak and also Aft under raised Quarter deck, to prevent painting.

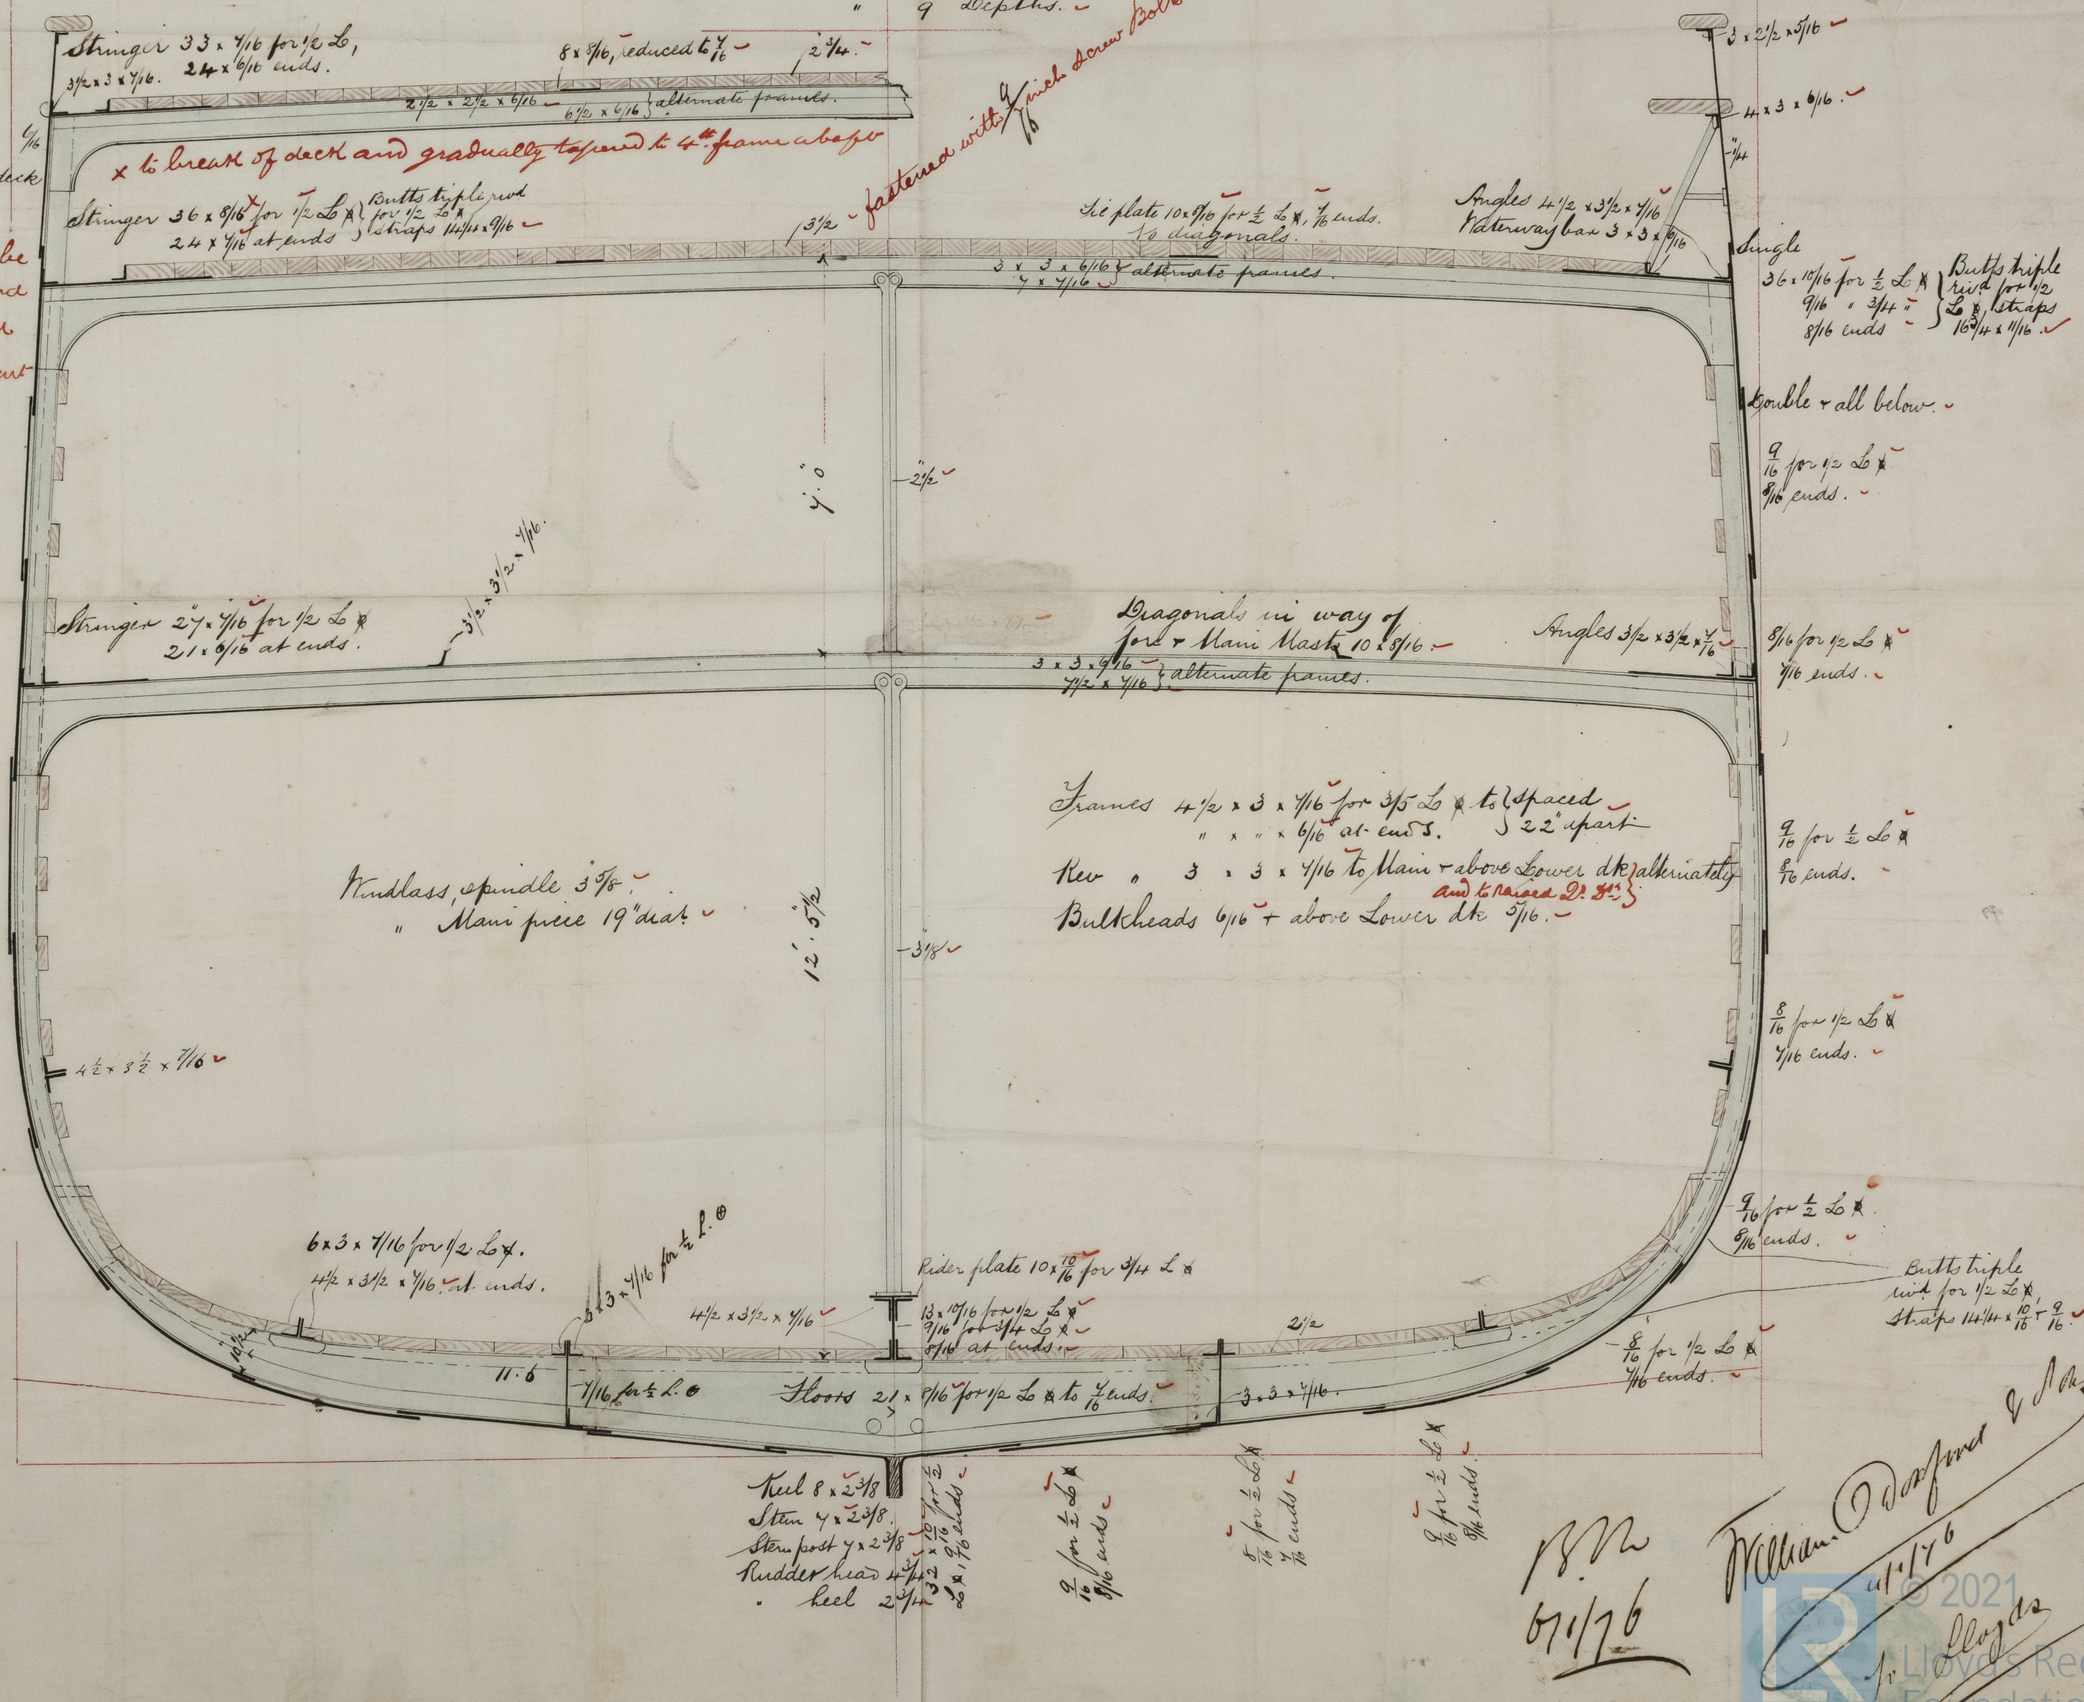

B.M.
6/1/76

William Doxford & Sons
4/1/76
for Lloyds

© 2021 Lloyd's Register Foundation

IRON517-0134