

S. S. Nos 145 & 146

15/1/76

22'5" x 26'2" x 13'6"

Numerals 51.54
224 for Deck
11,551.6 numeral



Scale 1/2" = One foot

Re 13/1/16


8.5 Beams
15.2 depths.

S.S. "South Australian"

13.08 - 313 Glasgow Report 4311
14.40 - 2
23.49 - 59
51.54 numeral.

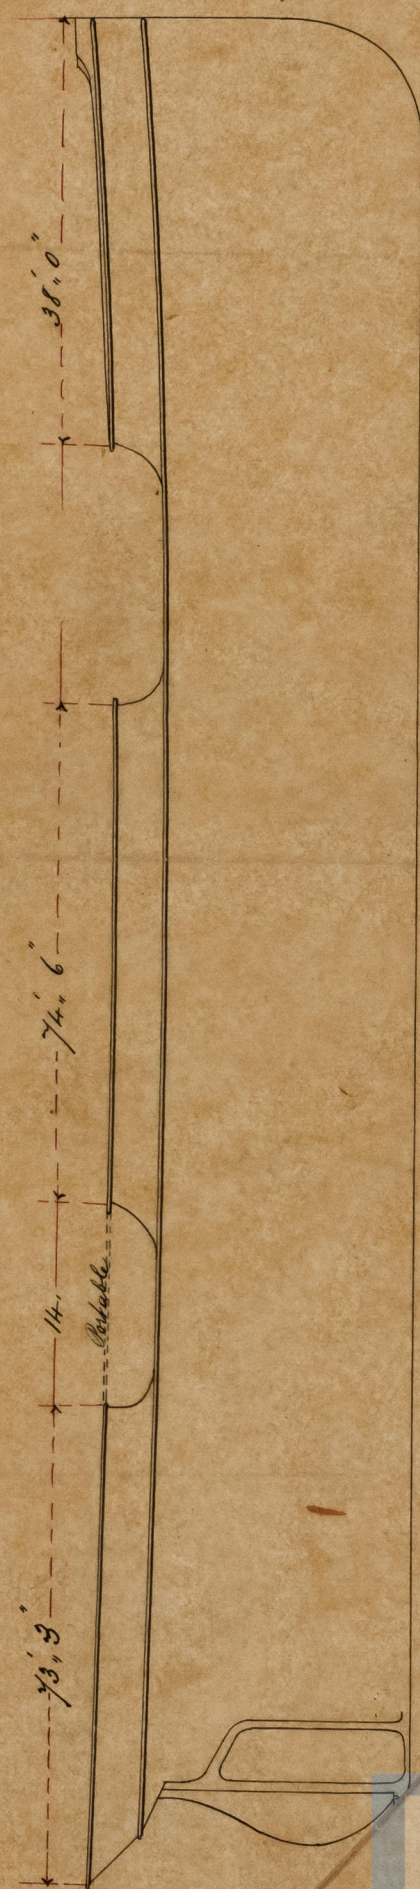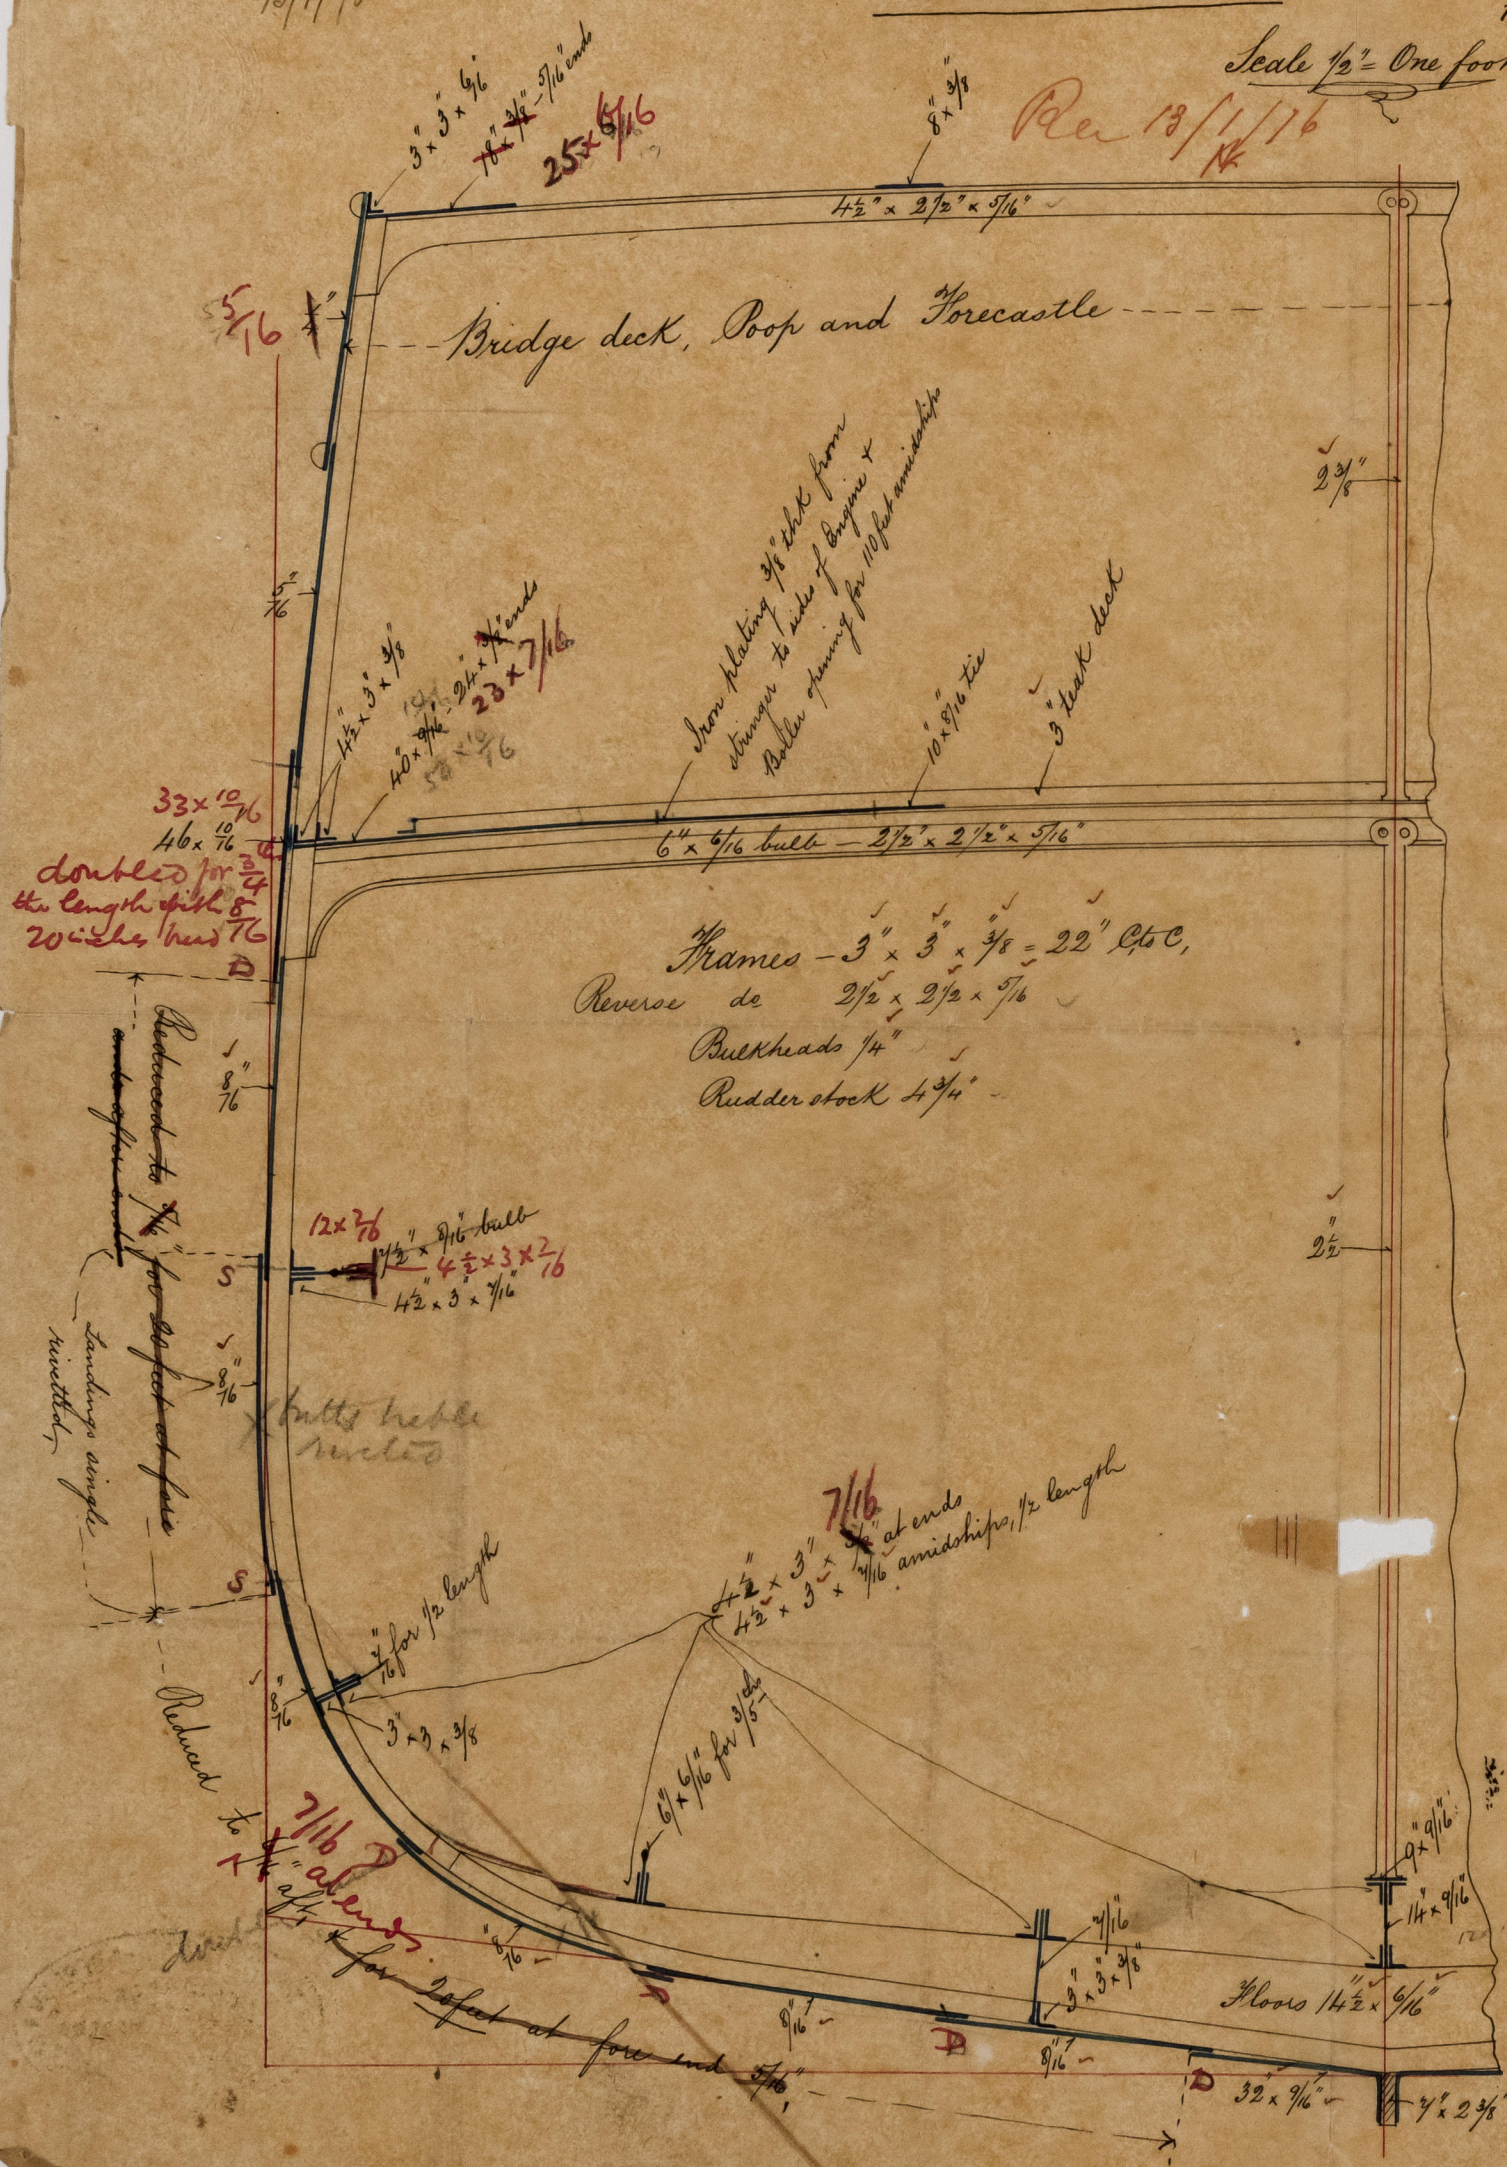

Main Deck

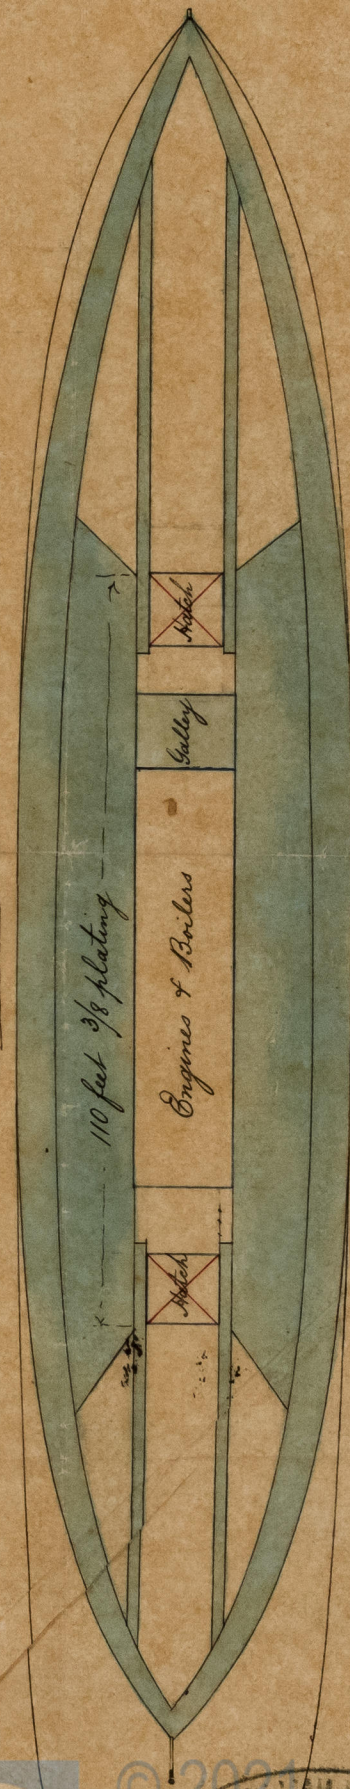

© 2004
Lloyds Register
Foundation
14/1/76

IRONS 18 - 0004