



Note. Beams marked F are fast  
L loose.


Deck Plan No 331

Scale 1/4" = one foot.

Rev 22/7/76

"Thornburgh" - Report No 10023.

July 20<sup>th</sup> 1976

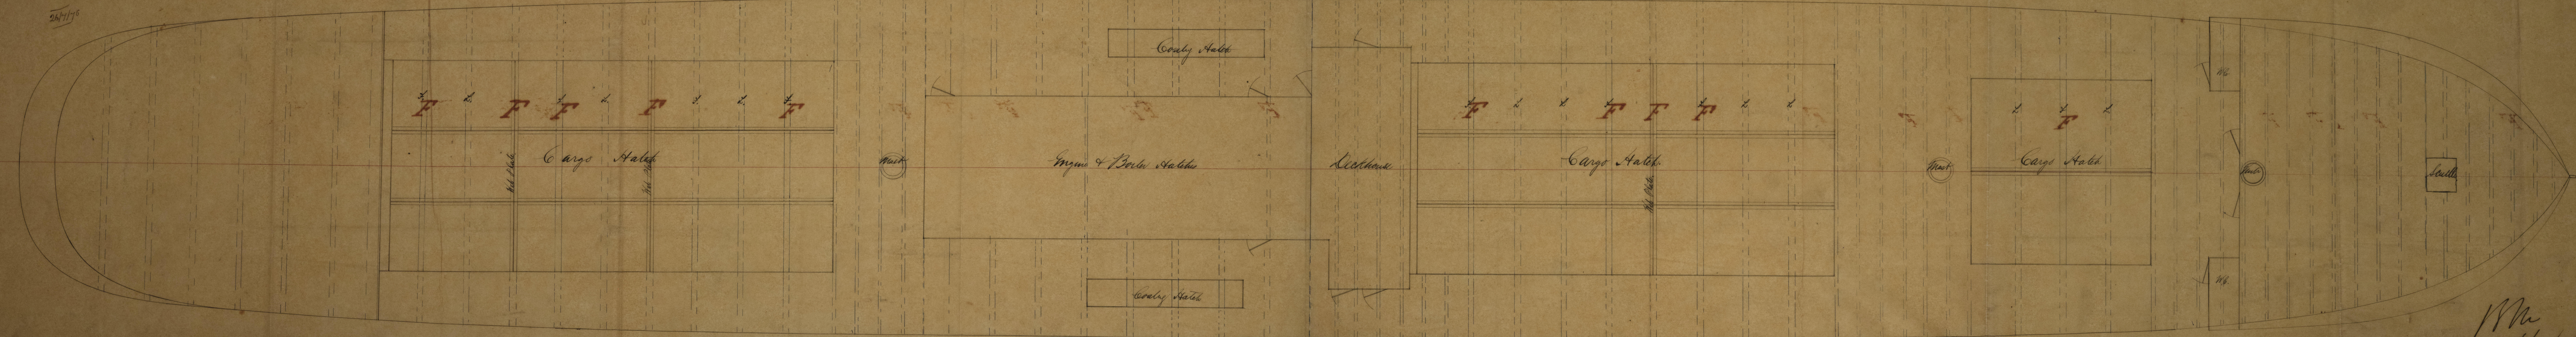

IRONSIG-0025

18th  
26/7/76



Lloyd's Register  
Foundation