

17058 Lm "Thunbergia" *capitata*

From No 17058

— N^o 107 —

To Class 100A1

Dimensions for Lloyds

 $\frac{1}{2}$ breadth 17.5

depth - - - - - 23.96


$\frac{1}{2}$ girth — — — — — 35.66

77.12

Length - - - - 219.33

16,912

Rev 2/11/75

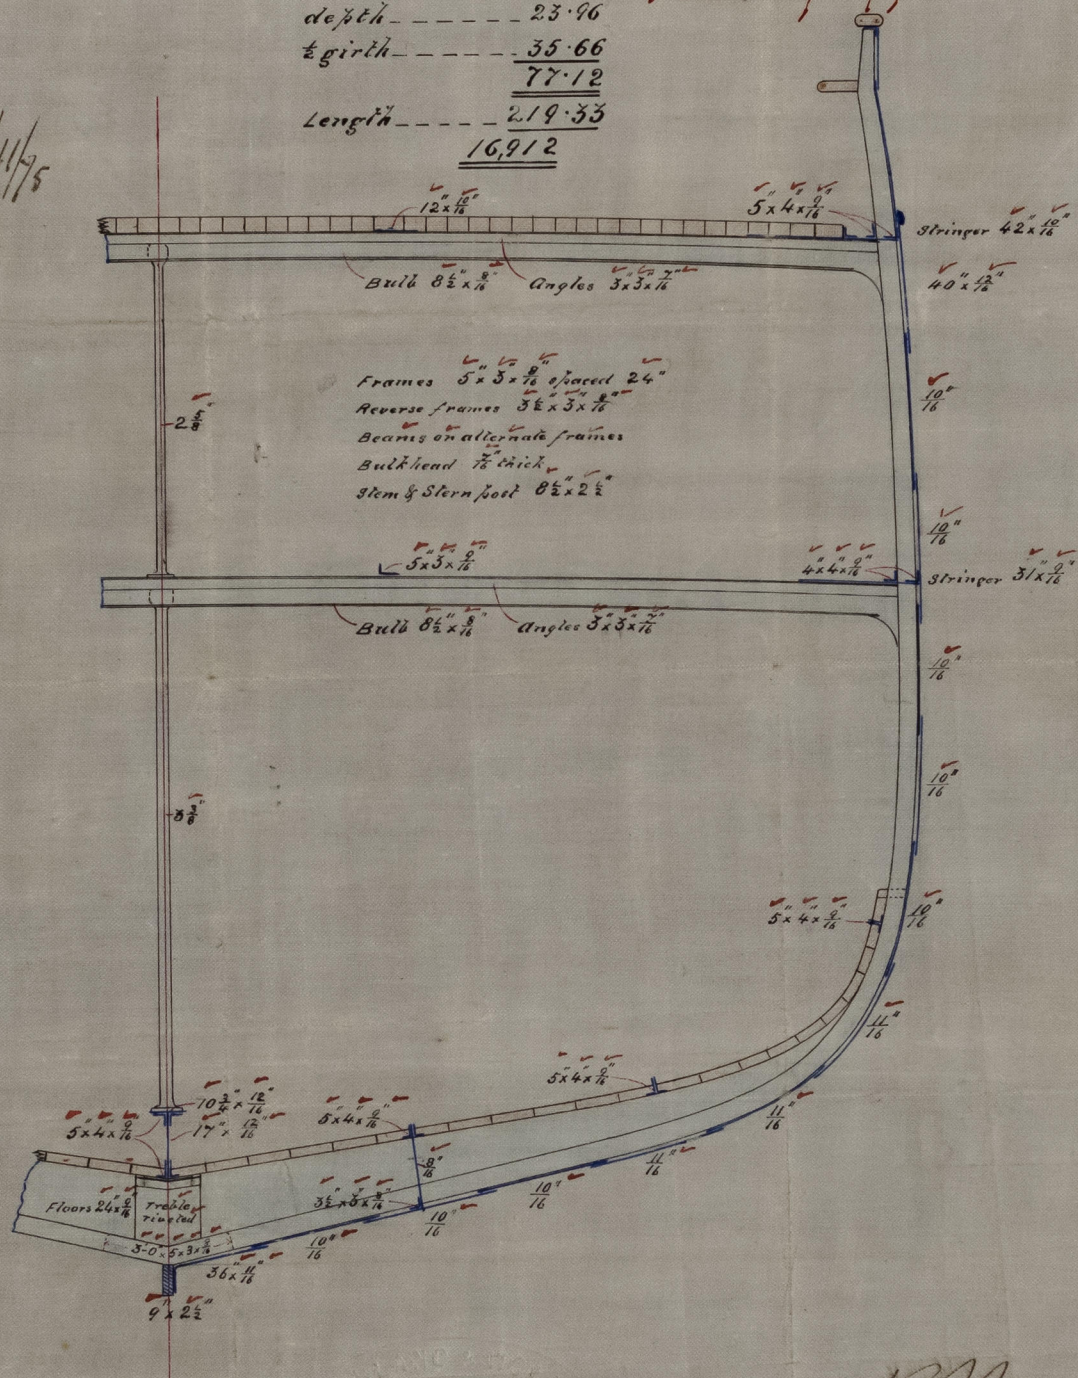

Oct^r 29th 1875

M. N. to Ber-145

IRONS18-0026

BM

2/11/75