


Rec 14/1/76 & 19/1/76

Length between Perpendiculars	71' 3"
Breadth Extreme	23' 1 1/2"
Depth Moulded	12' 0"

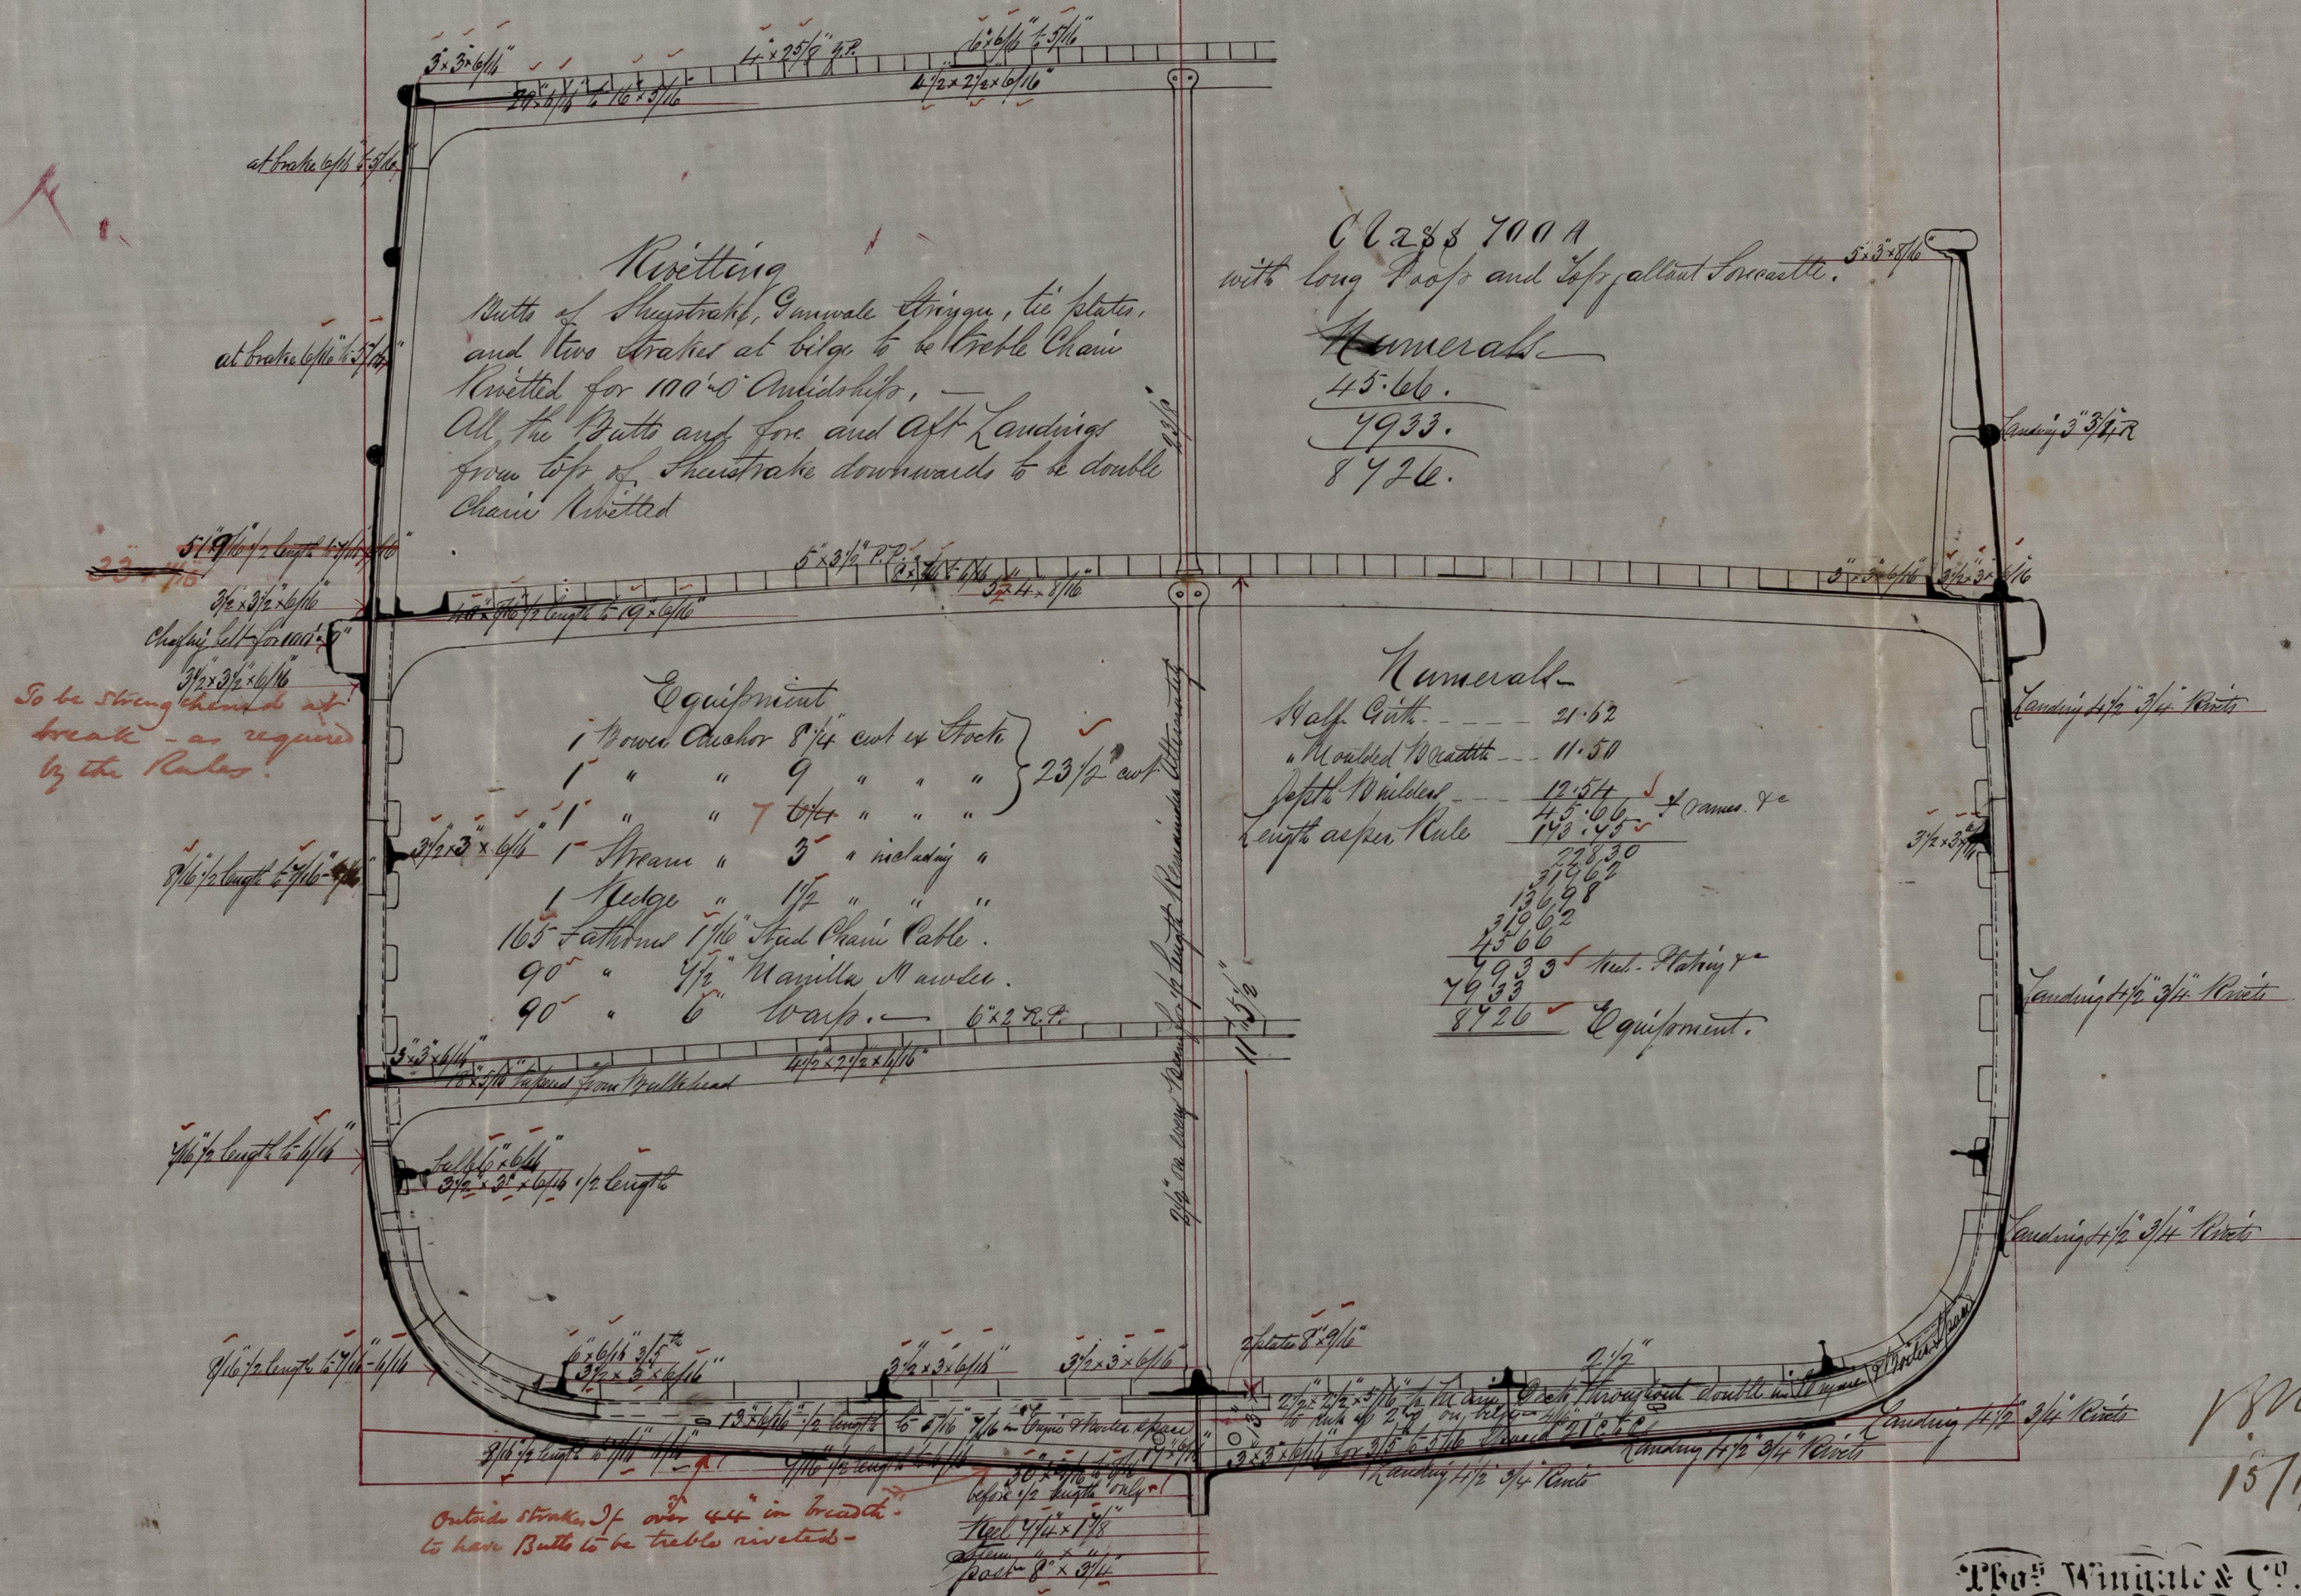

SCALE $\frac{1}{2}$ INCH EQUAL TO A FOOT

The^{rs} Wingate & Co.
ENGINEERS & SHIPBUILDERS
G. A. SCOW.