


27/11/75

MAIN DECK PLAN S S N 209 *S.S. "Kunaka"*

*Dec 26/11/75*  
Length between Perpendiculars *77' 0"*  
Breadth Extreme *22' 4 3/4"*  
Depth Moulded *12' 0"*

*Glasgow Report No. 4312*

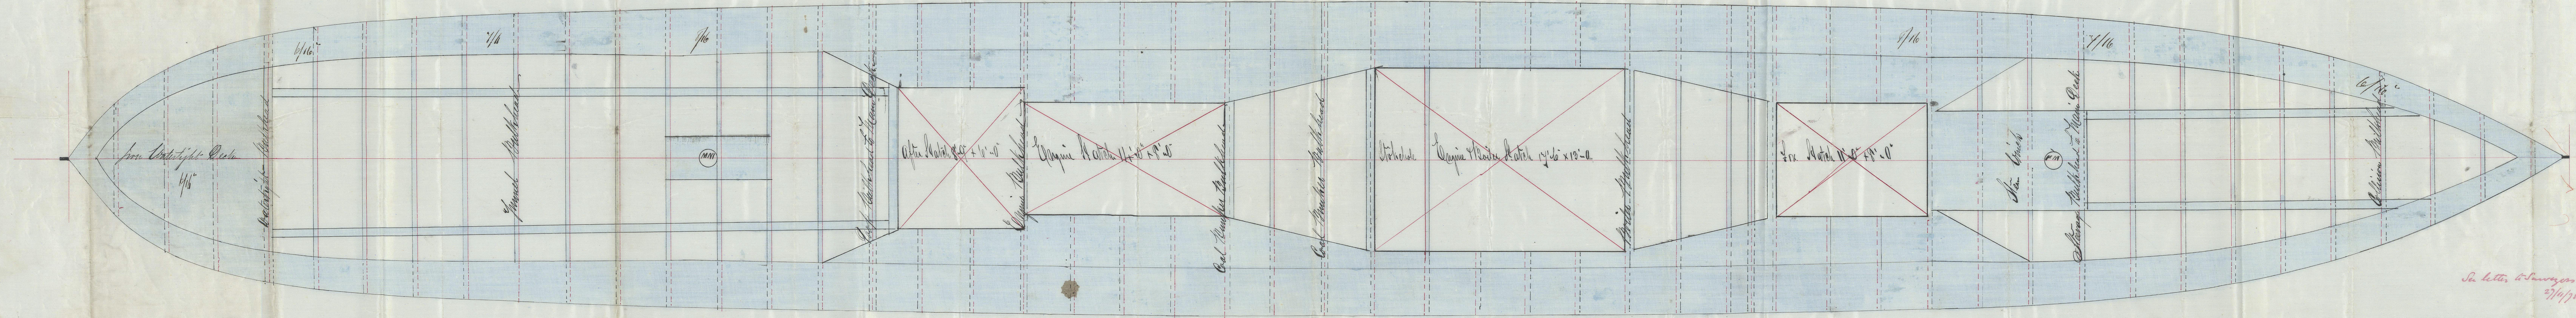

SCALE 1 INCH EQUAL TO 10 FEET

*See letter to Surveyors. 27/11/75*  
The Wigham & Co.  
ENGINEERS & SHIPBUILDERS  
GLASGOW. 23rd November 1975