


SCREW STEAMER N<sup>o</sup> 209. *S. S. "Mancha"*

Rev 26/11/74

*S. S. "Wanuka"*  
*Glasgow Report No. 4312*

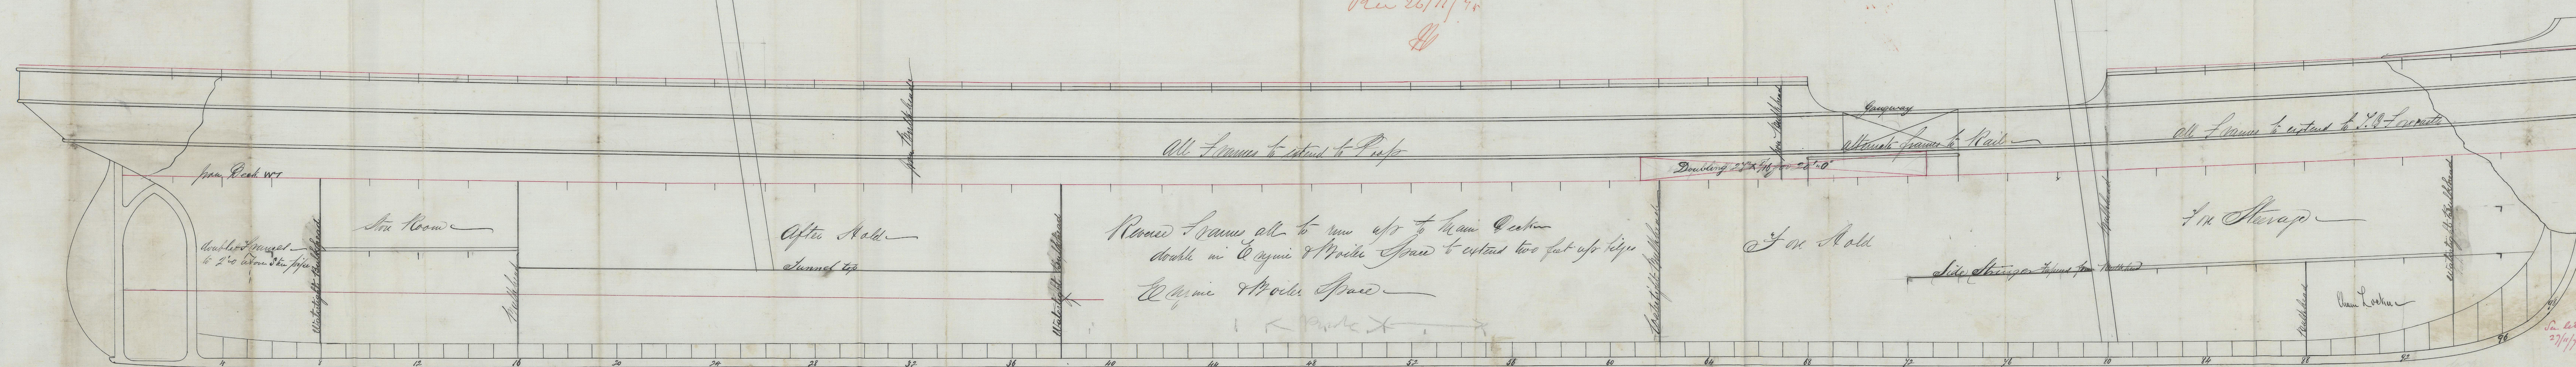

SCALE  $\frac{1}{4}$  INCH EQUAL TO A FOOT

Theo. Wingate & Co.  
ENGINEERS & SHIPBUILDERS  
