

COPY D<sup>RC</sup>

N<sup>o</sup> 2 7 0

"WEST GLEN"

Midship Section of Barque N<sup>o</sup> 87

to Class 100/A at Lloyds.

Dimensions by Lloyds  
176.75 x 31.00 x 20.42

Glasgow }  
Report } N<sup>o</sup> 4306


Rec 5/2 1/46

Numerals.

Depth 20.42  
1/2 Breadth 15.50  
1/2 Girth 31.46  
67.38 = N  
x 176.75  
33690  
47166  
40428  
47166  
6738  
119094.150 = N  
+ 1/5 493.96  
127038.150 = B.N.

Proportions

Breadths = 5.70  
Depths = 8.65

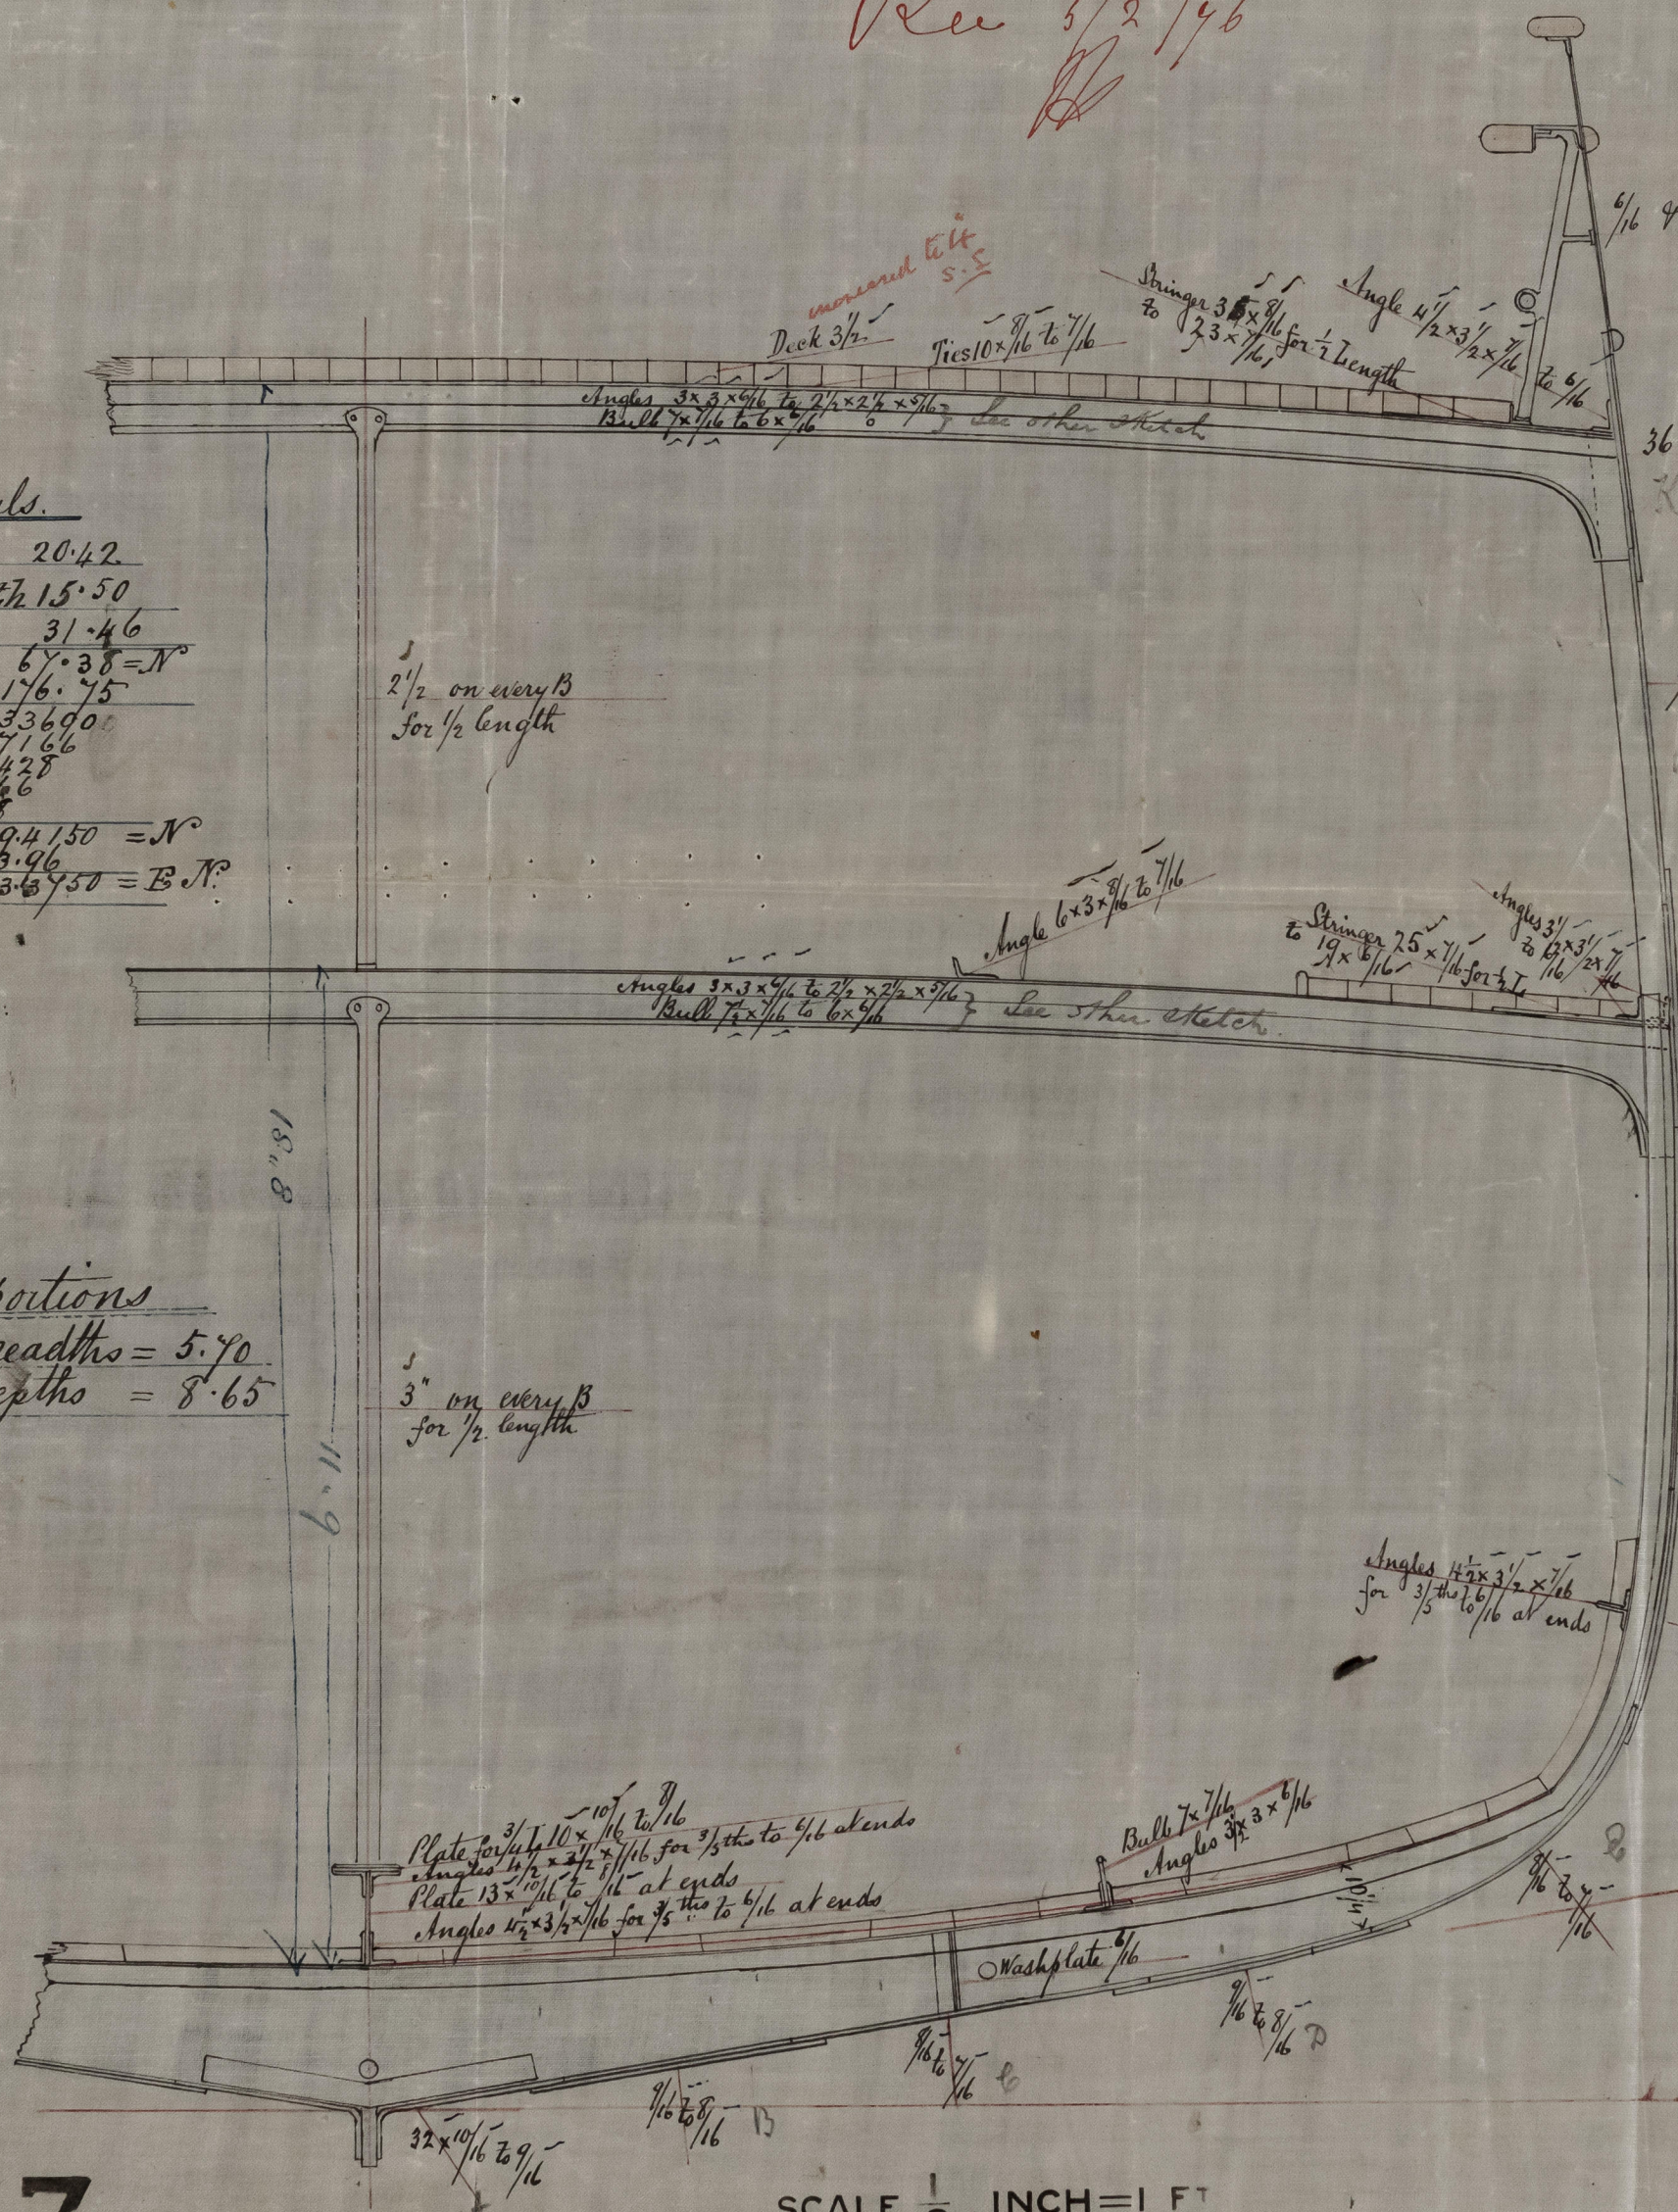

Keel 8 x 2 3/8  
Stem & Stern Post 7 x 2 3/8  
Rudder 4 1/2 at head to 2 3/4 at keel  
Frames 4 x 3 x 1/16 for 3/5 to 1/6 at ends (22" apart)  
Reverse Frames 3 x 3 x 1/16 to 1/6 at ends  
Floors 20 1/2 x 1/16 for 1/2 length 1/16 at ends  
Bulkhead 6 1/2 x 1/16  
Bars 3 x 3 x 1/16  
Ceiling 2 1/2" thick.

The Butts of the Upper Dk Stringer Plate Sheer  
Shake & of two strakes of Plating at the Bilge  
to be one sixteenth of an inch thicker than  
the plates they connect, treble rivetted for one  
half the vessels length amidship  
3/4 in. Rivets throughout, except in the Butts  
of Sheer & Carboard strakes  
Standings double rivetted throughout

N<sup>o</sup> 8 7

SCALE 1/2 INCH = 1 FT

IRONS 18-0036

DOBIE & CO  
GLASGOW

JAN 22<sup>nd</sup> 1876

Recd Glasgow 2/1/76