

8/2/76


No 87  
Sailing Barque  
to Class 100A

Glasgow } No 4306  
Report }

Length  $176.75 \times 31.00 \times 20.42$

Numerals  $\frac{67}{11909}$


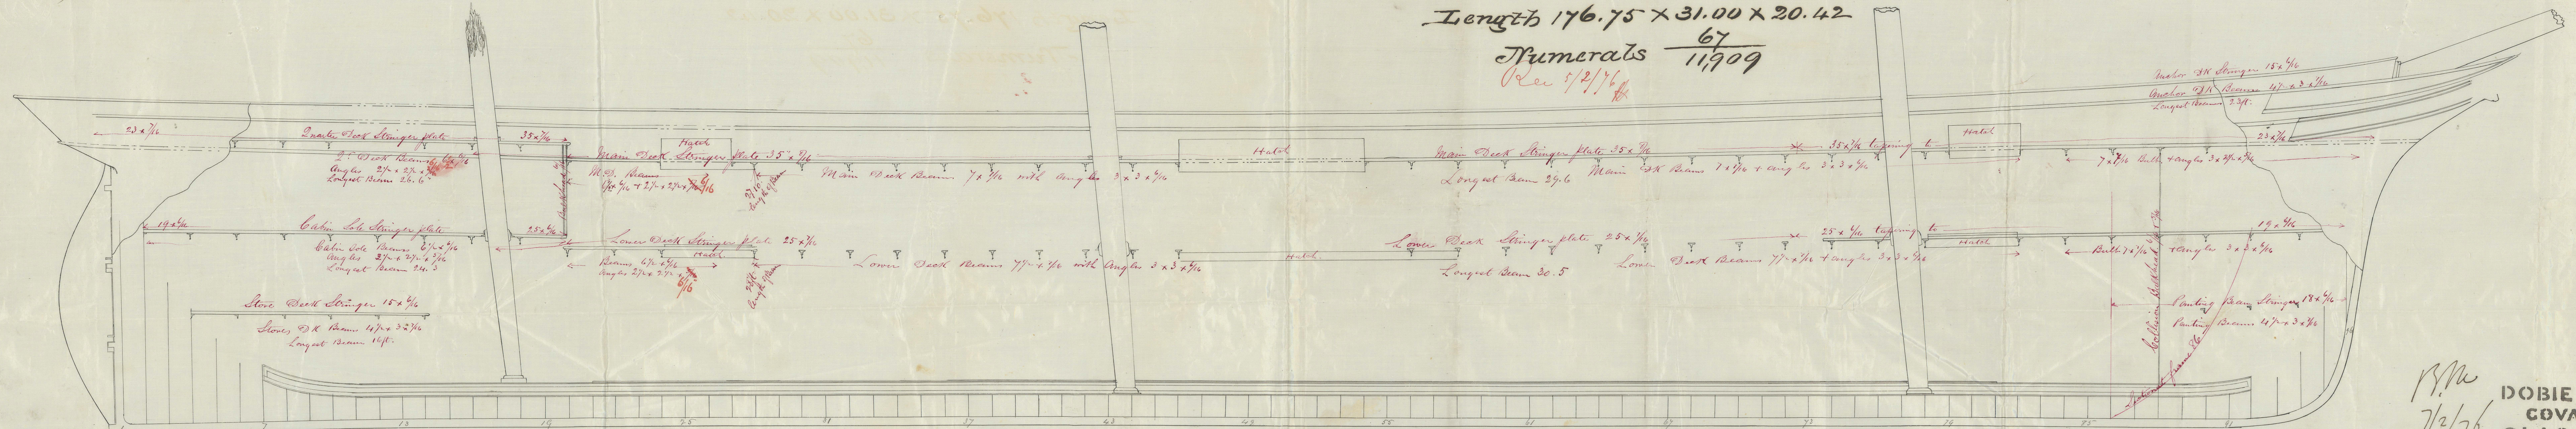

SCALE  $\frac{1}{4}$  INCH = 1 F

1876  
 DOBIE & CO  
 COVAN.  
 GLASGOW  
 JAN 187