"William" — Report — No 1222 o

No 337

11/5/76

Scale of 1/2 Inch to Foot.

1st May 1874.

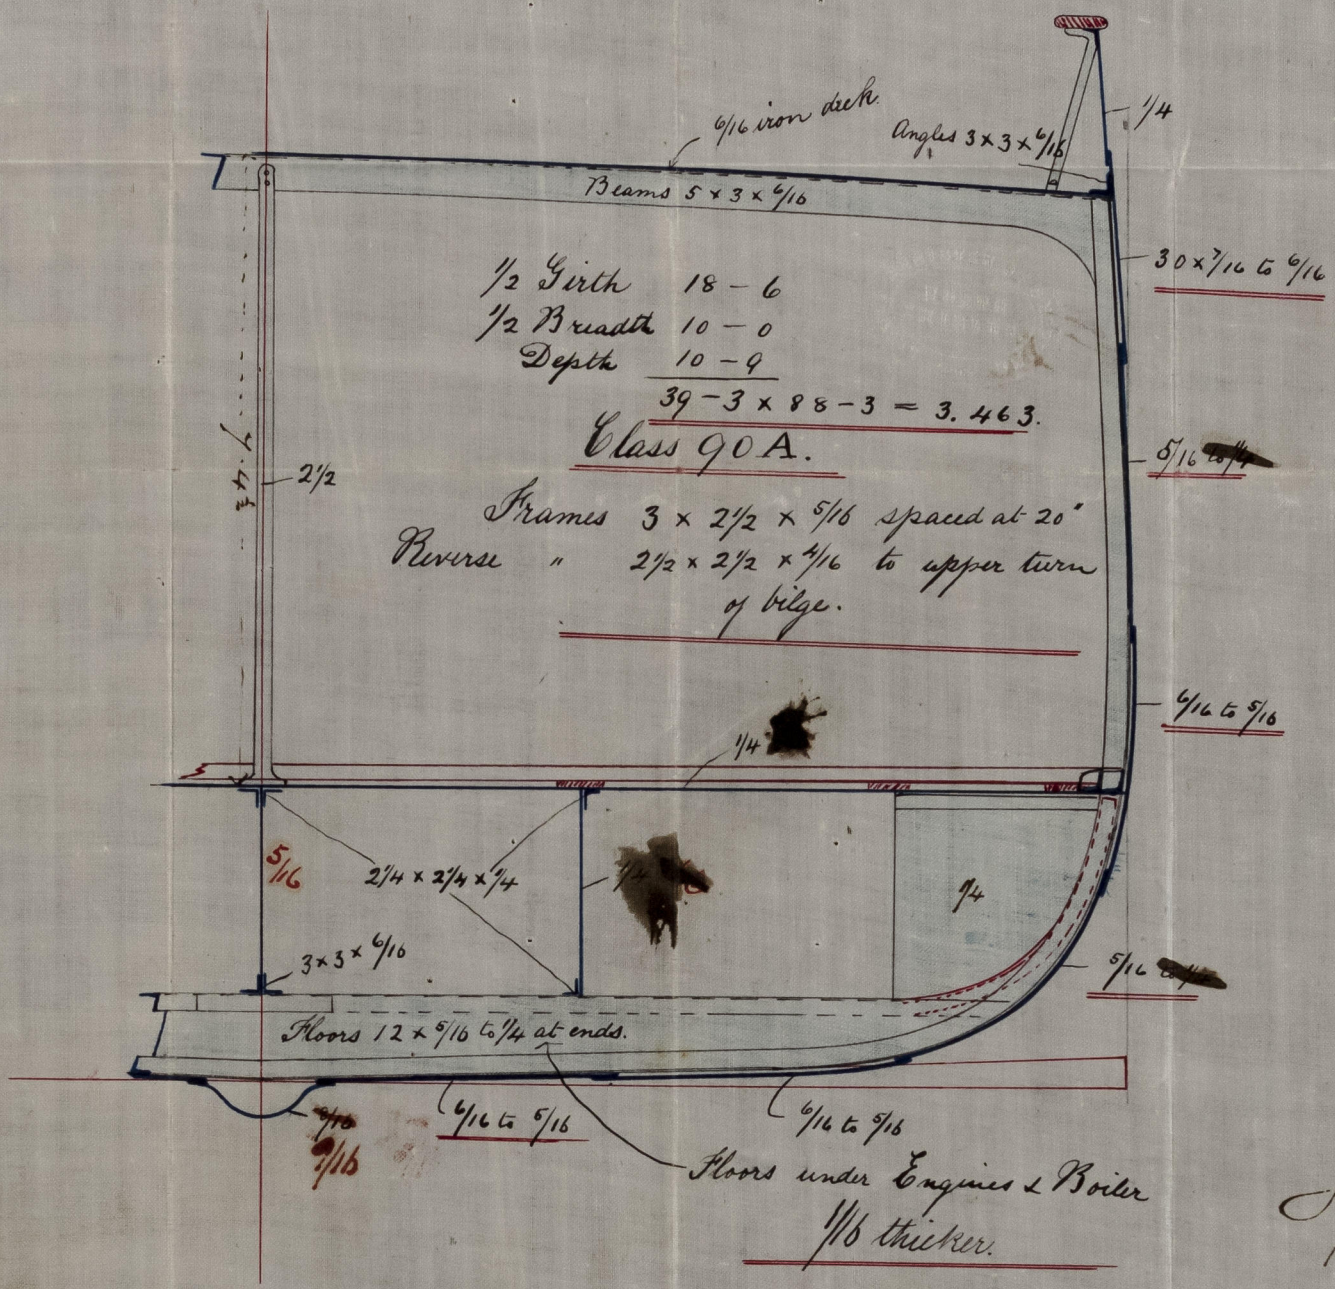

J.T. 10/5/76

W.D. 10/5/76

3/5/76

C. MITCHELL & Co

SHIPBUILDERS.

NEWCASTLE ON TYNE.

© 2021 Lloyd's Register Foundation
I RONS18-0038