
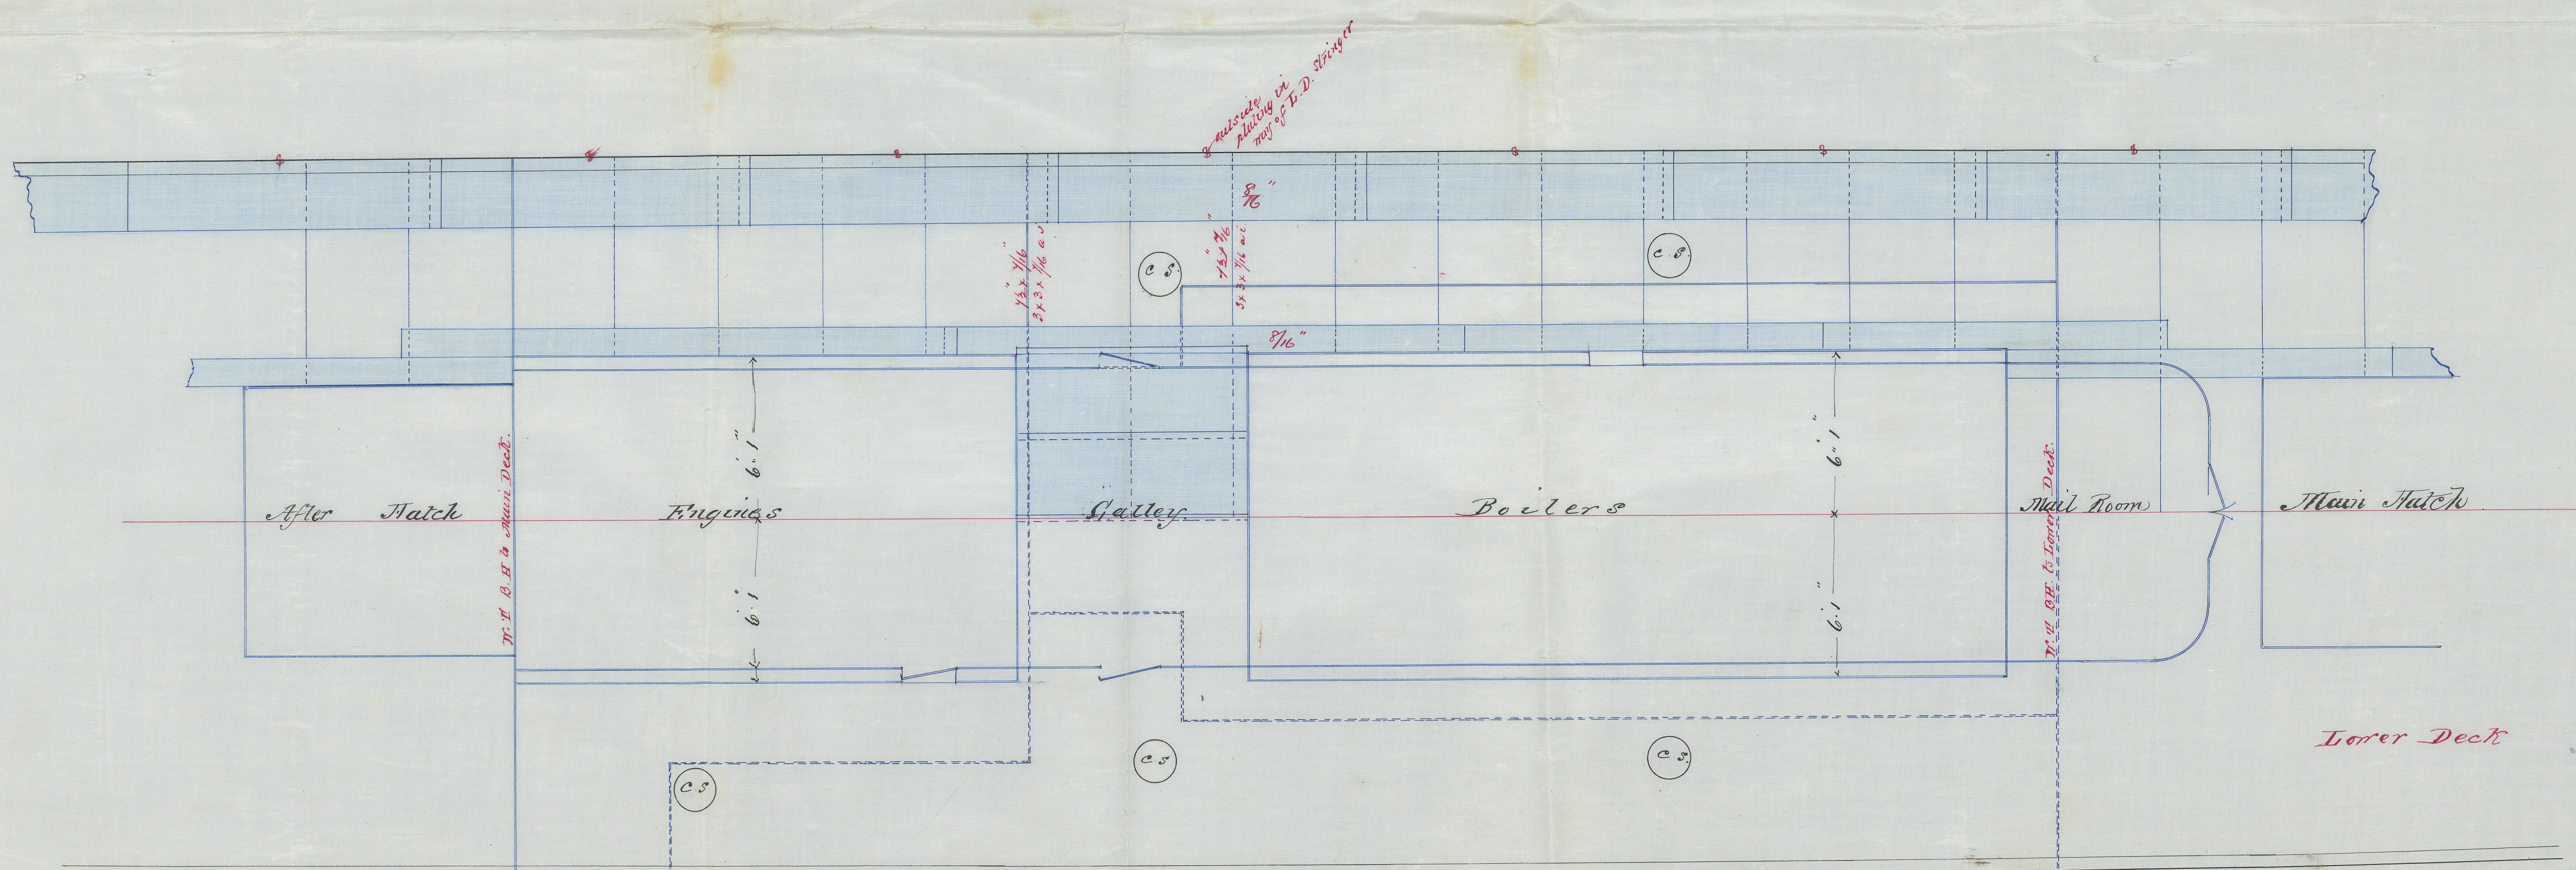
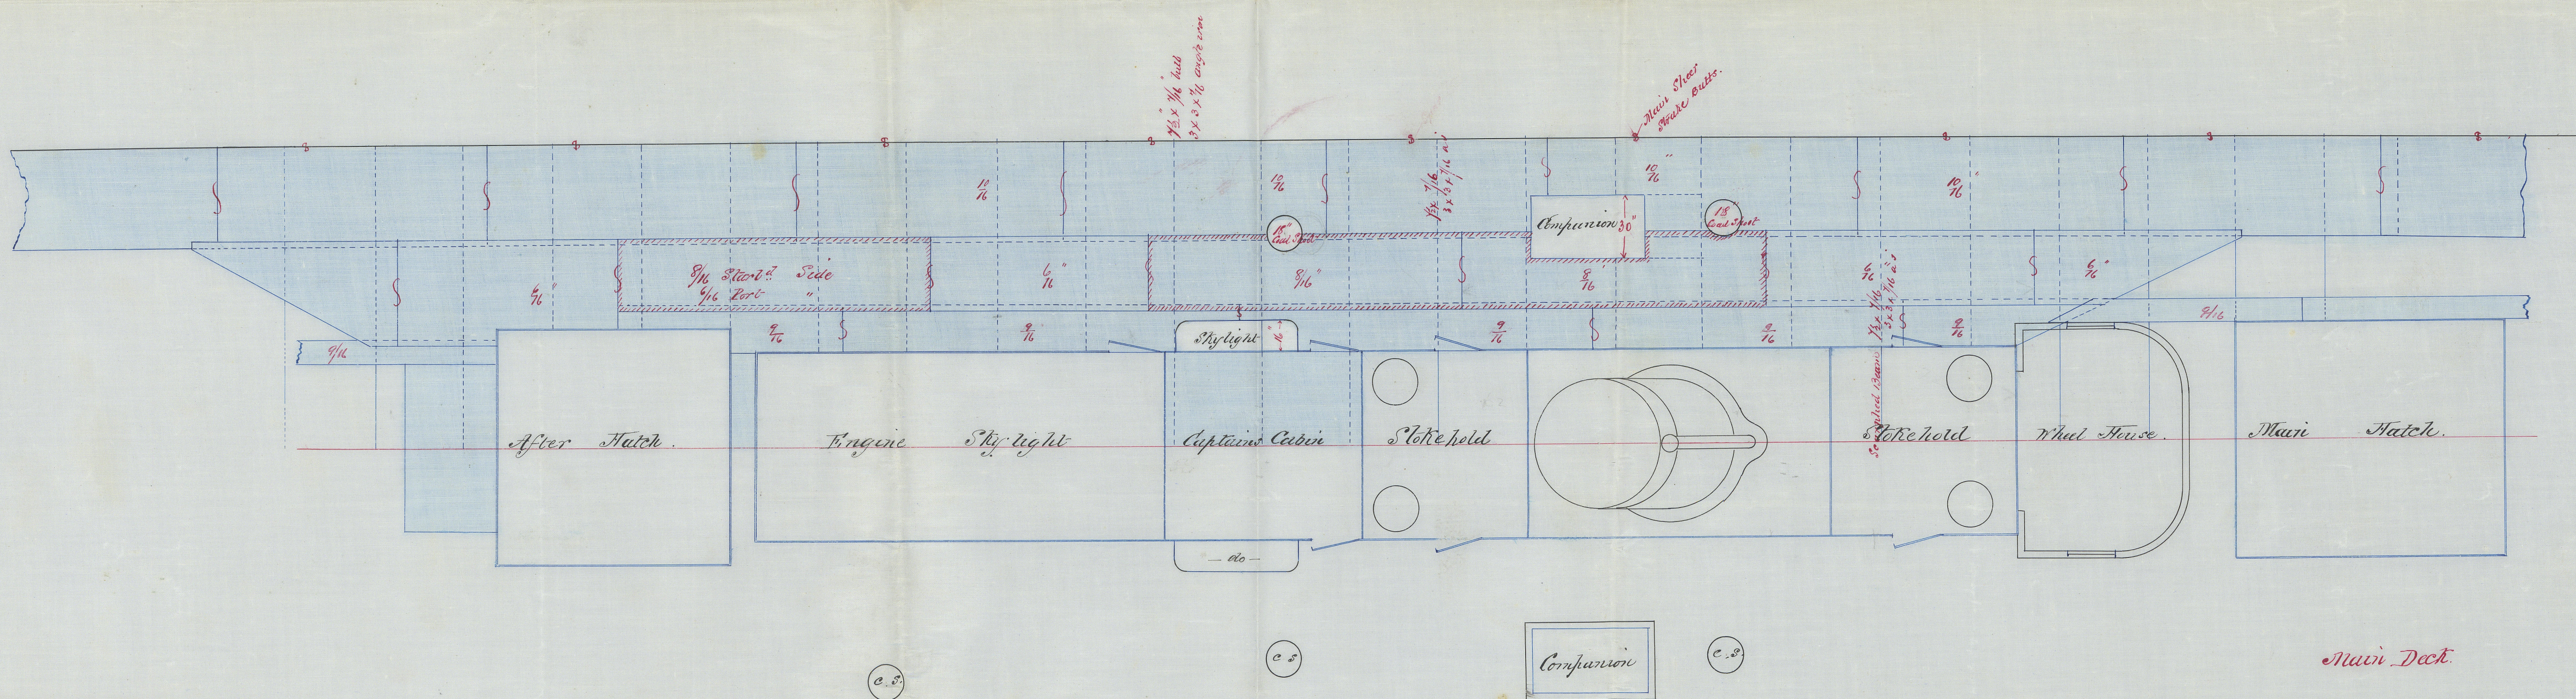
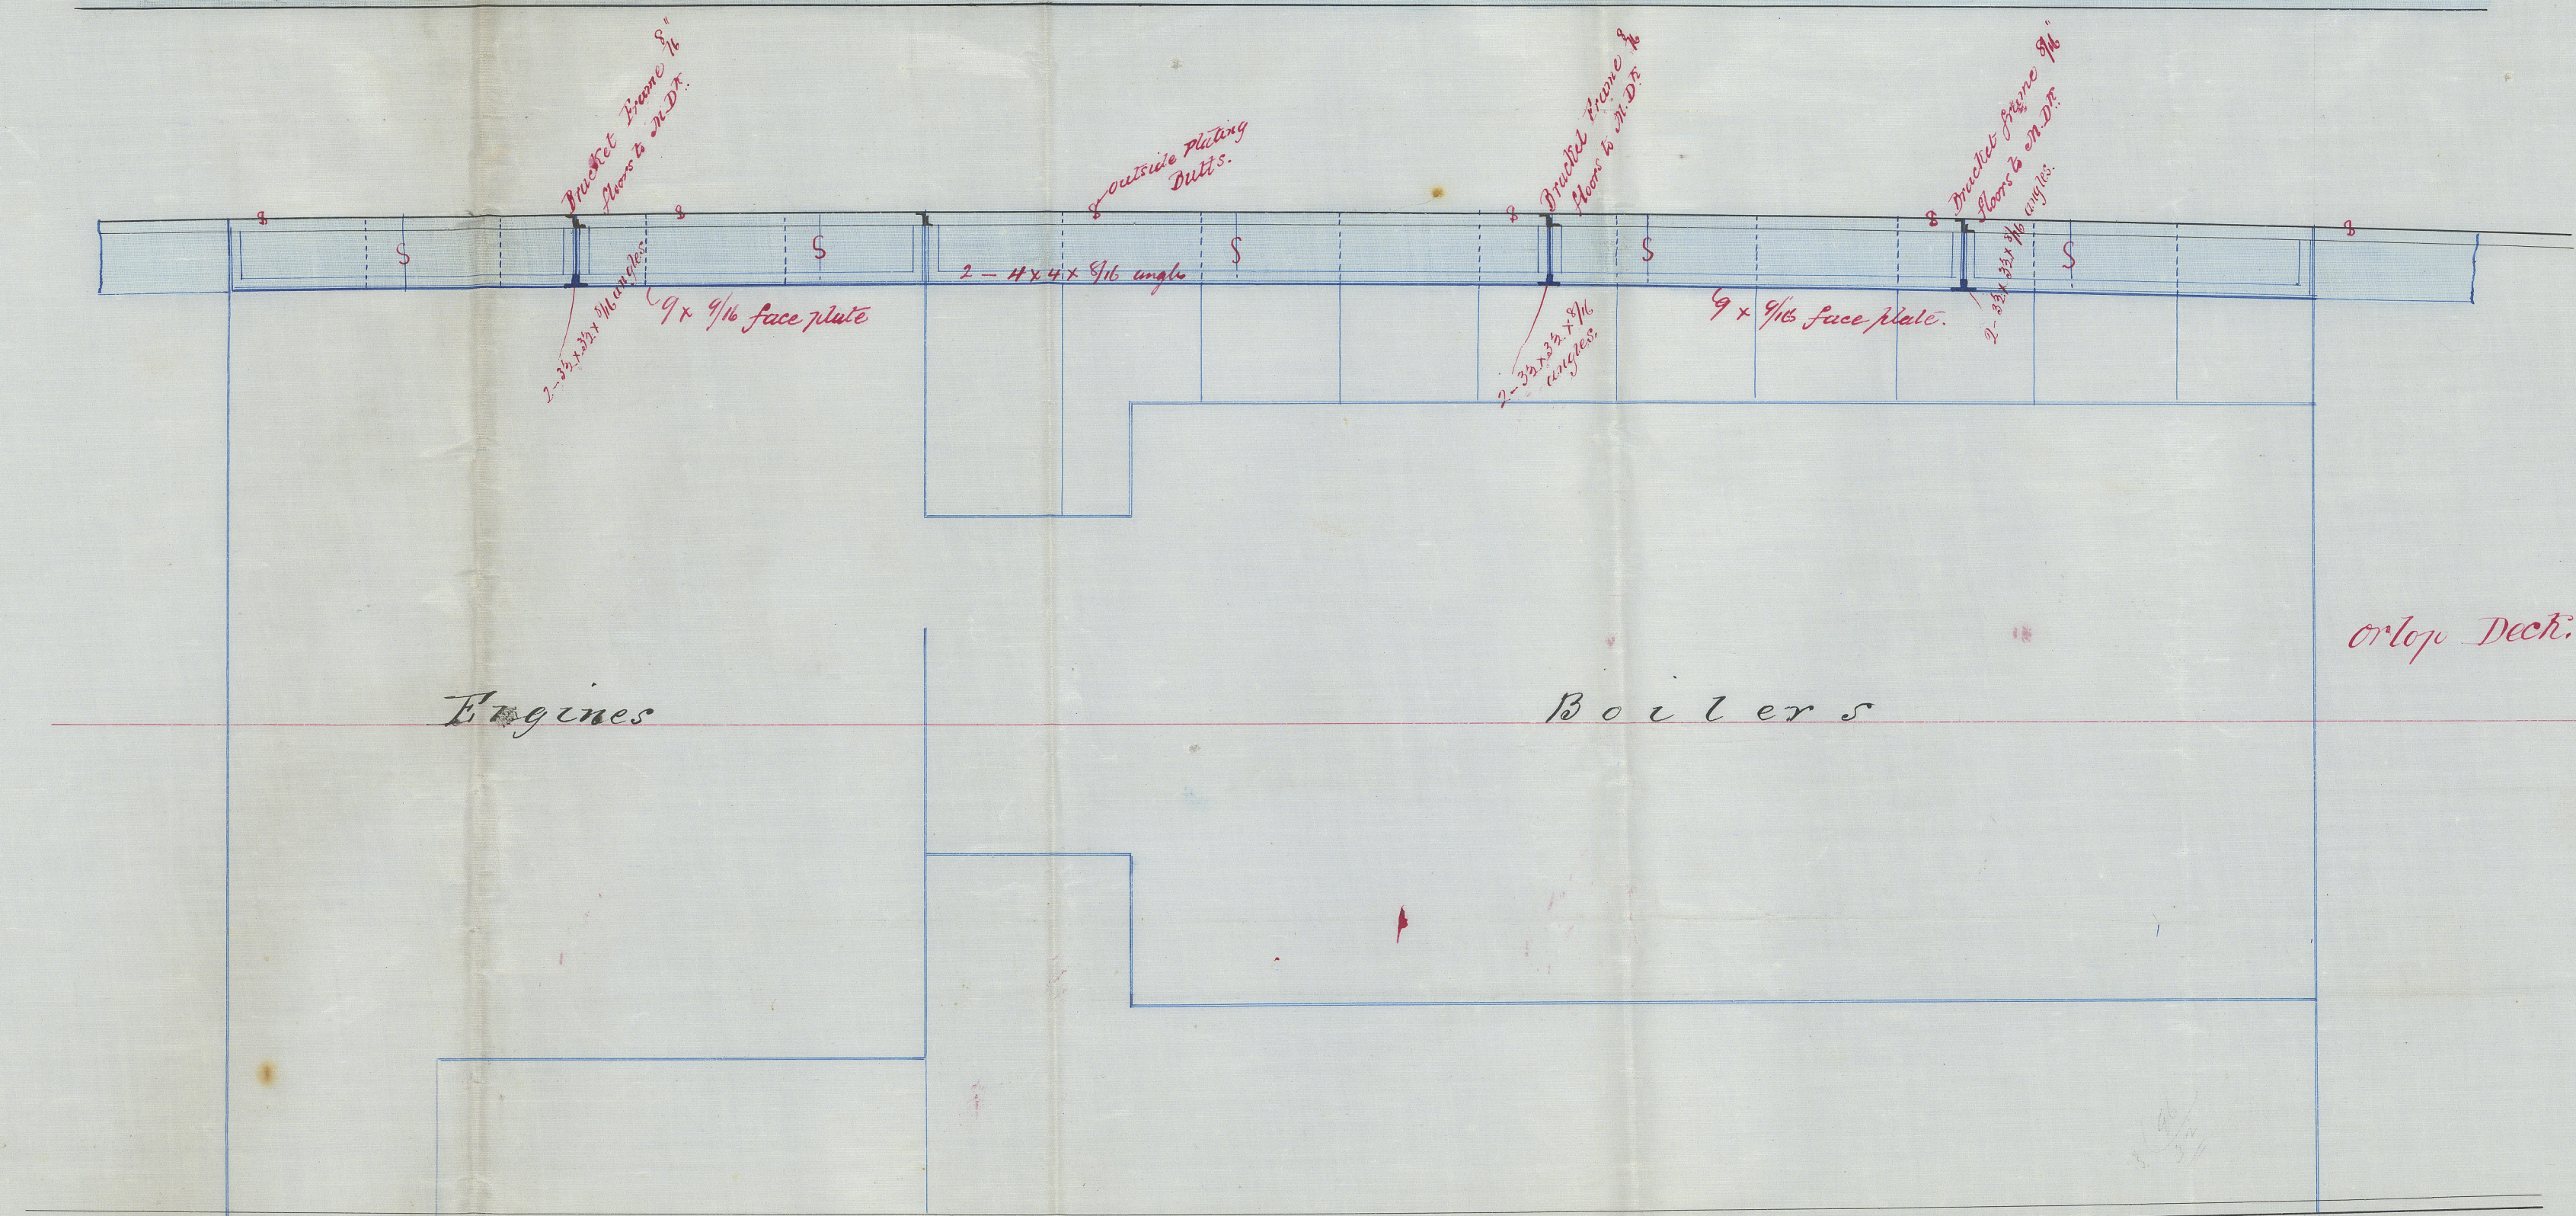
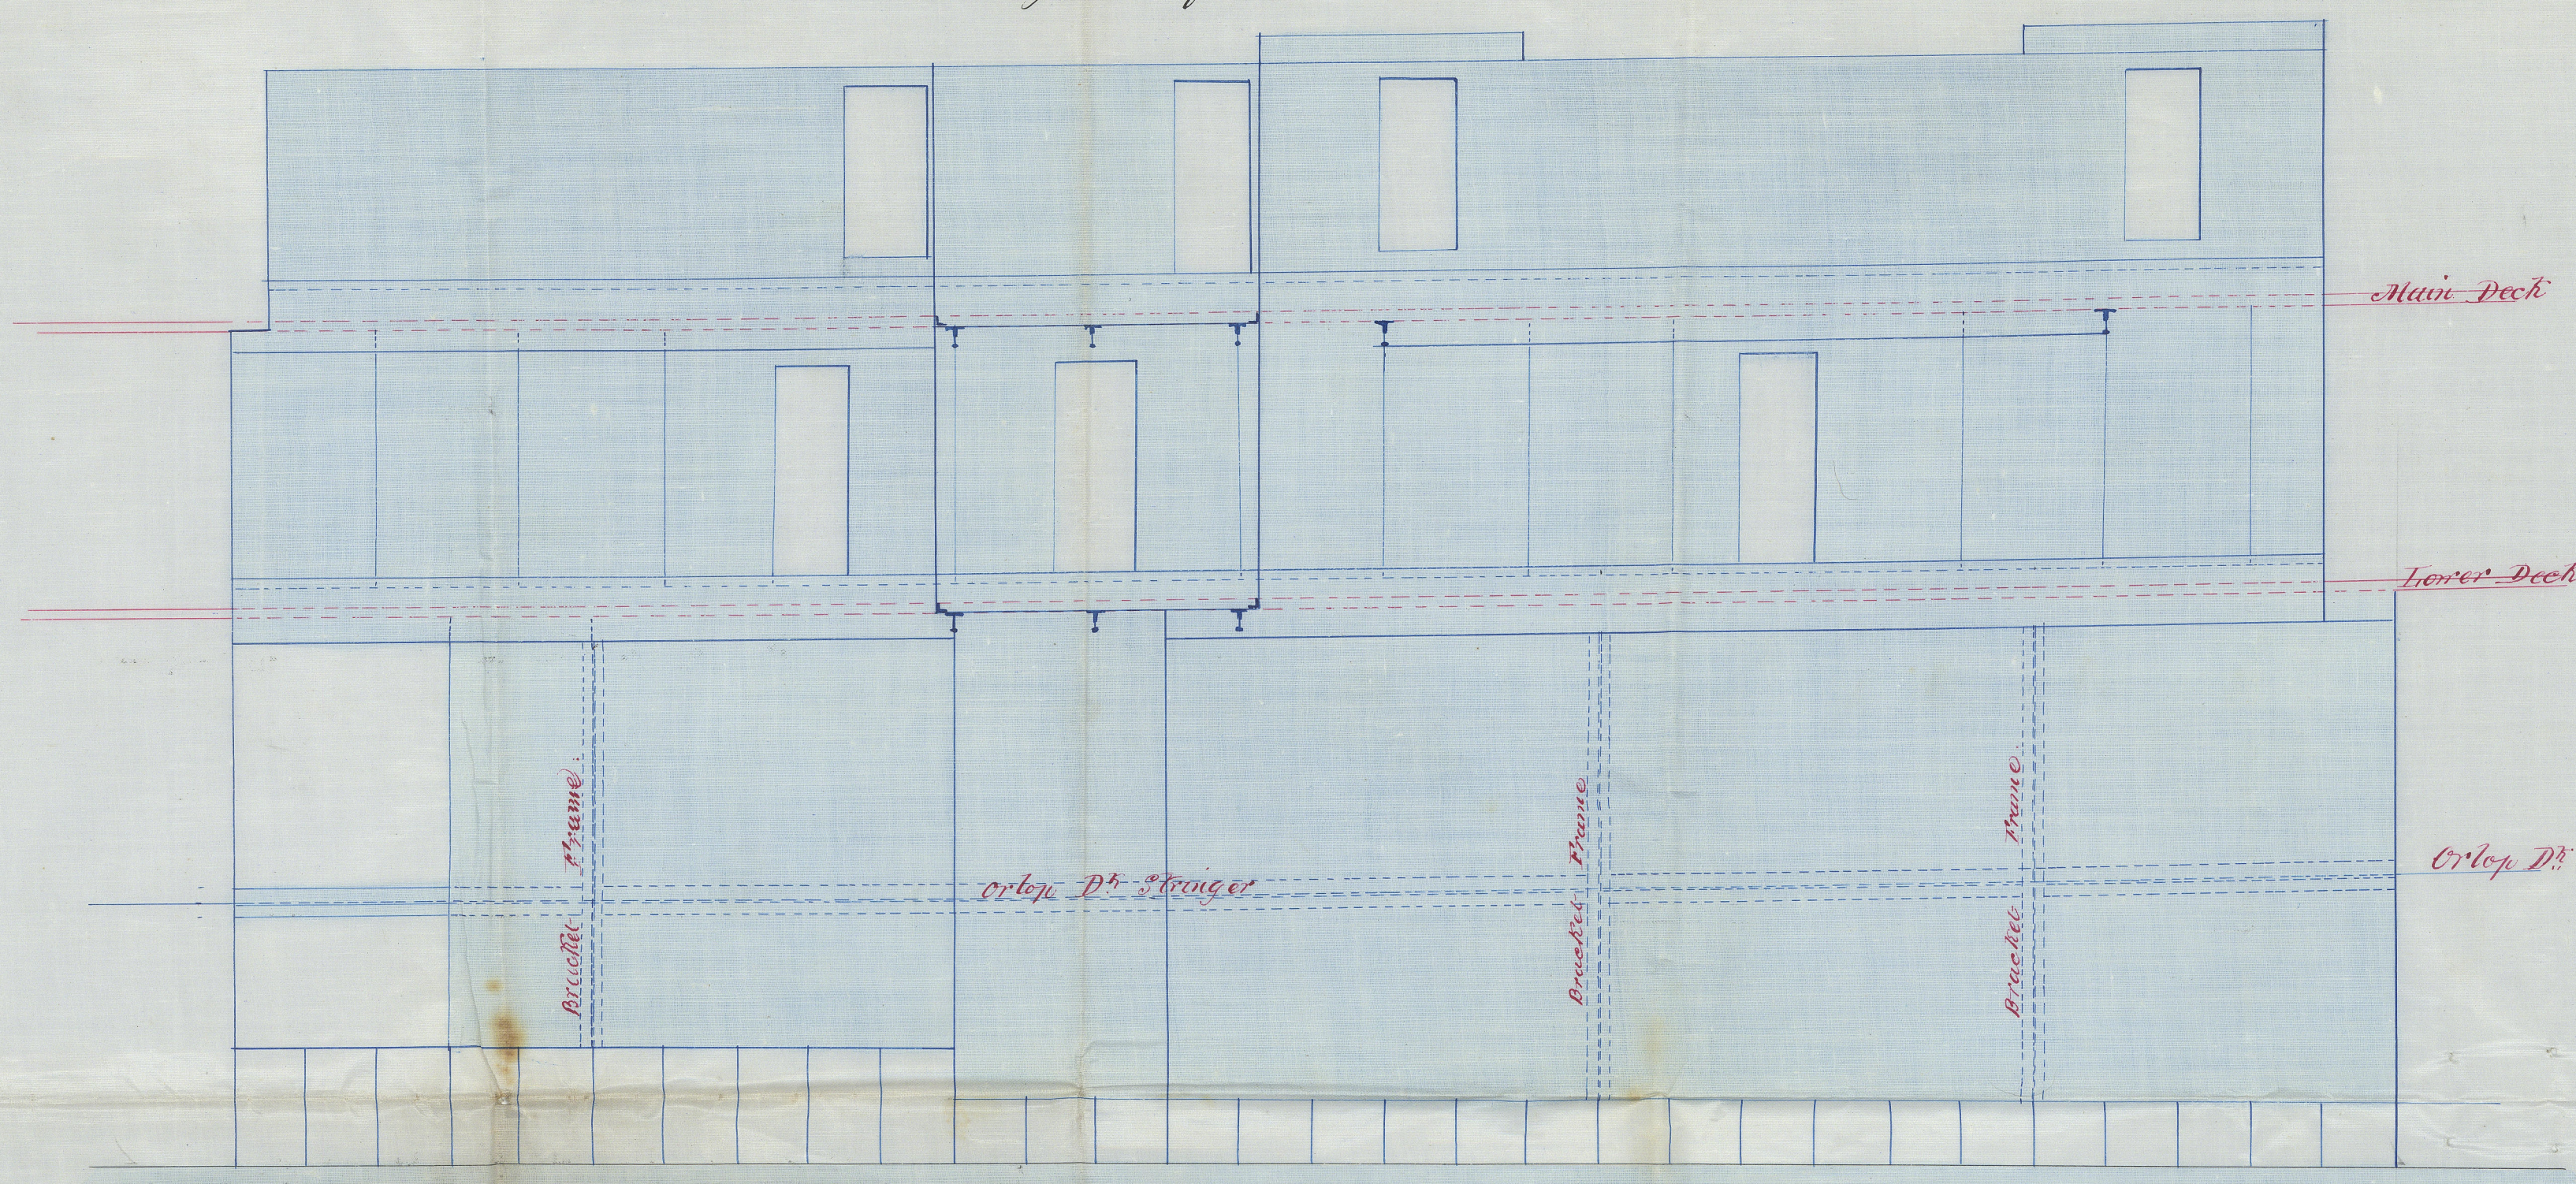


Sketch of Proposed Strengthening
in Way of Engine & Boiler Hatches.

No 191

Scale 1/4" = 1' on feet.

Rotorua
Classmate No 1-314

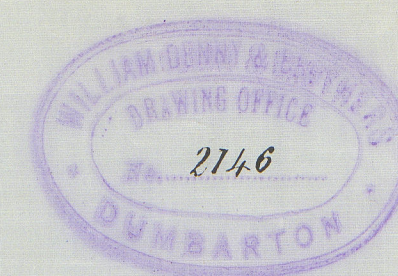

© 2021
Lloyd's Register
Foundation