


— N° 16055 —

S.S. "Winstan"
Report No. 3703

Length Overall	Buildings	Length Cys
Length Deck Port	243.9	Length 242.5
Breadth At Berme	32.0	Breadth 15.11
Breadth Moulded	31.10	Girth 32.3
Depth of Hold	18.6	Depth 24.3
Clays 100A1 at Lloyd's		
11 & under 12. Depths		Feet for Thames 68.5
7 & " 8. Breadths		" " Plating 16586.14
		Equipment 18245.0

Rec 8/3/96
JH

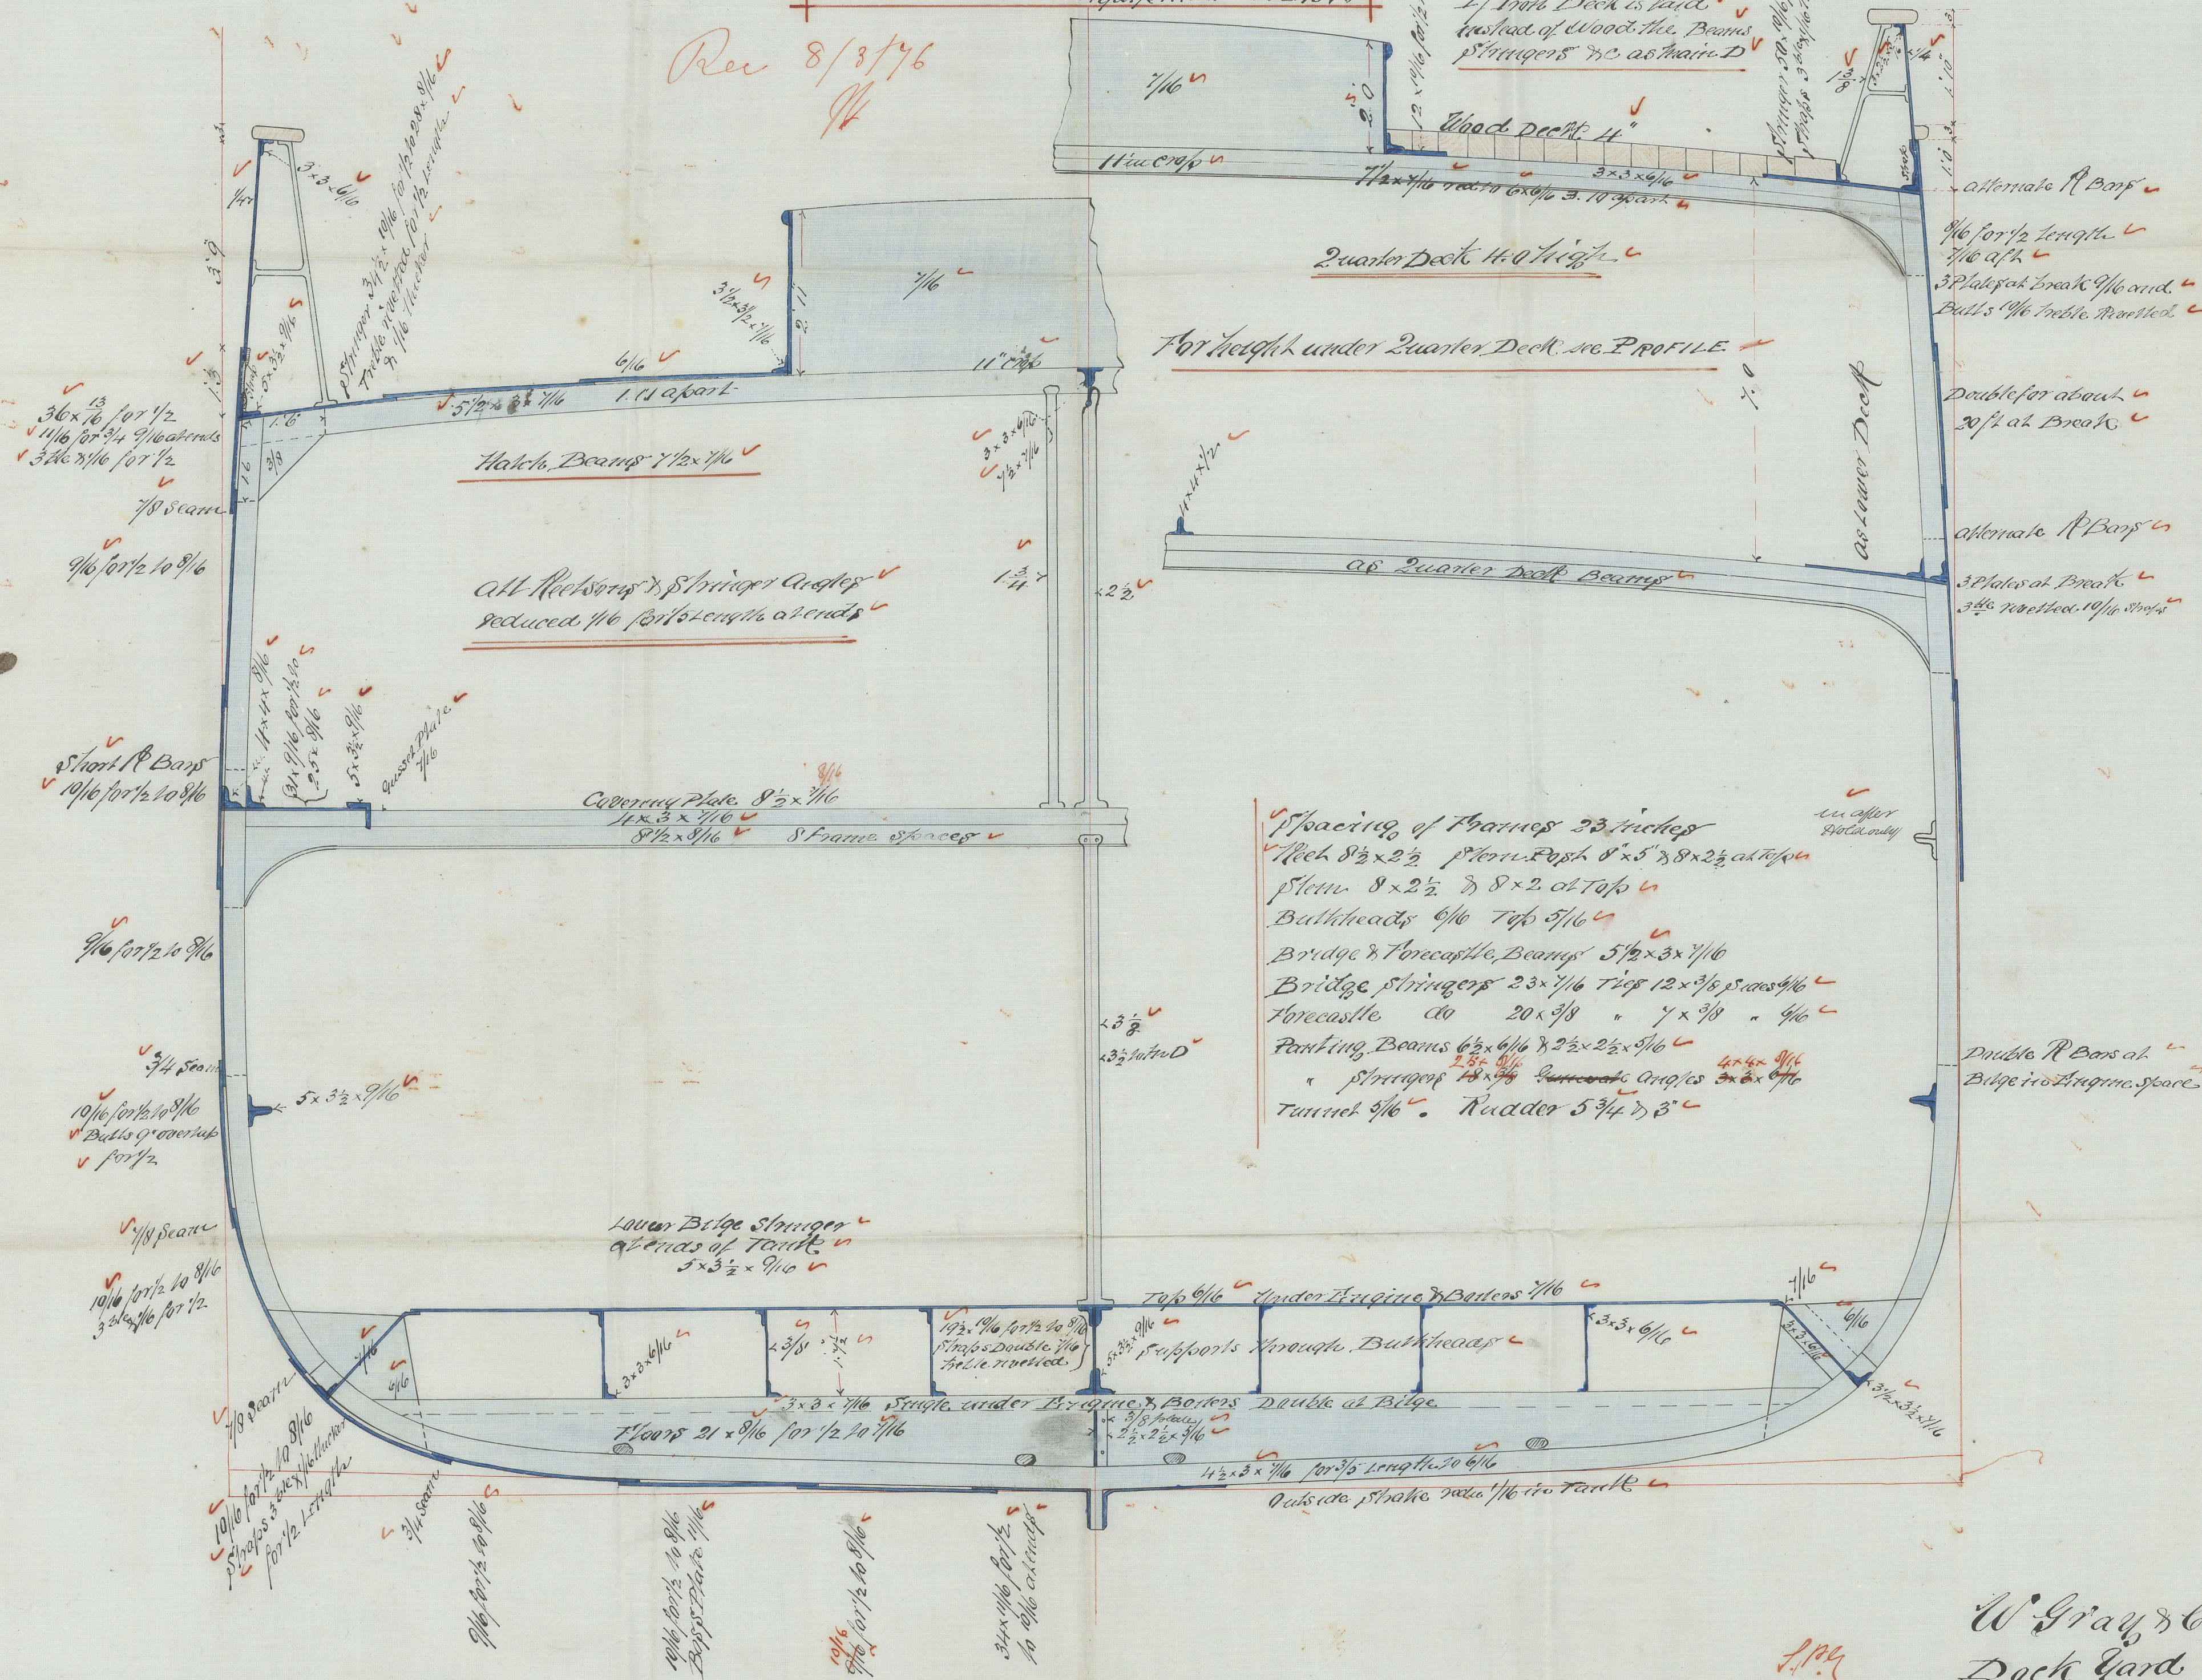

Sheet 2 to frames with 7/8 rivets for 1/2 length ✓
all seams & Butts 3/4 rivets except ✓
Gorboard Sheer & F. Strake ✓

W. Gray & Co
Dock Yard
West Hartlepool
Feb 26/46

29/2/70
 8/11/76