

# MIDSHIP SECTION OF SS

## Nº 269

*Glasgow Report No 4333*

*Rev 20/3/76*

Dimensions by Lloyds.

SCALE 1/2 INCH TO ONE FOOT

Length 288.58

Breadth 33.00

Depth 24.83

Proportions

Beams 8.74

Depths to Upper 10.73

Depths to Main 14.70

Half Beam 16.50

" Girth 38.91

Depth 26.87

off 82.28

off 45.28

$288.58 \times 45.28 = 21724.30 = \text{Nominal}$

$288.58 \times 82.28 = 23744.36 = \text{Equipment}$

Equipment.

2 Power Anchors Coll. Weight 85 1/2 cwt ex Stock

1 Stream " With Stock 12 "

1 Hedge " " 6 "


1 Do " " 3 "

270 Fathoms 1 1/2" Stud Chain Cable

90 " 1 1/2" Stream Chain

90 " 1 1/2" Hawser

90 " 1 1/2" Warp.

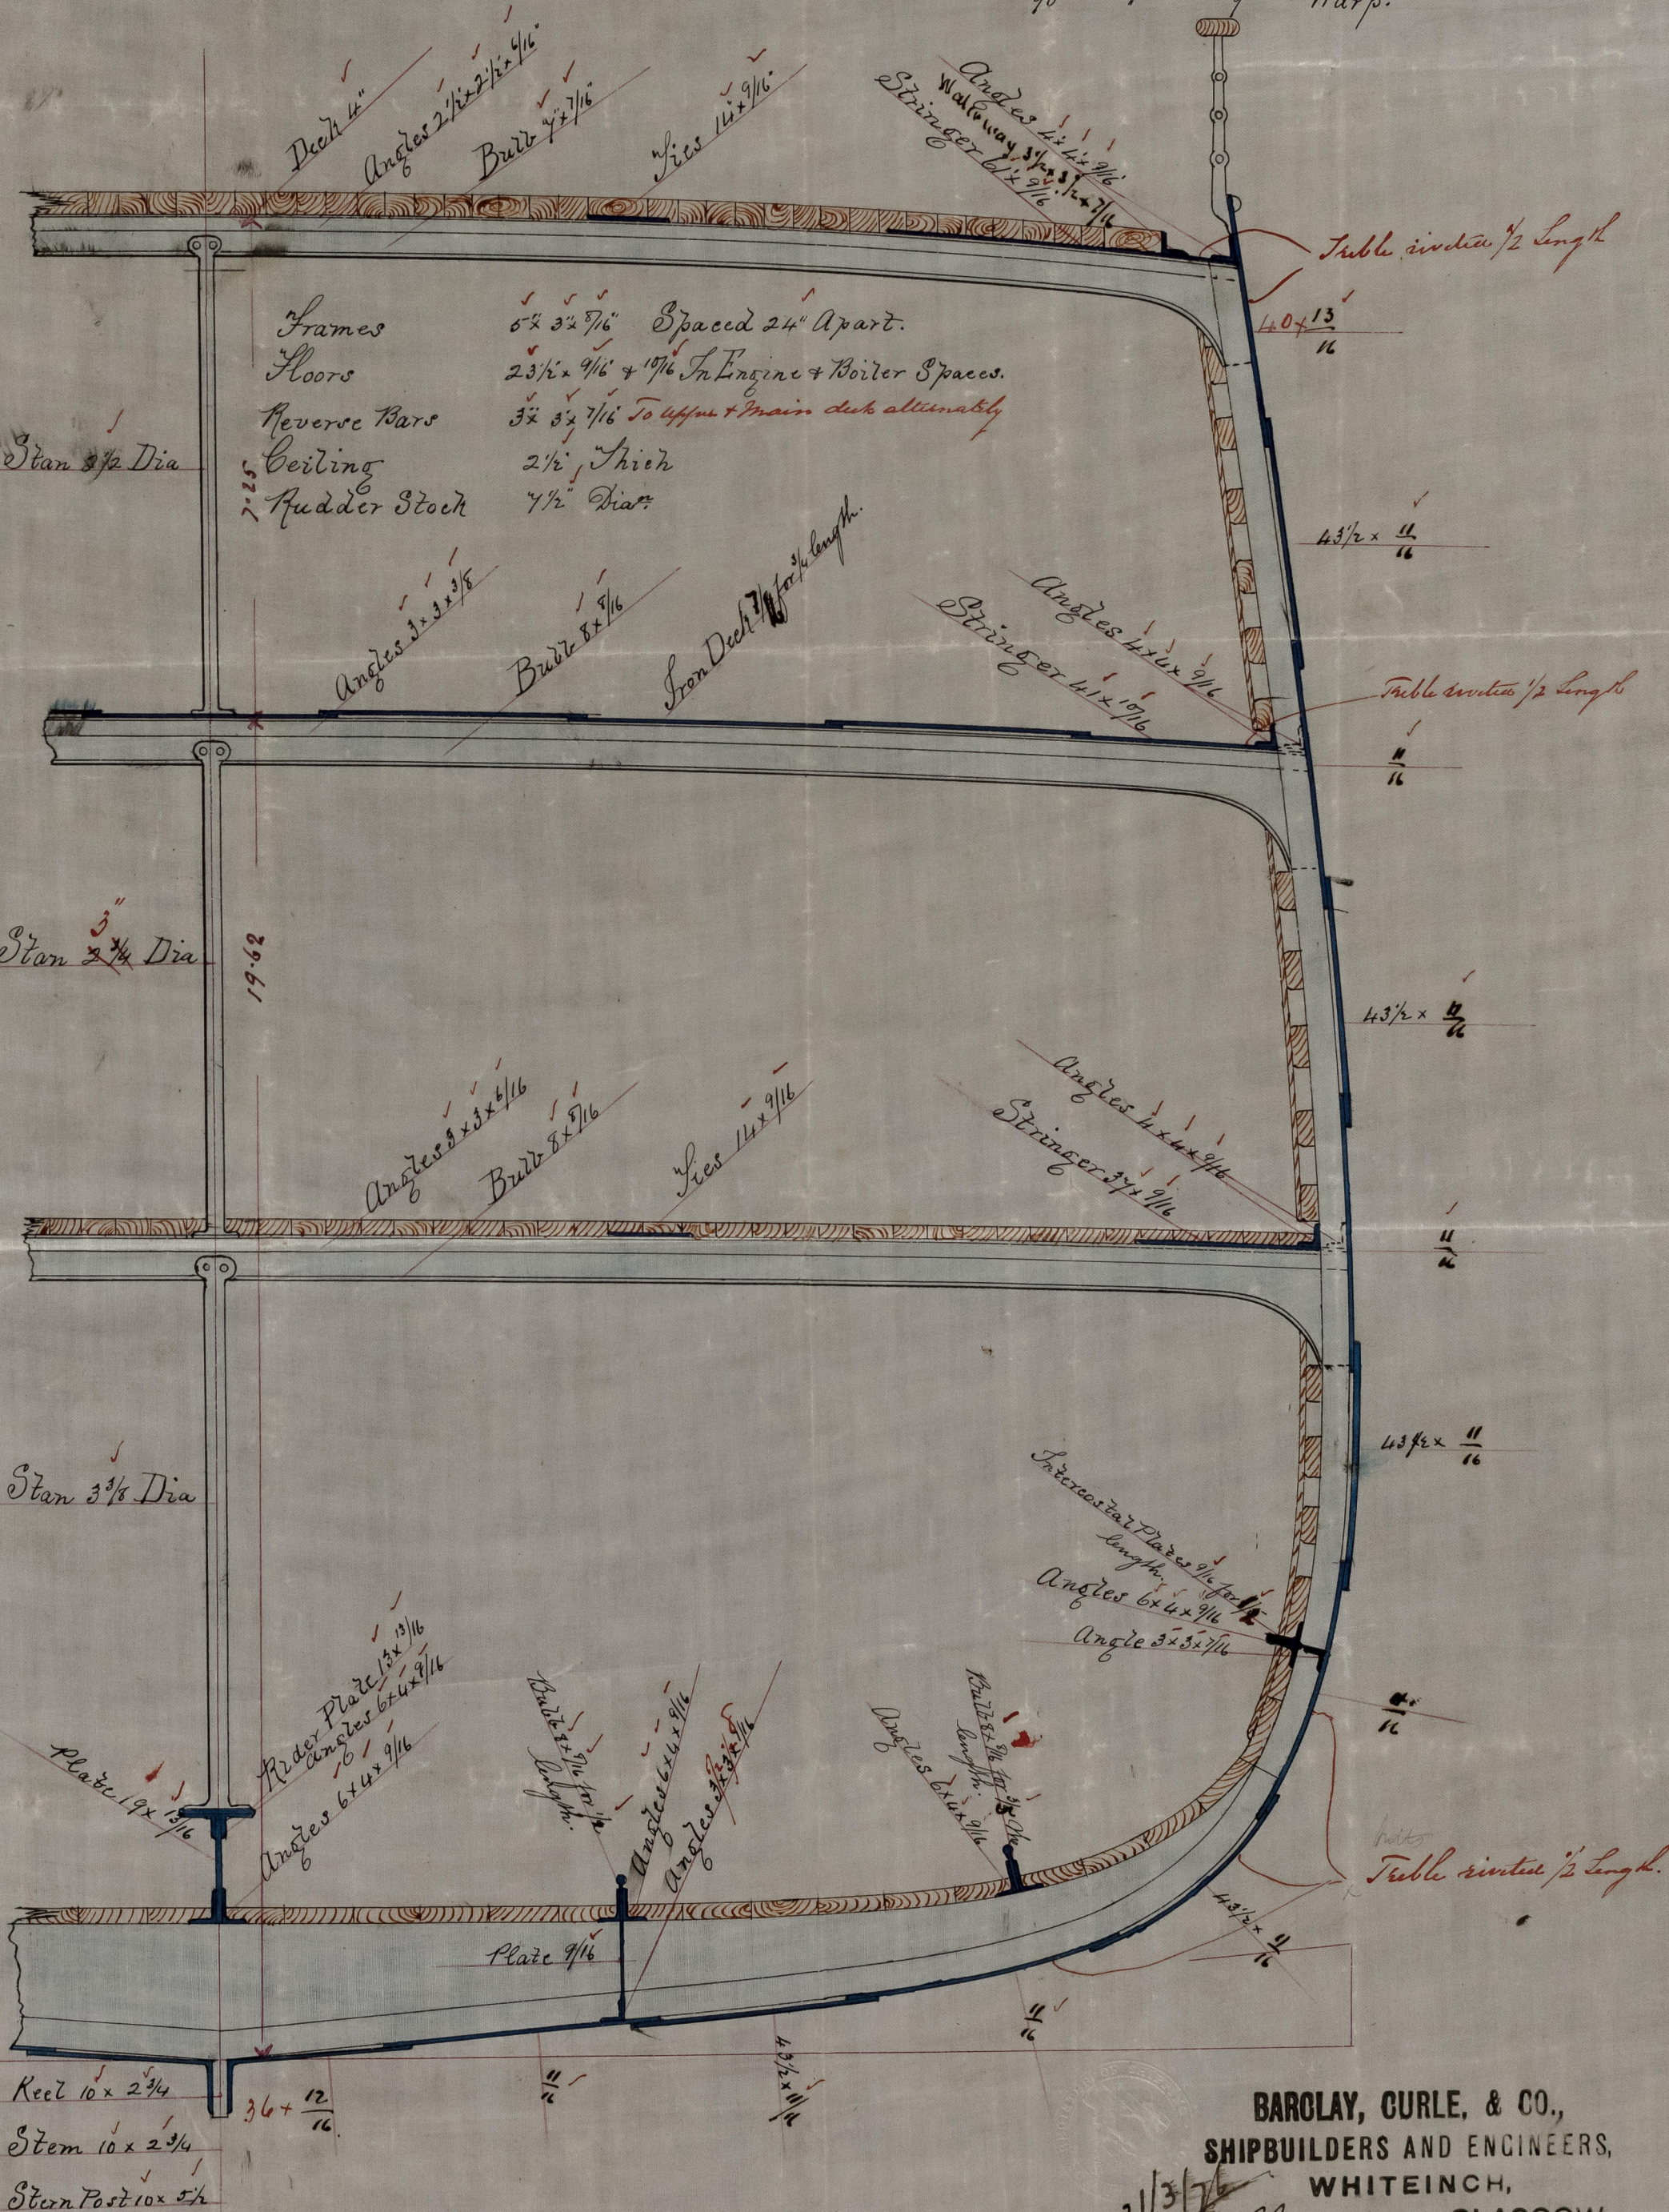

BARCLAY, CURLE, & CO.,  
SHIPBUILDERS AND ENGINEERS,  
WHITEINCH,  
GLASGOW.

*21/3/76*

*20/3/76*

Lloyds Register  
Foundation

IRONS18-0097