


ELEVATION PLAN SHOWING BULKHEADS &c

S.S. N^o 269

SCALE $\frac{1}{16}$ INCH = ONE FOOT

Per 20/1/76
H

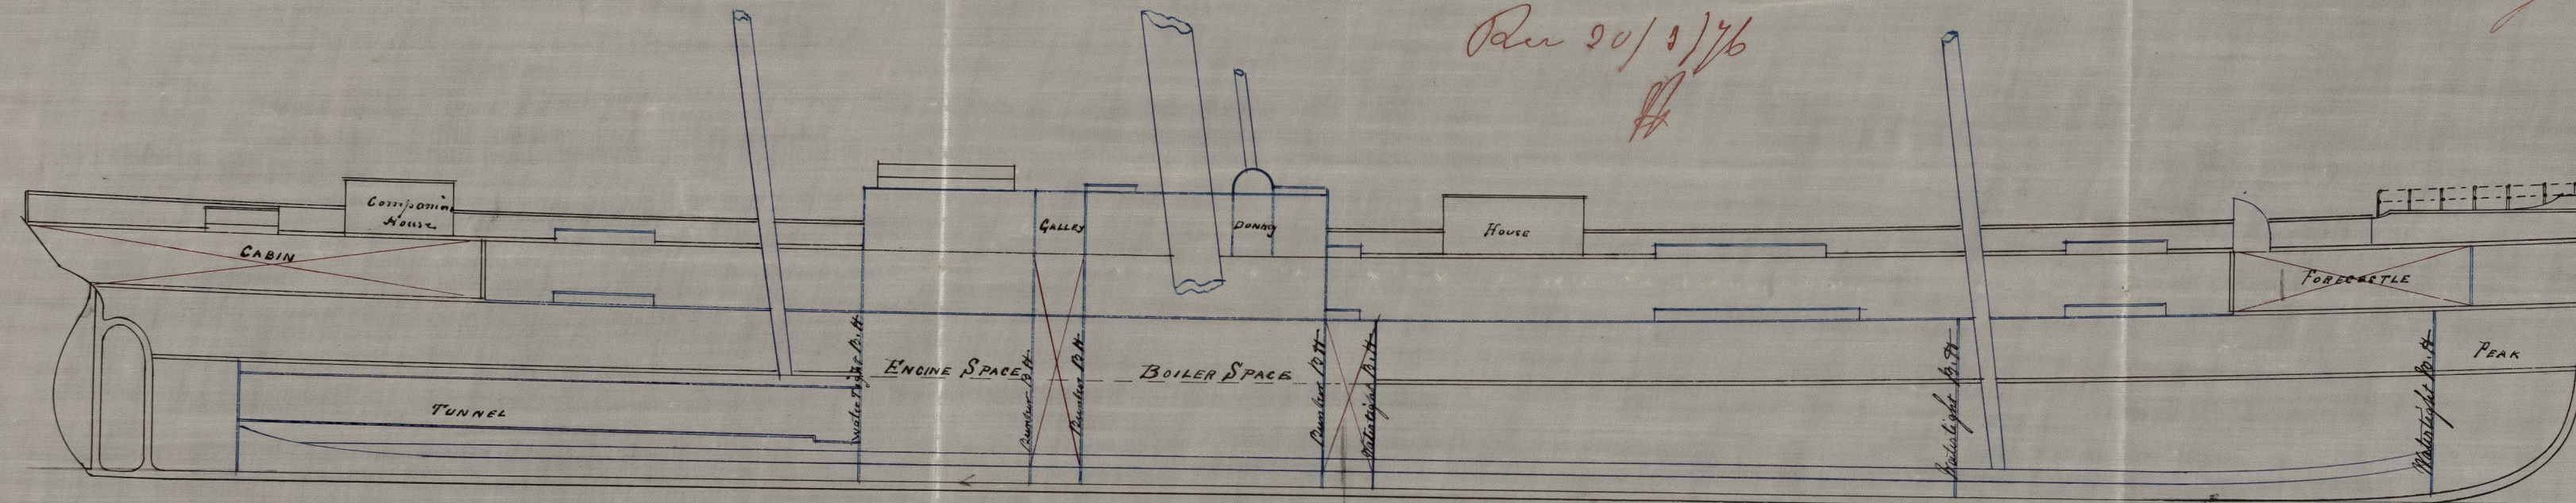

S. S. Benarty
Glasgow Report N^o 4333.

BARCLAY, CURLE, & CO.,
SHIPBUILDERS AND ENGINEERS
WHITEINCH,
GLASGOW.

21/3/76
Lloyd's Register
Foundation

IRONS18-0098