

Rec'd 23/9/76

Para. Report No 12371

No 169

MIDSHIP SECTION


for an Iron Screw Steamer

Length between perp. - 280' 0" 284'
Beam Moulded - 33' 6" 33' 6"
Depth in Hold - 24' 0" 24' 4"

For 1000 (Three Decks) at Lloyd's

Scale 1/2" = 1' 0" foot

Rev 14/7/75 & 30/8/76

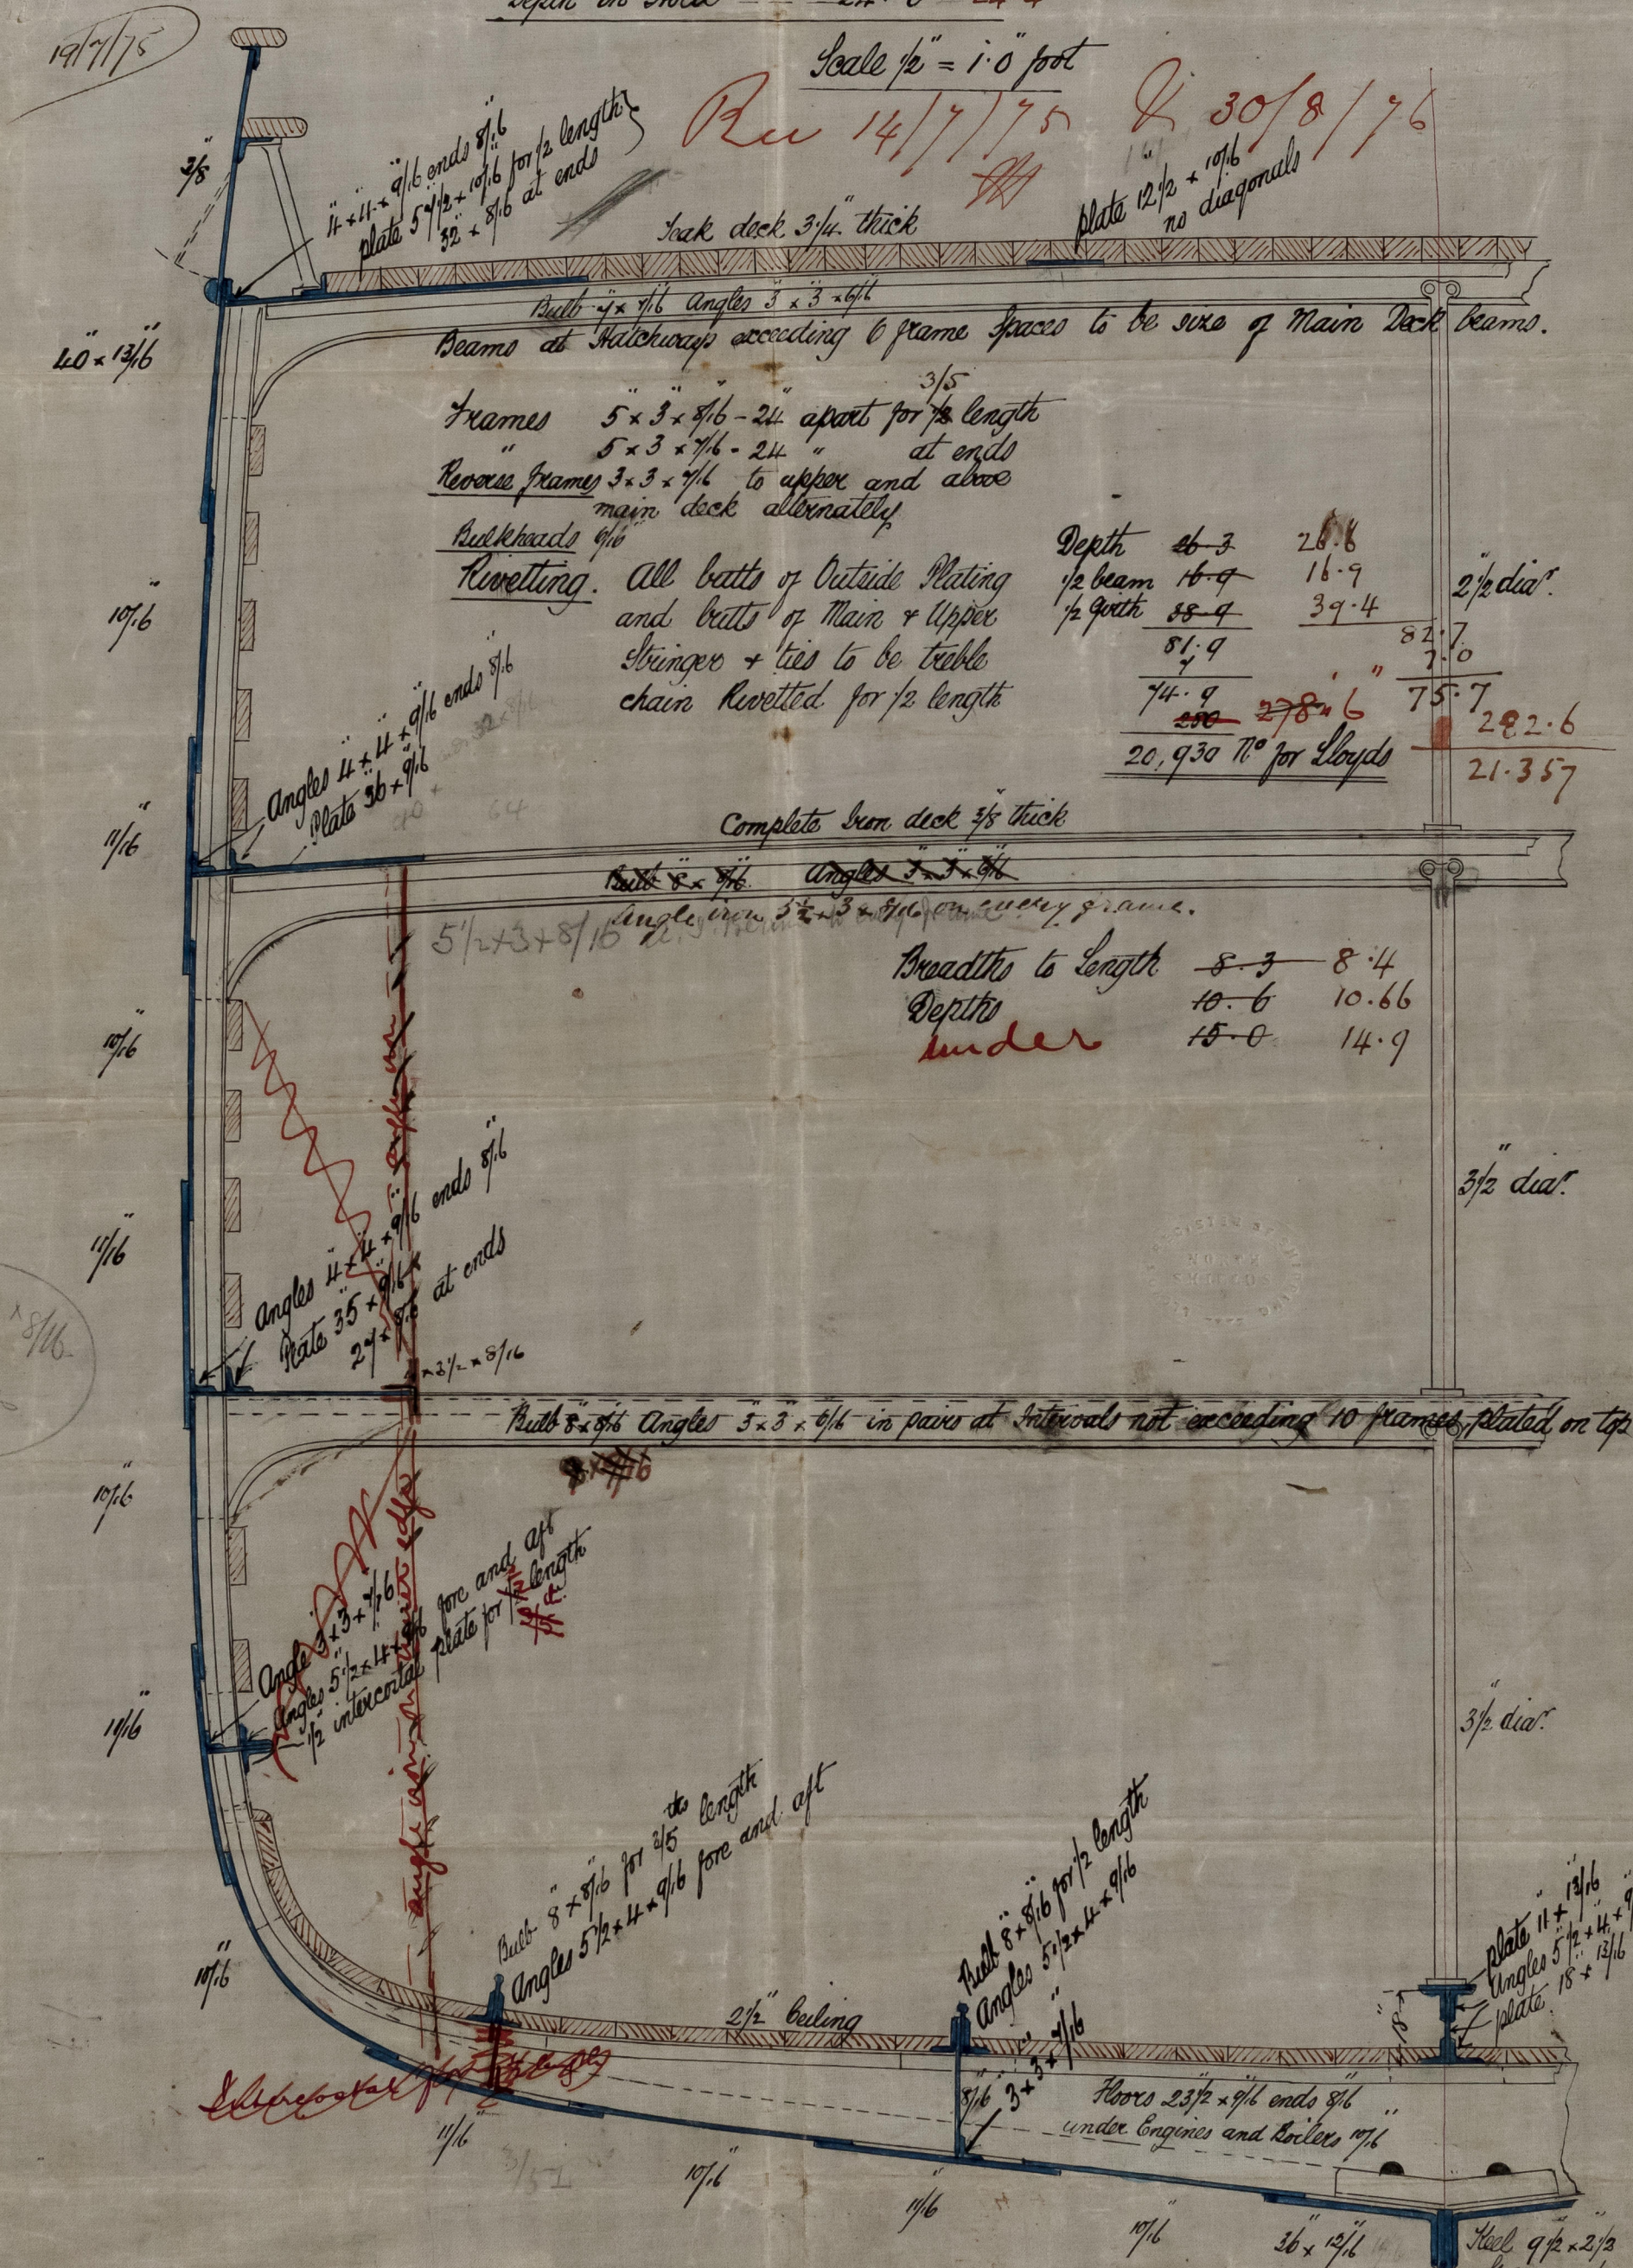

Depth	46' 3"	26' 8"
1/2 beam	16' 9"	16' 9"
1/2 girth	88' 4"	39' 4"
	81' 9"	82' 7"
	74' 9"	75' 7"
	278' 6"	282' 6"
	20,930 ft ² for Lloyd's	21,357

Breadths to Length	8' 3"	8' 4"
Depth	10' 6"	10' 66"
under	15' 0"	14' 9"

4 1/2 x 4 1/8 1/16
12 inches
1 1/16

Lloyd's Register
Foundation